

## **Disclaimer**

This Report, including the data and information contained in this Report, is provided to you on an “as is” and “as available” basis at the sole discretion of the Government of Alberta and subject to the terms and conditions of use below (the “Terms and Conditions”). The Government of Alberta has not verified this Report for accuracy and does not warrant the accuracy of, or make any other warranties or representations regarding, this Report. Furthermore, updates to this Report may not be made available. Your use of any of this Report is at your sole and absolute risk.

This Report is provided to the Government of Alberta, and the Government of Alberta has obtained a license or other authorization for use of the Reports, from:

Shell Canada Energy, Chevron Canada Limited. and Marathon Oil Canada Corporation, for the Quest Project

(collectively the “Project”)

Each member of the Project expressly disclaims any representation or warranty, express or implied, as to the accuracy or completeness of the material and information contained herein, and none of them shall have any liability, regardless of any negligence or fault, for any statements contained in, or for any omissions from, this Report. Under no circumstances shall the Government of Alberta or the Project be liable for any damages, claims, causes of action, losses, legal fees or expenses, or any other cost whatsoever arising out of the use of this Report or any part thereof or the use of any other data or information on this website.

## **Terms and Conditions of Use**

Except as indicated in these Terms and Conditions, this Report and any part thereof shall not be copied, reproduced, distributed, republished, downloaded, displayed, posted or transmitted in any form or by any means, without the prior written consent of the Government of Alberta and the Project.

The Government of Alberta’s intent in posting this Report is to make them available to the public for personal and non-commercial (educational) use. You may not use this Report for any other purpose. You may reproduce data and information in this Report subject to the following conditions:

- any disclaimers that appear in this Report shall be retained in their original form and applied to the data and information reproduced from this Report
- the data and information shall not be modified from its original form
- the Project shall be identified as the original source of the data and information, while this website shall be identified as the reference source, and
- the reproduction shall not be represented as an official version of the materials reproduced, nor as having been made in affiliation with or with the endorsement of the Government of Alberta or the Project

By accessing and using this Report, you agree to indemnify and hold the Government of Alberta and the Project, and their respective employees and agents, harmless from and against any and all claims, demands, actions and costs (including legal costs on a solicitor-client basis) arising out of any breach by you of these Terms and Conditions or otherwise arising out of your use or reproduction of the data and information in this Report.


Your access to and use of this Report is subject exclusively to these Terms and Conditions and any terms and conditions contained within the Report itself, all of which you shall comply with. You will not use this Report for any purpose that is unlawful or prohibited by these Terms and Conditions. You agree that any other use of this Report means you agree to be bound by these Terms and Conditions. These Terms and Conditions are subject to modification, and you agree to review them periodically for changes. If you do not accept these Terms and Conditions you agree to immediately stop accessing this Report and destroy all copies in your possession or control.

These Terms and Conditions may change at any time, and your continued use and reproduction of this Report following any changes shall be deemed to be your acceptance of such change.

If any of these Terms and Conditions should be determined to be invalid, illegal or unenforceable for any reason by any court of competent jurisdiction then the applicable provision shall be severed and the remaining provisions of these Terms and Conditions shall survive and remain in full force and effect and continue to be binding and enforceable.

These Terms and Conditions shall: (i) be governed by and construed in accordance with the laws of the province of Alberta and you hereby submit to the exclusive jurisdiction of the Alberta courts, and (ii) ensure to the benefit of, and be binding upon, the Government of Alberta and your respective successors and assigns.

FORMAT A1

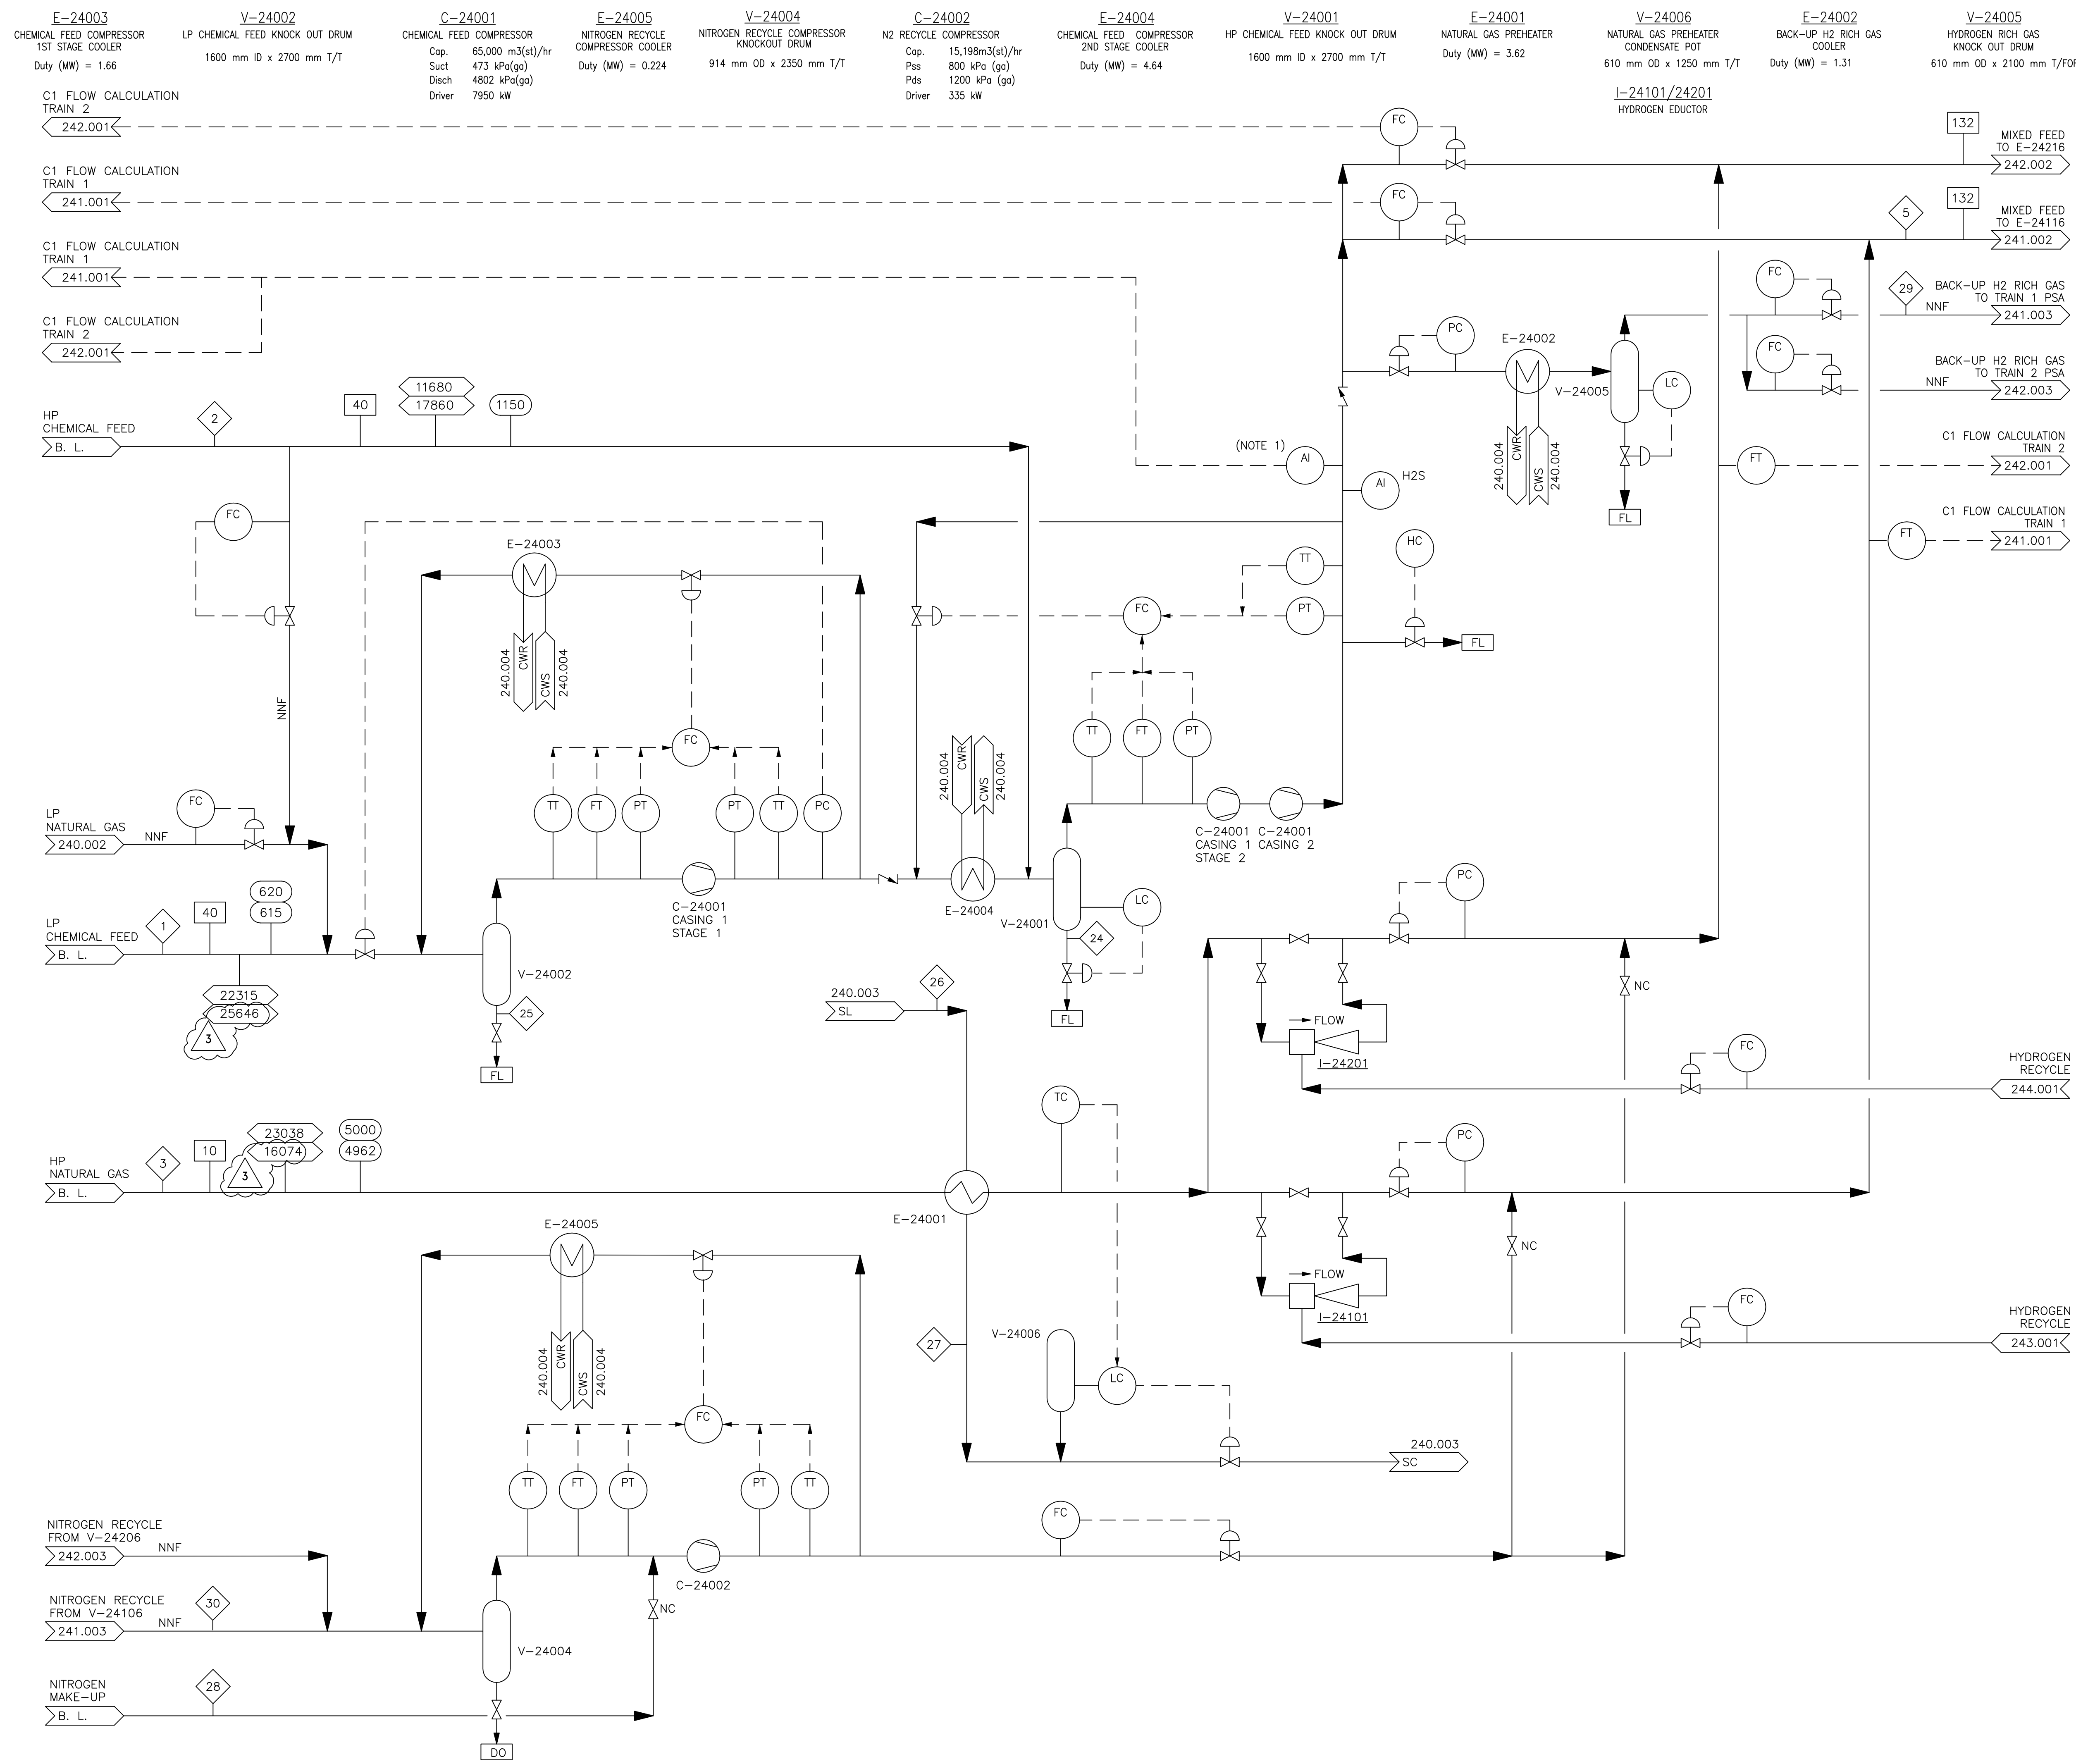

- NOTES**
1. COMPLETE ANALYSIS TO DETERMINE EQUIVALENT C1 IN CHEMICAL FEED.
  2. CASE #2: H2 PRODUCTION WITH ADDITIONAL CHEMICAL FEED AND DOW GAS. FGR OFFLINE. CO2 RICH STREAM TO PSA.
  3. CASE #24: H2 PRODUCTION WITH ADDITIONAL CHEMICAL FEED AND DOW GAS. FLUE GAS RECYCLE ONLINE AT 100%. CO2 LEAN STREAM TO PSA.

**REFERENCE**

	STREAM NUMBER
	TEMPERATURE - CASE #2 (°C) TEMPERATURE - CASE #24 (°C)
	PRESSURE - CASE #2 (kPa-a) PRESSURE - CASE #24 (kPa-a)
	FLOW - CASE #2 (kg/Hr) FLOW - CASE #24 (kg/Hr)
	Std. VOL. FLOW - CASE #2 (m <sup>3</sup> (st)/hr) Std. VOL. FLOW - CASE #24 (m <sup>3</sup> (st)/hr)

**ISSUED FOR CONSTRUCTION**  
21 Oct 2013

**FLUOR.** FLUOR'S RESPONSIBILITY IS LIMITED TO THE REVISION CONTENT SHOWN IN THIS DOCUMENT.

REV	ISSUED DATE	DESCRIPTION	DWN	CHKD	ENG	APP	APP	CLNT APP
3	13 SEP 30	RE-ISSUED IFC ON NEXT HARD REV	GB	CC	LMF	KH	CV	
2C	12 DEC 21	ISSUED FOR CONSTRUCTION	GB	KB	SM	KH	CV	
2B	11 AUG 31	RE-ISSUED FOR QUEST DESIGN	GB	SM	SM	JL	CV	M/38
2A	11 MAR 04	RE-ISSUED FOR QUEST DESIGN	GB	SM	BS	JL	CV	M/38
2	10 OCT 25	ISSUED FOR QUEST DESIGN	JH	SM	BS	JL	CV	M/38
1A	10 AUG 24	ISSUED FOR QUEST COARSE HAZOP	JH					
1	02 SEP 20	AS-BUILT	LWM	MWP	AAI	MWP		HRM
0	00 OCT 23	IFC: ISSUED FOR CONSTRUCTION	WZF	SW	SW	MWP	DLA	HRM


**SHELL CANADA LTD.**  
ATHABASCA OIL SANDS  
DOWNSTREAM PROJECT

PARSONS . KRUPP UHDE . TRI OCEAN

**PROCESS FLOW DIAGRAM**  
HYDROGEN MANUFACTURING UNIT  
CHEMICAL FEED COMPRESSION

SCALE: NTS	TOE DWG. No.: 99049-0-DG-BB-00001.1
SHELL DWG NO.: 240.0001.000.040.001	REV. 3

0011-BBW

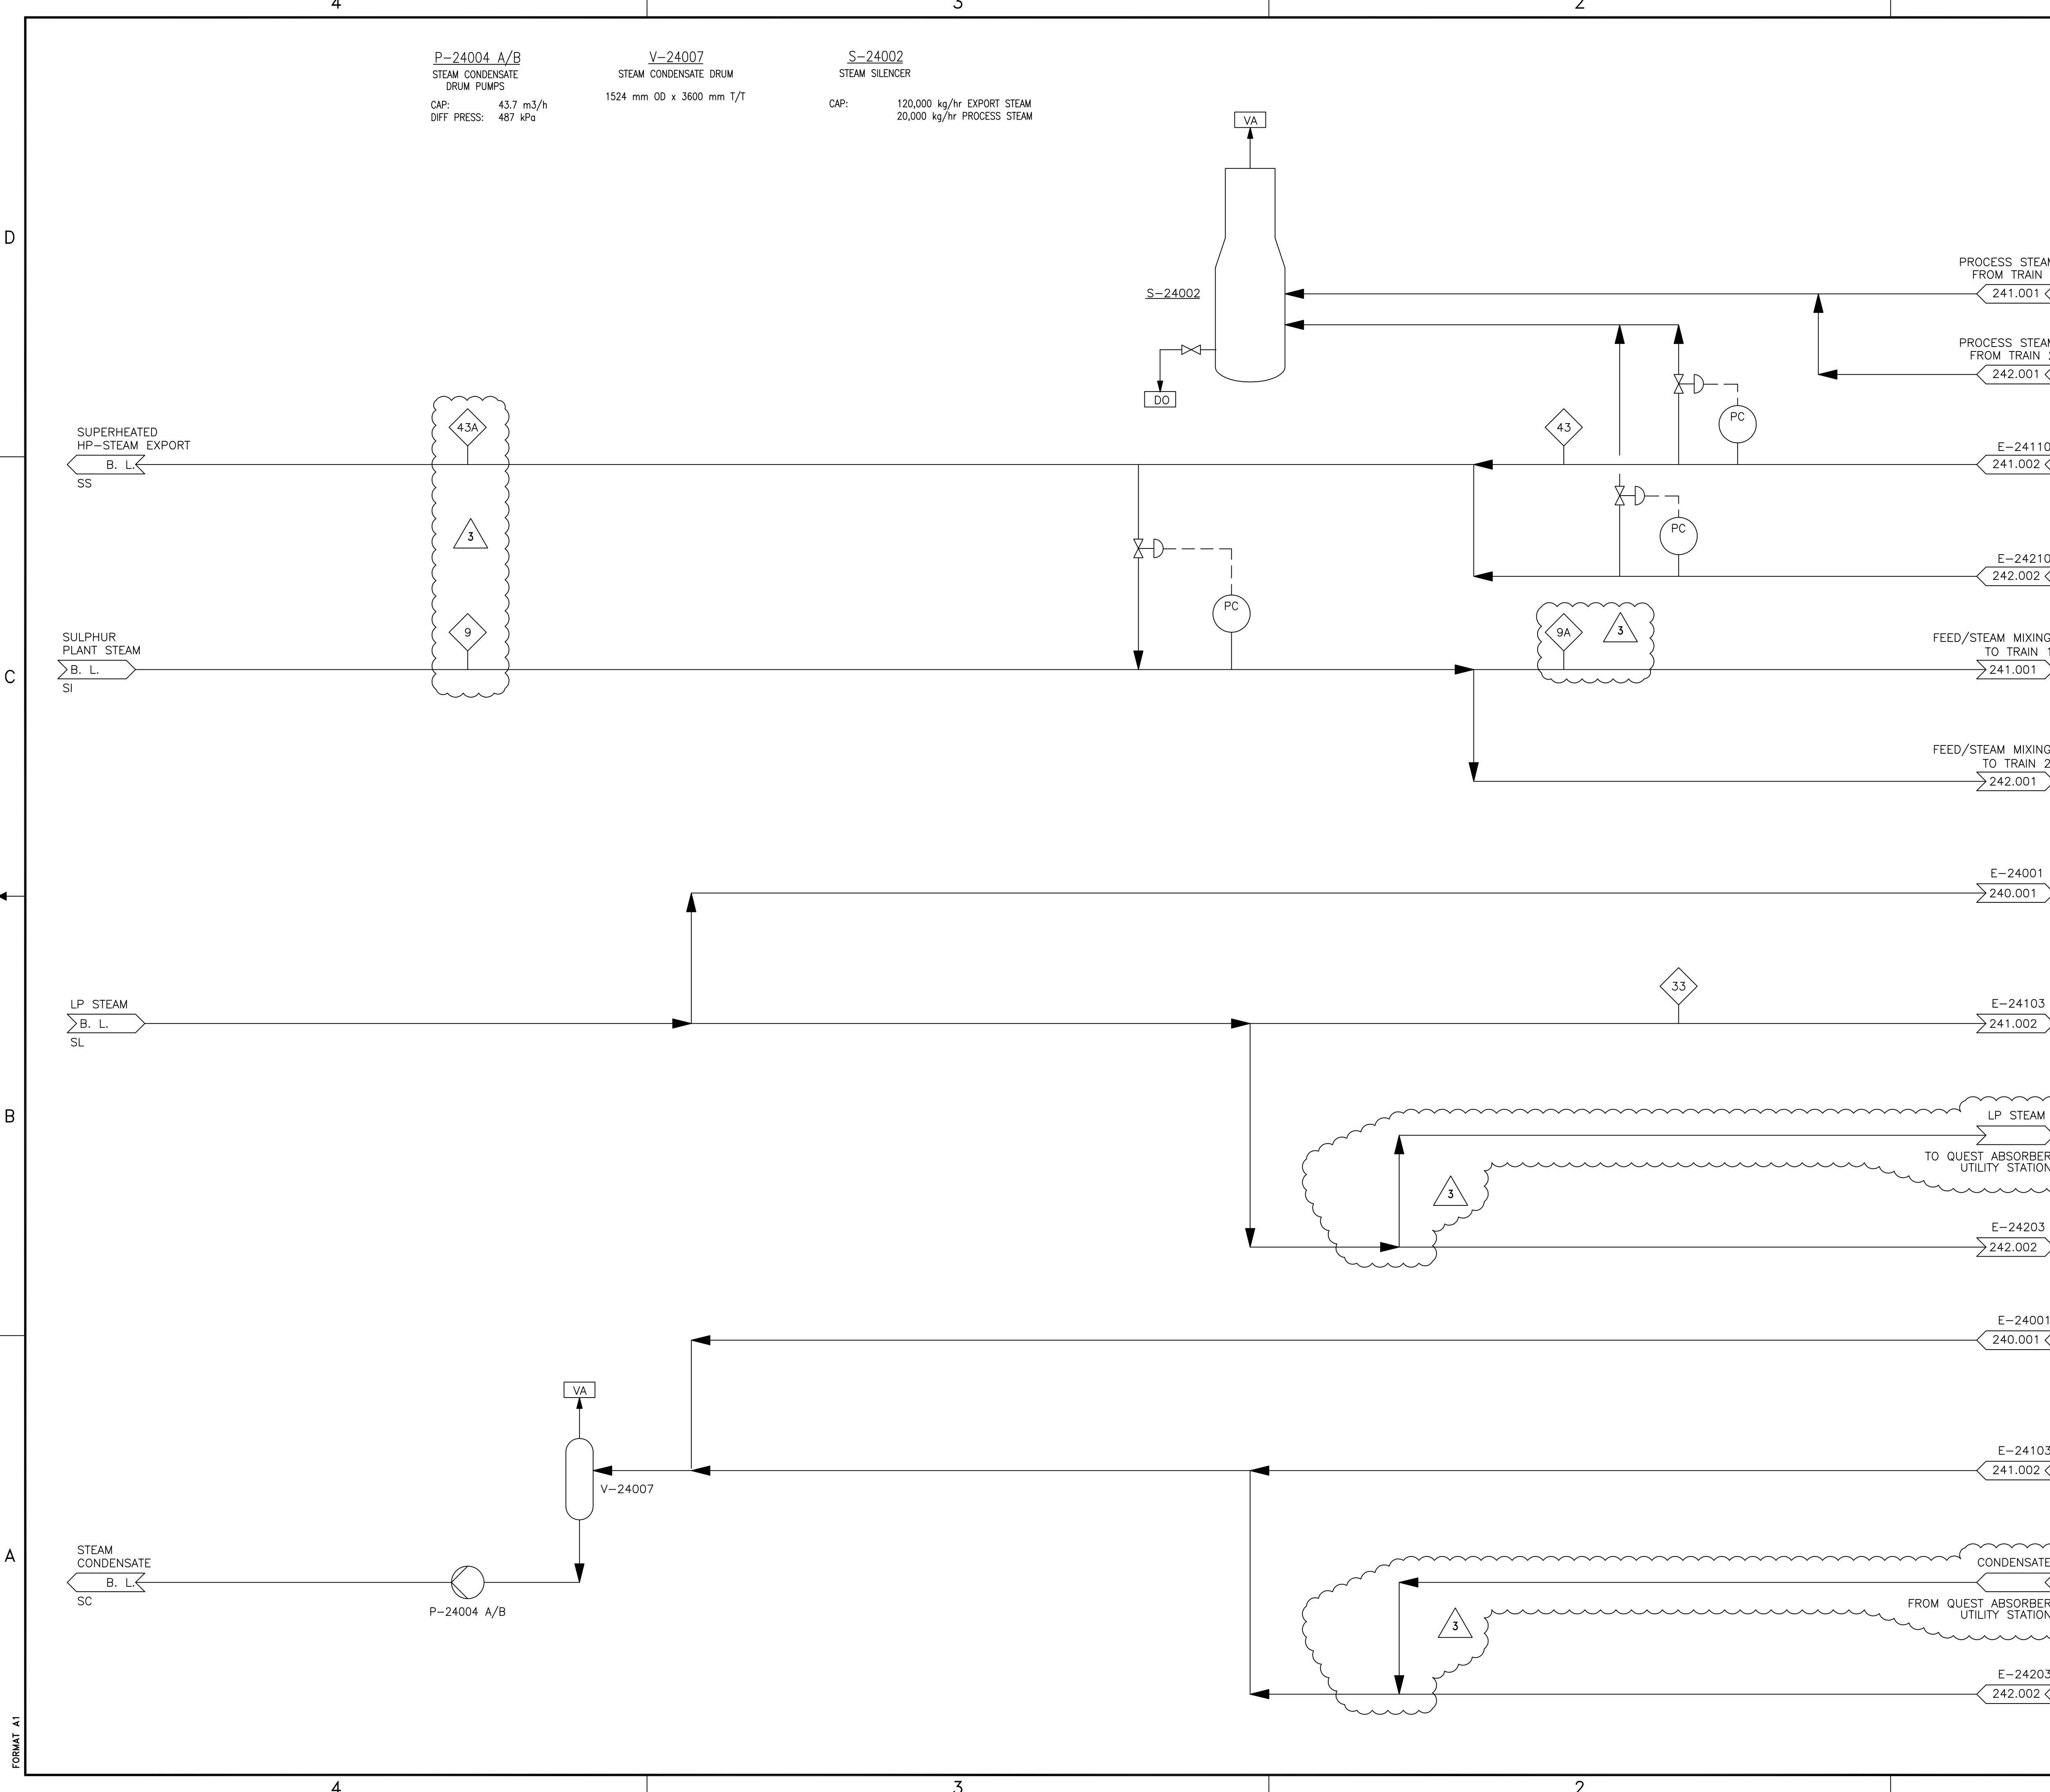

P-24004 A/B  
STEAM CONDENSATE  
DRUM PUMPS  
CAP: 43.7 m<sup>3</sup>/h  
DIFF PRESS: 487 kPa

V-24007  
STEAM CONDENSATE DRUM  
1524 mm OD x 3600 mm T/T

S-24002  
STEAM SILENCER  
CAP: 120,000 kg/hr EXPORT STEAM  
20,000 kg/hr PROCESS STEAM

NOTES

KEY PLAN

REFERENCE DRAWINGS

**ISSUED FOR CONSTRUCTION**  
21 Oct 2013

**FLUOR.** FLUOR'S RESPONSIBILITY IS LIMITED TO THE REVISION CONTENT SHOWN IN THIS DOCUMENT.

3	13 SEP 30	RE-ISSUED IFC ON NEXT HARD REV	GB	CC	LMF	KH	CV	
2B	13 JAN 10	ISSUED FOR CONSTRUCTION	GB	KB		KH	CV	
2A	11 MAR 01	RE-ISSUED FOR DESIGN	GB	SM	MB	JL	CV	W/98
2	10 OCT 25	ISSUED FOR QUEST DESIGN	JH	SM	MB	JL	CV	W/98
1A	10 AUG 26	ISSUED FOR QUEST COARSE HAZOP	JH					
1	02 SEP 20	AS-BUILT	LWM	MWP	AAI	MWP		HRM
0	00 OCT 23	IFC: ISSUED FOR CONSTRUCTION	WZF	SW	SW	MWP	DLA	HRM
REV	ISSUED DATE	DESCRIPTION	DWN	CHKD	ENG	APP	APP	CLNT APP

**SHELL CANADA LTD.**  
ATHABASCA OIL SANDS  
DOWNSTREAM PROJECT


PARSONS . KRUPP UHDE . TRI OCEAN

**UTILITY PROCESS FLOW DIAGRAM  
HYDROGEN MANUFACTURING UNIT  
STEAM AND CONDENSATE**

SCALE: NTS  
SHELL DWG NO.: 240.0001.000.040.003  
TOE DWG. No.: 99049-0-DG-BB-00003.1  
REV: 3

FORMAT A1

0031-88y

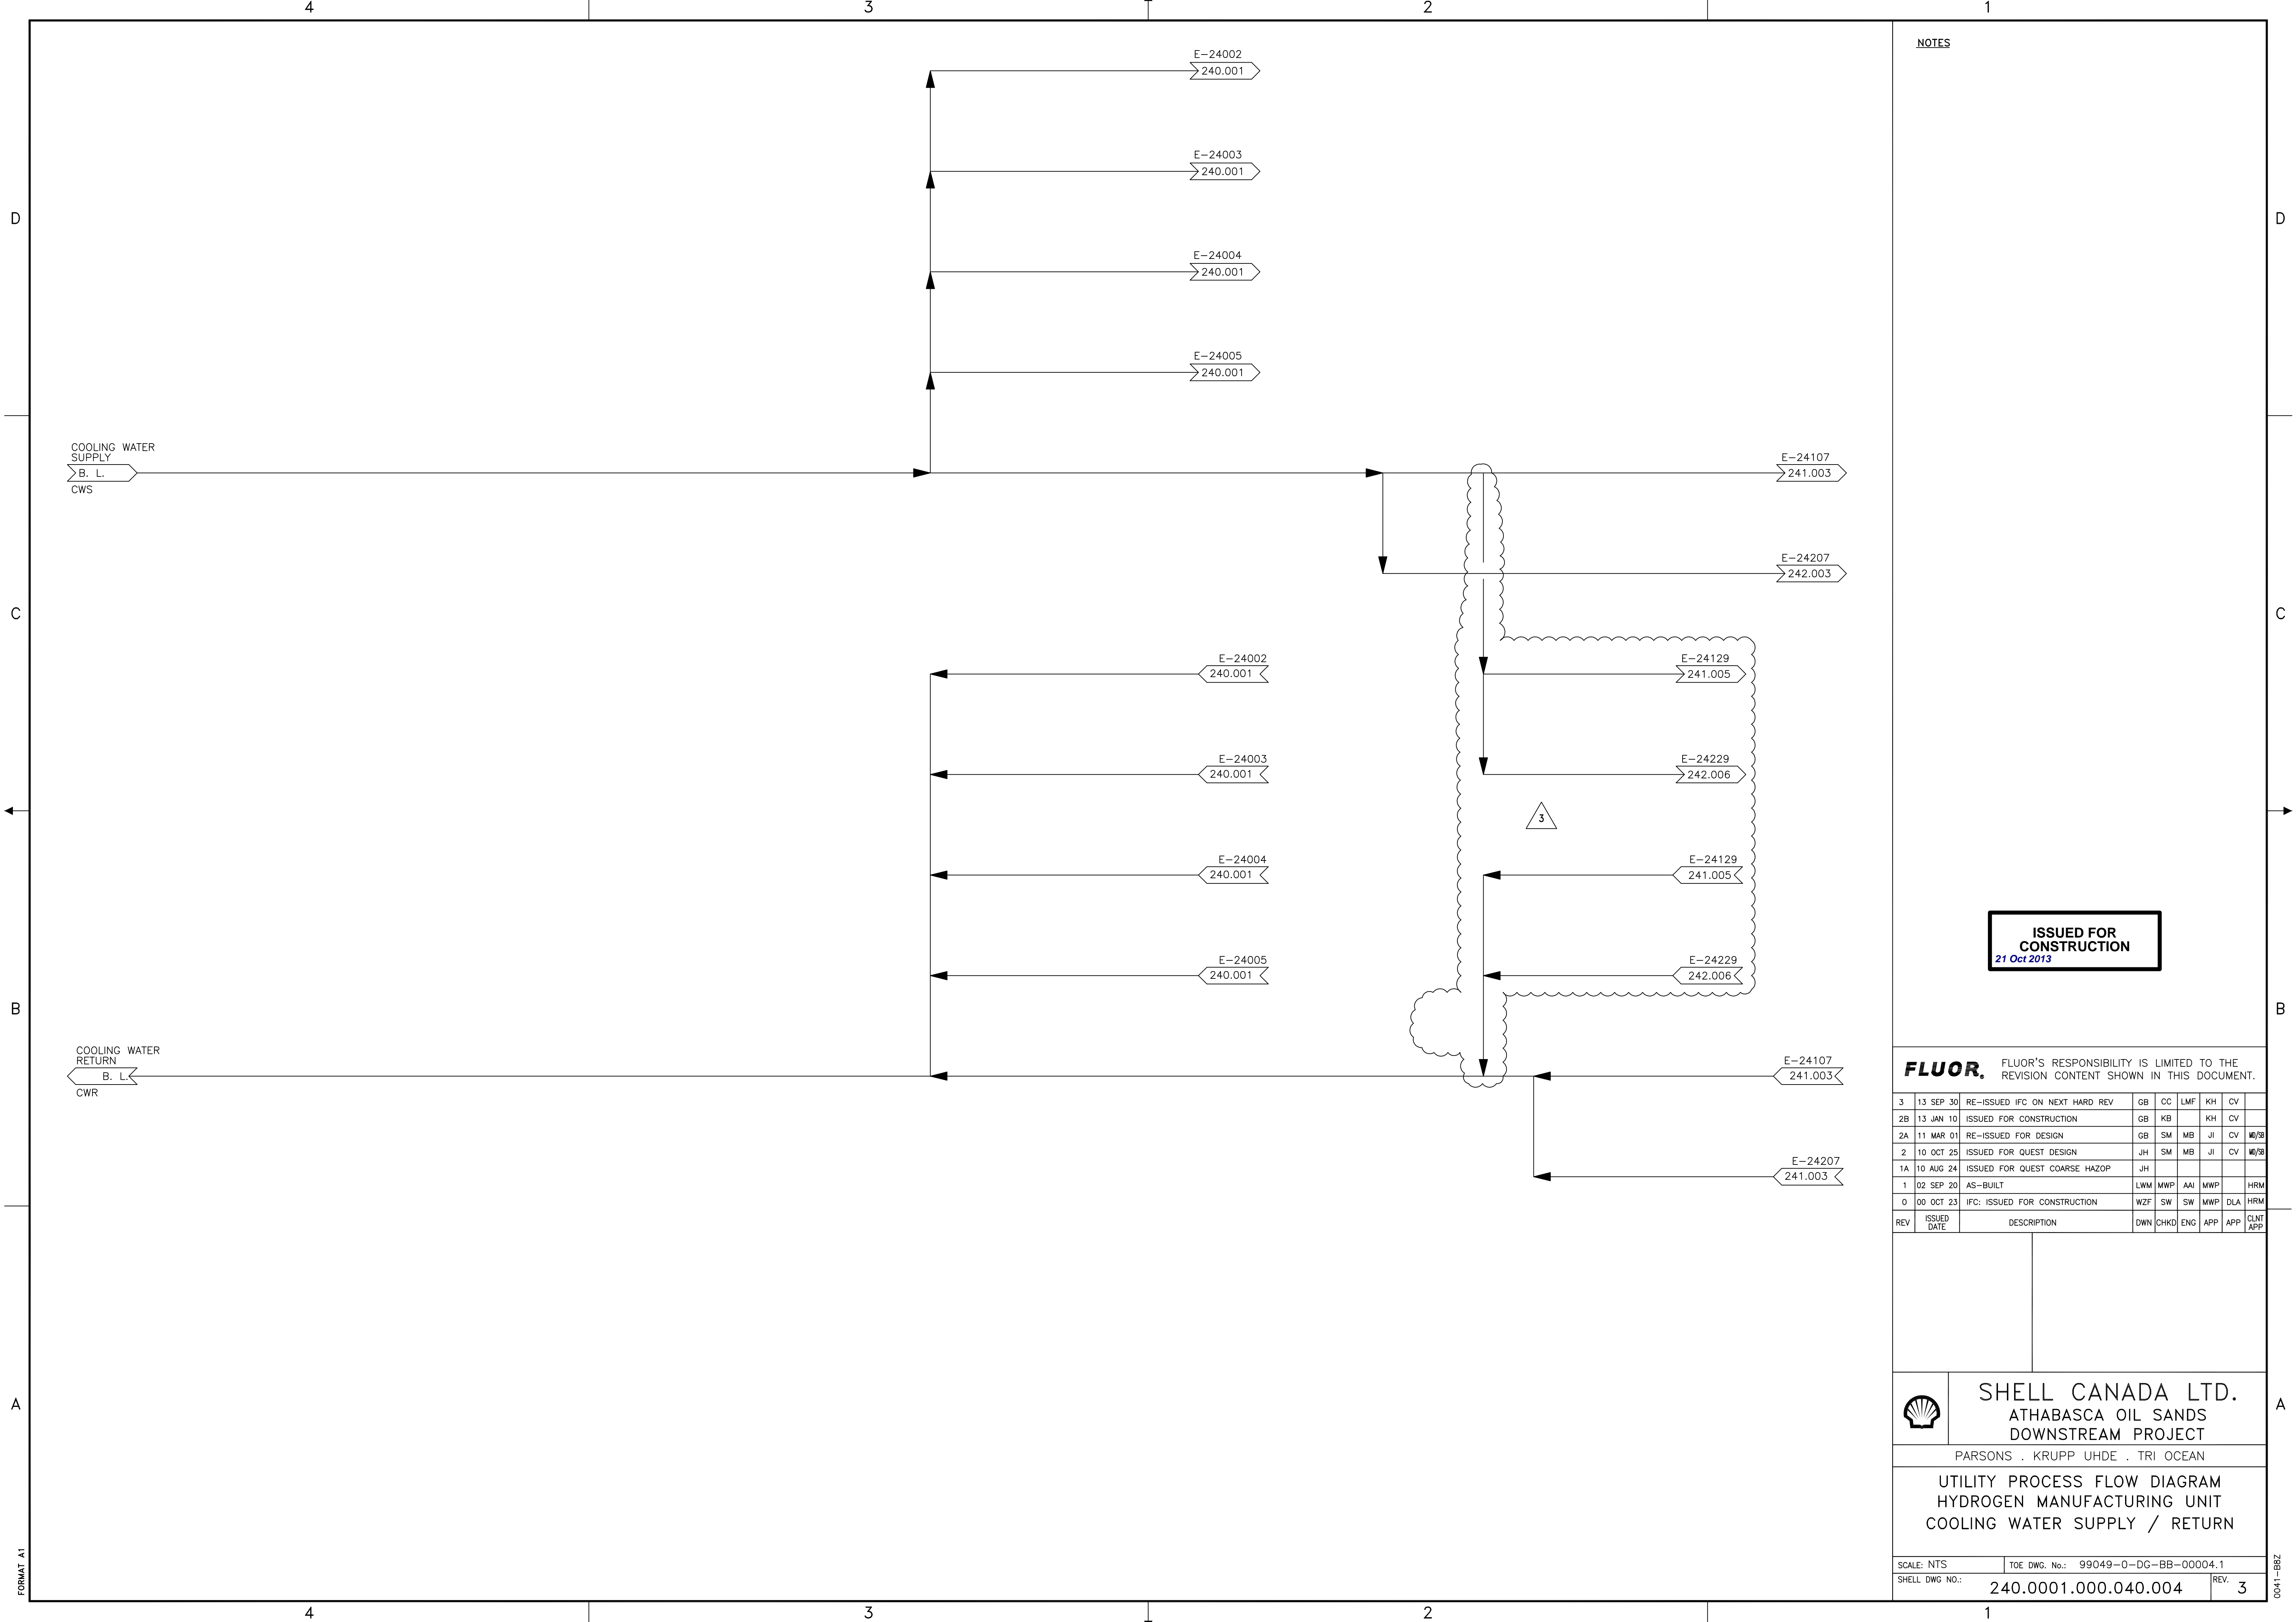

NOTES

**ISSUED FOR CONSTRUCTION**  
21 Oct 2013

**FLUOR.** FLUOR'S RESPONSIBILITY IS LIMITED TO THE REVISION CONTENT SHOWN IN THIS DOCUMENT.

3	13 SEP 30	RE-ISSUED IFC ON NEXT HARD REV	GB	CC	LMF	KH	CV	
2B	13 JAN 10	ISSUED FOR CONSTRUCTION	GB	KB		KH	CV	
2A	11 MAR 01	RE-ISSUED FOR DESIGN	GB	SM	MB	JJ	CV	WJ/SB
2	10 OCT 25	ISSUED FOR QUEST DESIGN	JH	SM	MB	JJ	CV	WJ/SB
1A	10 AUG 24	ISSUED FOR QUEST COARSE HAZOP	JH					
1	02 SEP 20	AS-BUILT	LWM	MWP	AAI	MWP		HRM
0	00 OCT 23	IFC: ISSUED FOR CONSTRUCTION	WZF	SW	SW	MWP	DLA	HRM
REV	ISSUED DATE	DESCRIPTION	DWN	CHKD	ENG	APP	APP	CLNT APP

 **SHELL CANADA LTD.**  
ATHABASCA OIL SANDS  
DOWNSTREAM PROJECT

PARSONS . KRUPP UHDE . TRI OCEAN

UTILITY PROCESS FLOW DIAGRAM  
HYDROGEN MANUFACTURING UNIT  
COOLING WATER SUPPLY / RETURN

SCALE: NTS TOE DWG. No.: 99049-0-DG-BB-00004.1  
SHELL DWG NO.: 240.0001.000.040.004 REV. 3

FORMAT A1


0041-BBZ



FORMAT A1

**V-24101**  
HYDRODESULPHURIZATION REACTOR I  
2900 mm I.D. x 5600 mm T/T  
Catalyst Vol. (m<sup>3</sup>): 10.6 Hydrotreating  
5.0 Chloride Guard  
27.0 Desulphurization

**V-24102**  
HYDRODESULPHURIZATION REACTOR II  
2900 mm I.D. x 5600 mm T/T  
Catalyst Vol. (m<sup>3</sup>): 10.6 Hydrotreating  
5.0 Chloride Guard  
27.0 Desulphurization

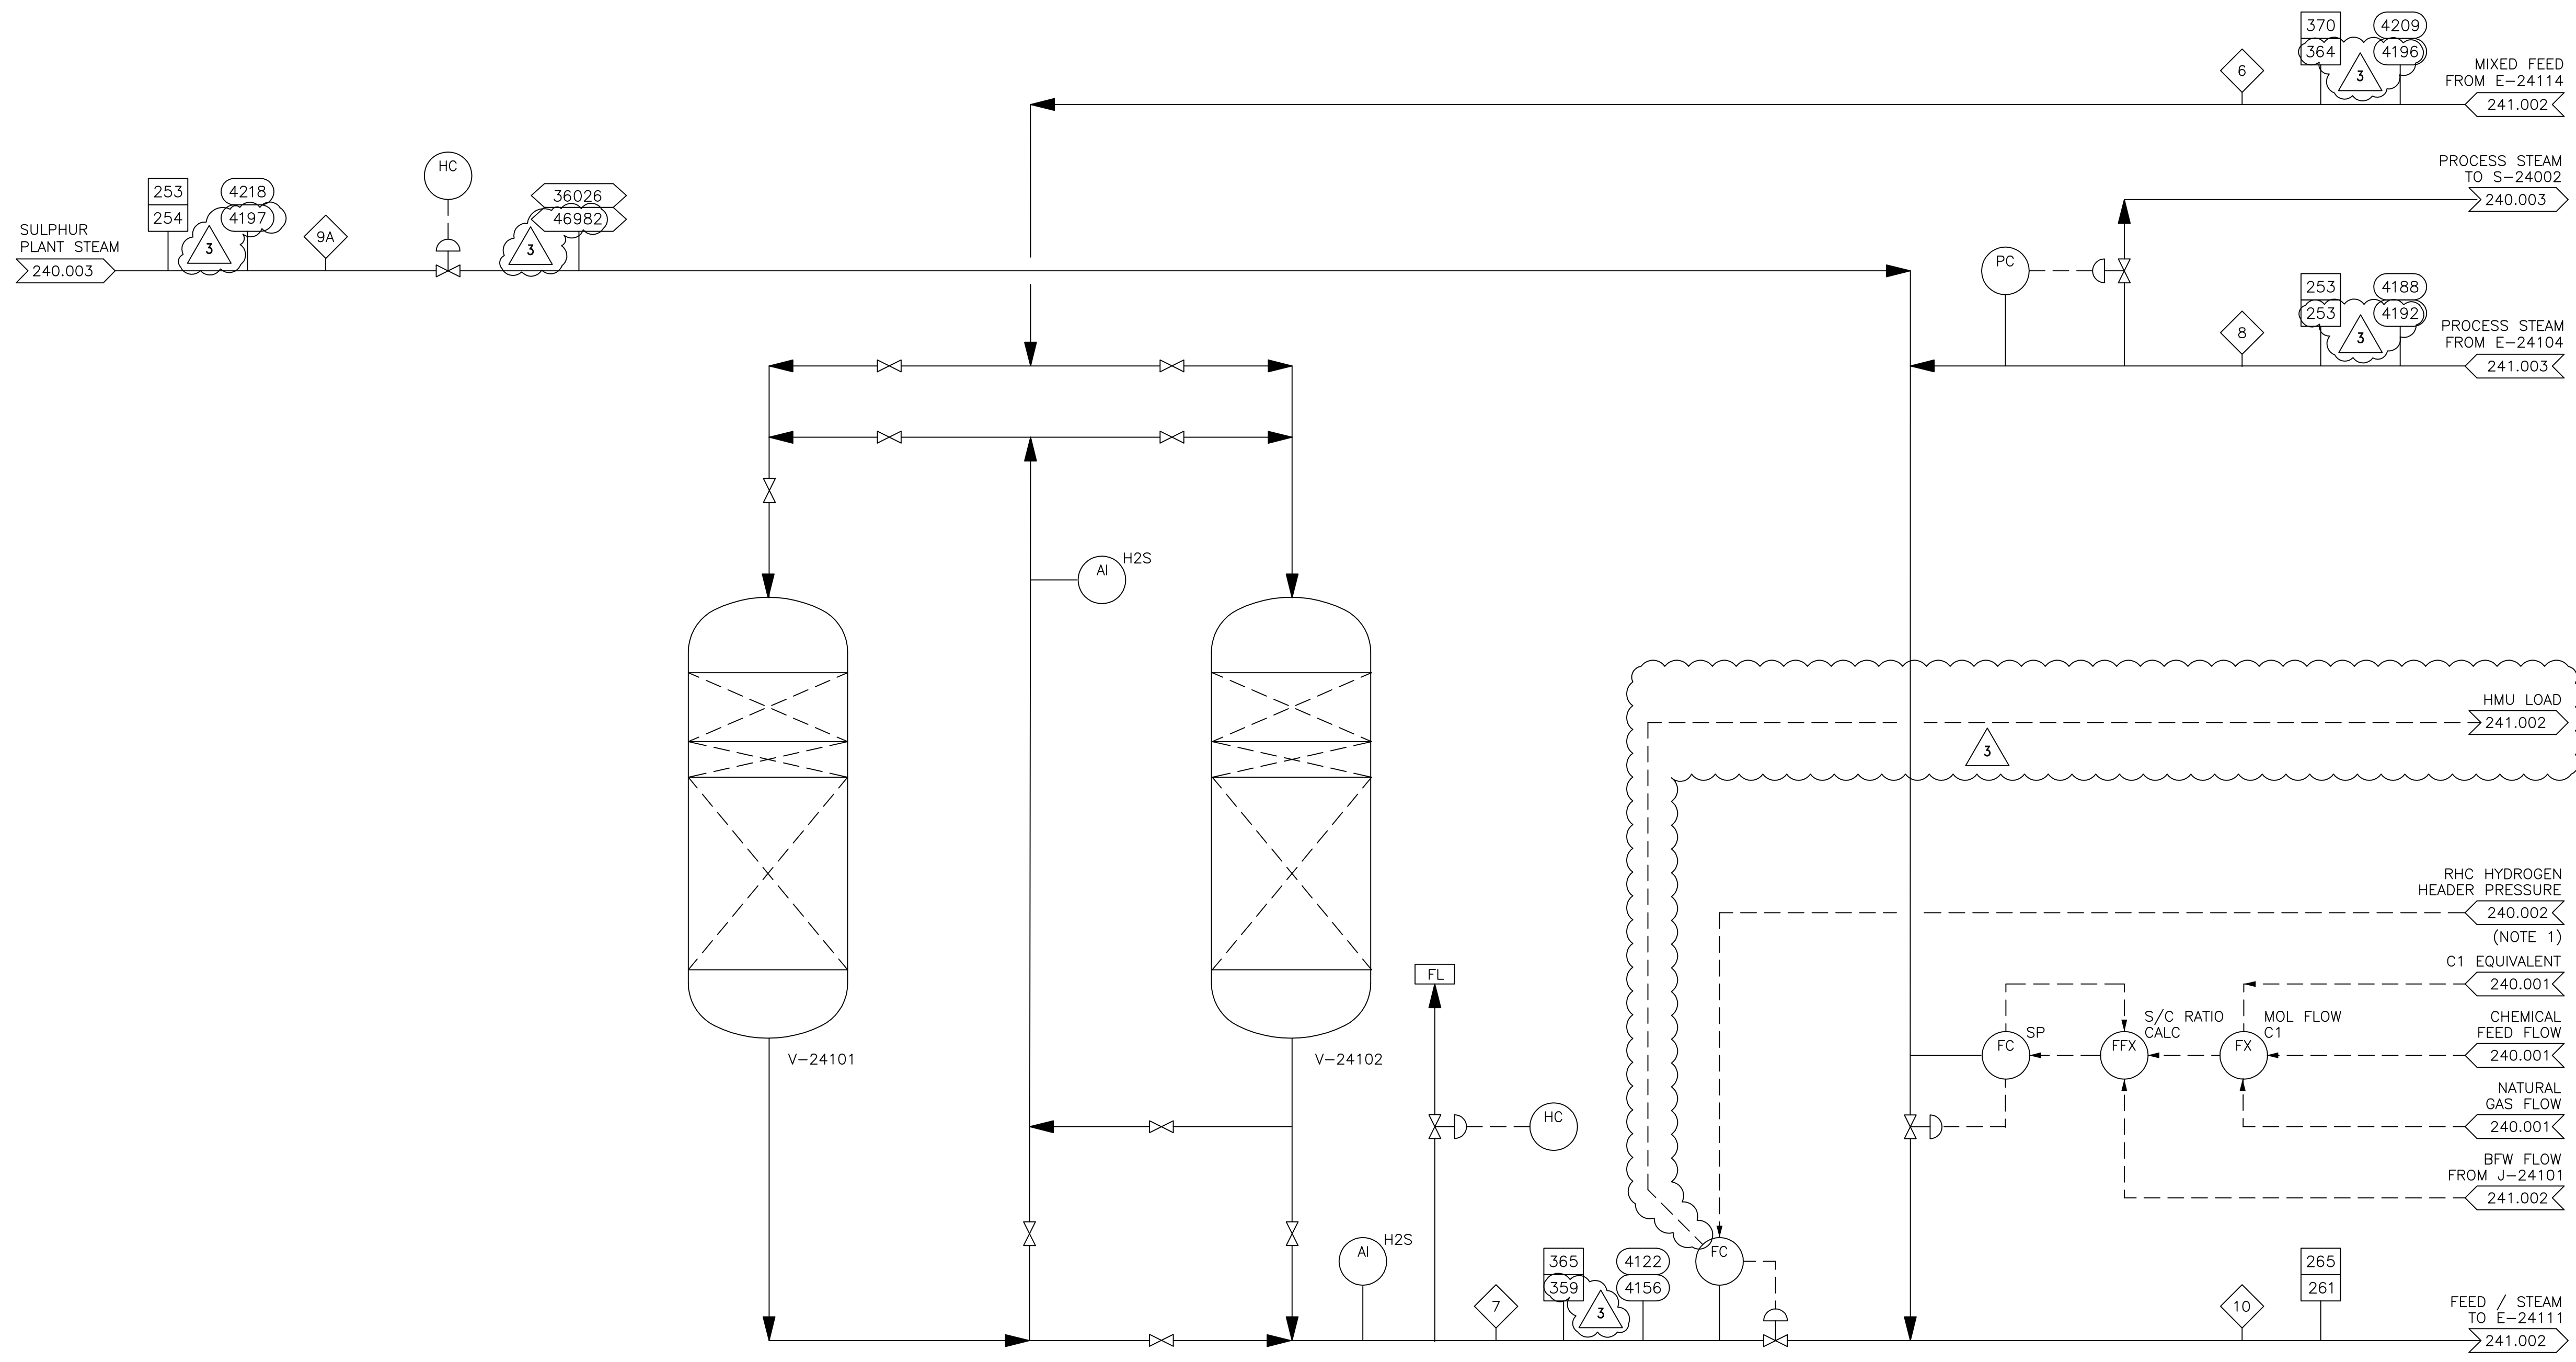

**NOTES**

1. HYDROGEN HEADER PRESSURE AT RHC WILL AUTOMATICALLY ADJUST HMU PRODUCTION. HMU IS RESPONSIBLE FOR ADJUSTMENT OF EACH HMU TRAIN BASED ON RHC HYDROGEN PRESSURE.
2. CASE #2: H<sub>2</sub> PRODUCTION WITH ADDITIONAL CHEMICAL FEED AND DOW GAS. FGR OFFLINE. CO<sub>2</sub> RICH STREAM TO PSA.
- CASE #24: H<sub>2</sub> PRODUCTION WITH ADDITIONAL CHEMICAL FEED AND DOW GAS. FLUE GAS RECYCLE ONLINE AT 100%. CO<sub>2</sub> LEAN STREAM TO PSA.

**REFERENCE**

- ◇ STREAM NUMBER
- TEMPERATURE - CASE #2 (°C)  
□ TEMPERATURE - CASE #24 (°C)
- PRESSURE - CASE #2 (kPa-a)  
○ PRESSURE - CASE #24 (kPa-a)
- ▬ FLOW - CASE #2 (kg/Hr)  
▬ FLOW - CASE #24 (kg/Hr)
- ▬ Std. VOL. FLOW - CASE #2 (m<sup>3</sup> (st)/hr)  
▬ Std. VOL. FLOW - CASE #24 (m<sup>3</sup> (st)/hr)

**ISSUED FOR CONSTRUCTION**  
21 Oct 2013

**FLUOR.** FLUOR'S RESPONSIBILITY IS LIMITED TO THE REVISION CONTENT SHOWN IN THIS DOCUMENT.

REV	ISSUED DATE	DESCRIPTION	DWN	CHKD	ENG	APP	APP	CLNT	APP
3	13 SEP 30	RE-ISSUED IFC ON NEXT HARD REV	GB	CC	LMF	KH	CV		
2C	12 DEC 21	ISSUED FOR CONSTRUCTION	GB	KB	LMF	KH	CV		
2B	11 AUG 31	RE-ISSUED FOR QUEST DESIGN	GB	SM	SM	JL	CV		
2A	11 MAR 04	RE-ISSUED FOR QUEST DESIGN	GB	SM	BS	JL	CV		
2	10 NOV 03	ISSUED FOR QUEST DESIGN	JH	SM	BS	JL	CV		
1A	10 AUG 24	ISSUED FOR QUEST COARSE HAZOP	JH						
1	02 SEP 20	AS-BUILT	LWM	MWP	AAI	MWP		HRM	
0	00 OCT 23	IFC: ISSUED FOR CONSTRUCTION	WZF	SW	SW	MWP	DLA	HRM	


**SHELL CANADA LTD.**  
ATHABASCA OIL SANDS  
DOWNSTREAM PROJECT

PARSONS . KRUPP UHDE . TRI OCEAN

**PROCESS FLOW DIAGRAM**  
HYDROGEN MANUFACTURING UNIT  
FEED GAS DESULPHURIZATION

SCALE: NTS TOE DWG. No.: 99049-1-DG-BB-00001.1  
SHELL DWG NO.: 241.0001.000.040.001 REV. 3

0011-B98B

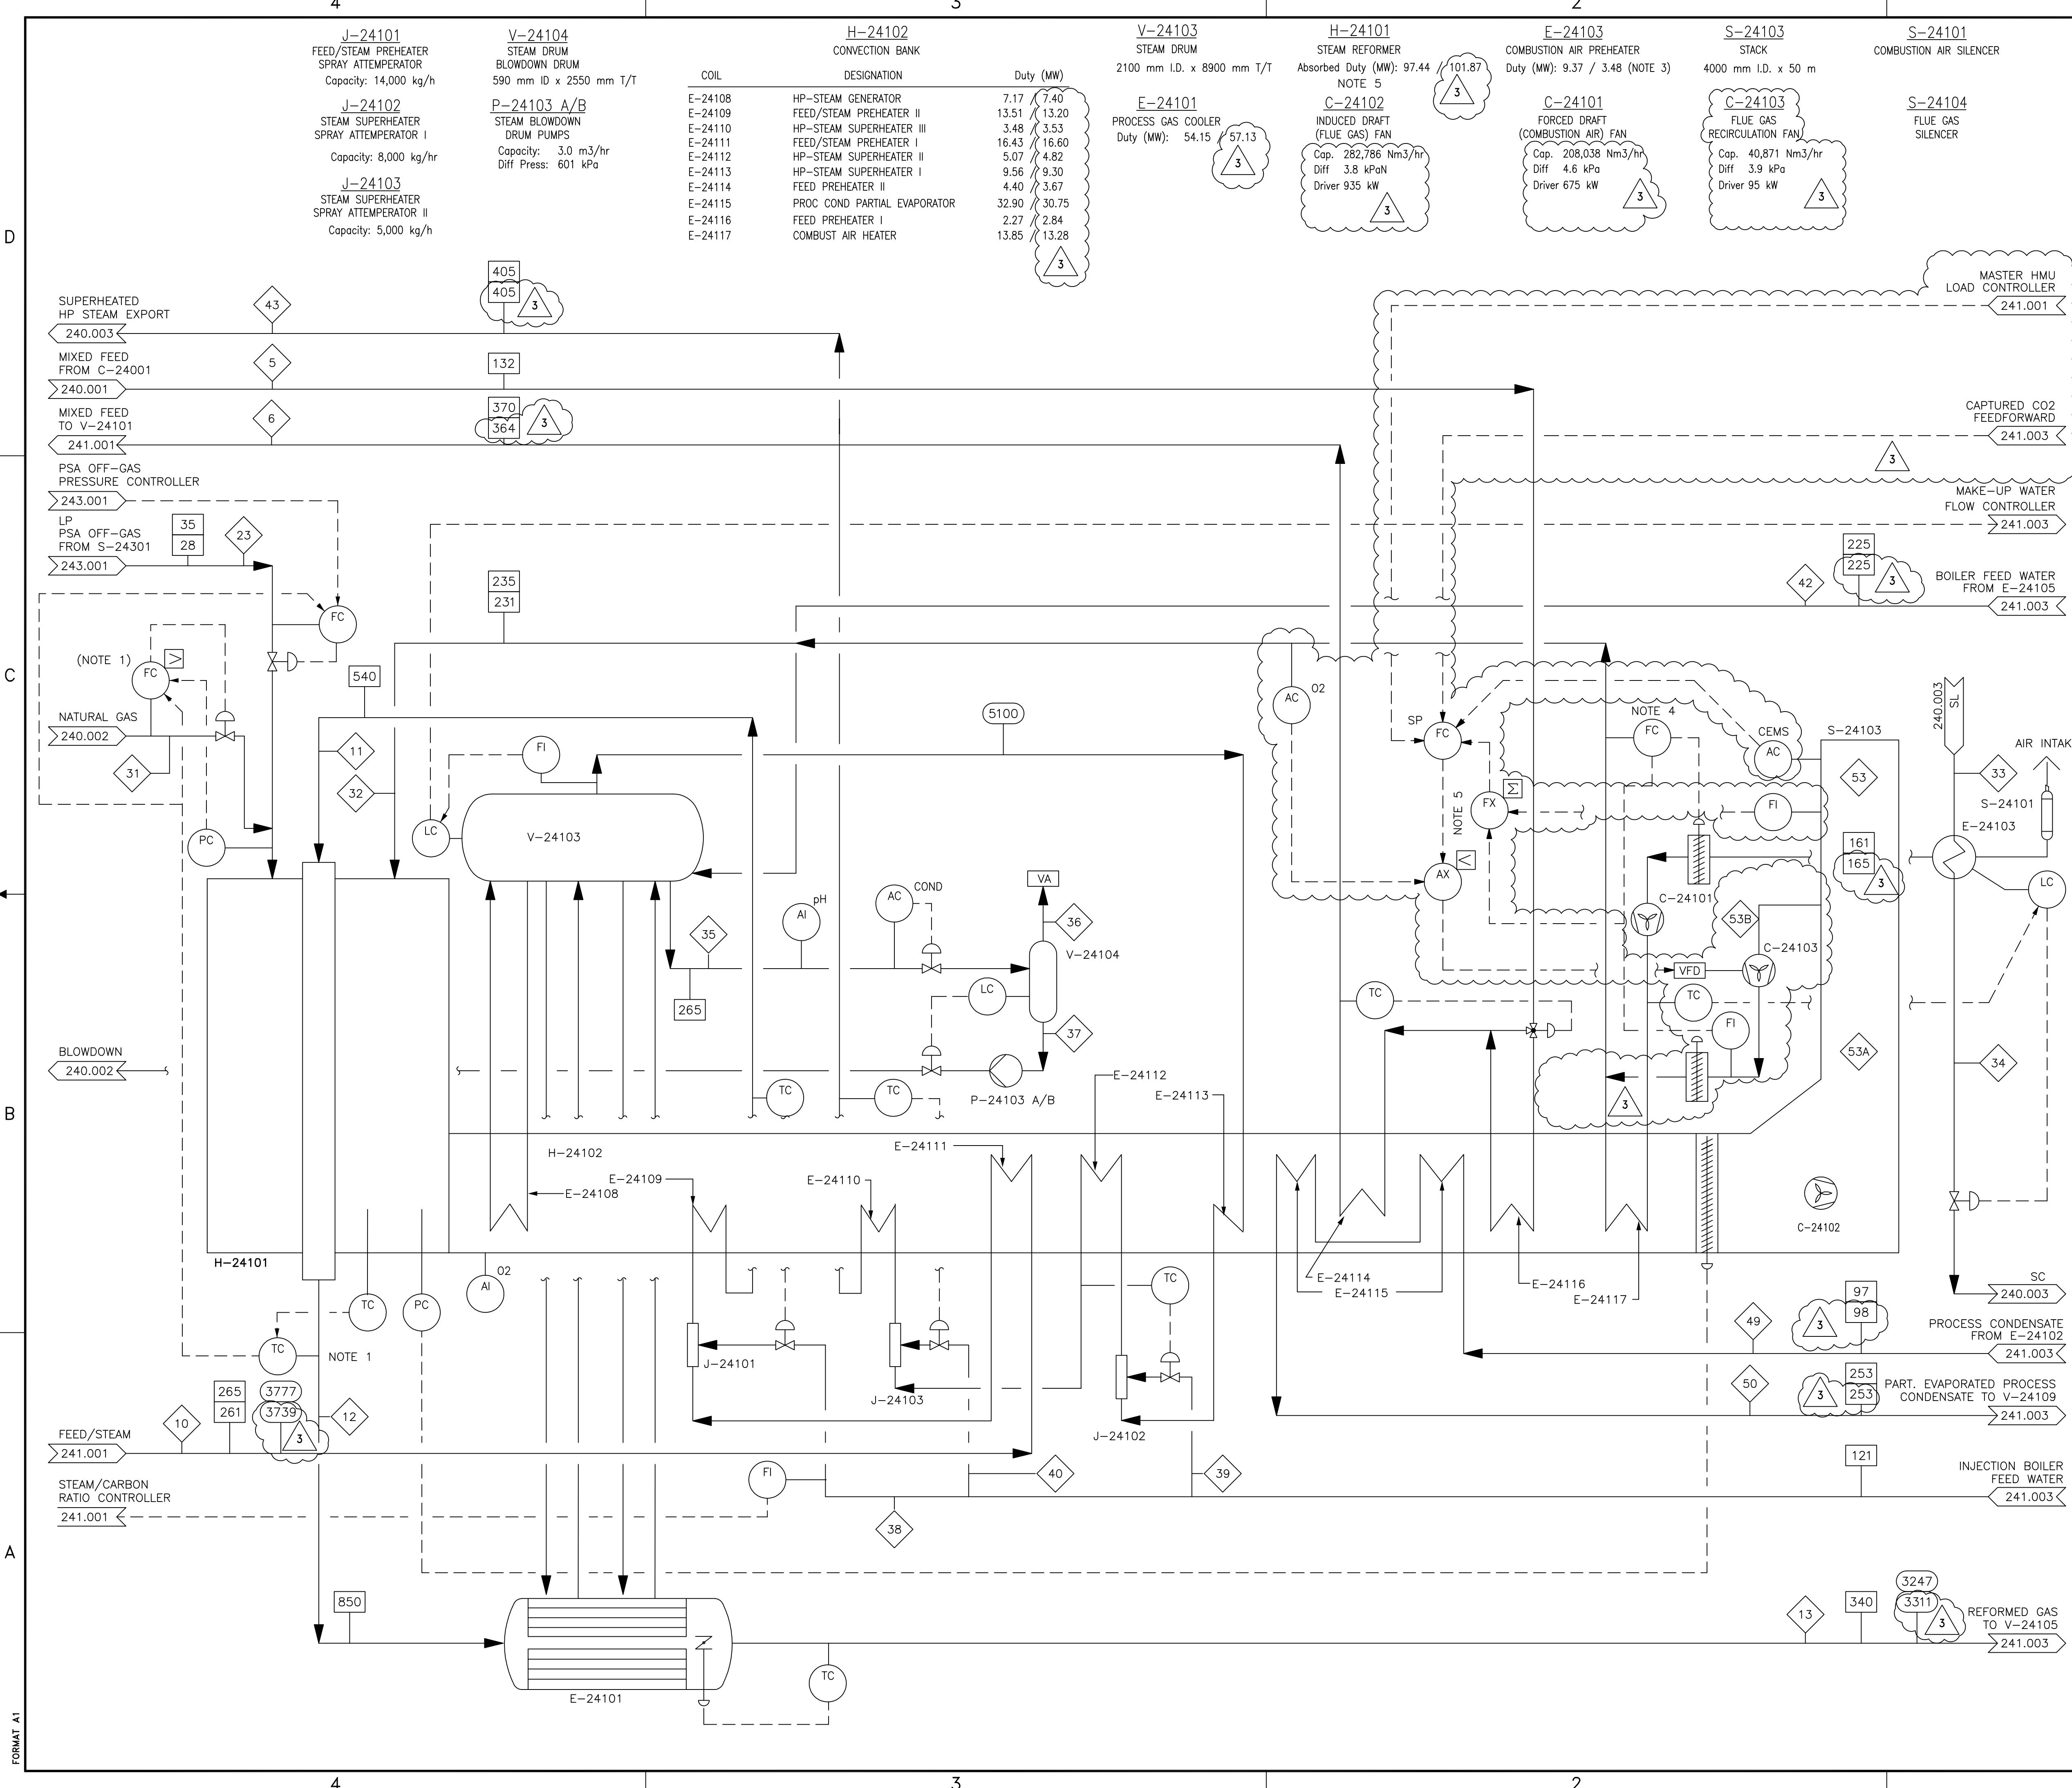

- NOTES**
- PROCESS SIDE TEMPERATURE IS CONTROLLED, WITH CHANGES IN FLUE GAS TEMPERATURE USED TO INITIATE NATURAL GAS FLOW CHANGES TO MINIMIZE DEVIATIONS IN THE PROCESS TEMPERATURE.
  - FLOWS & DUTIES: CASE #2 / CASE #24.  
CASE #2: H2 PRODUCTION WITH ADDITIONAL CHEMICAL FEED AND DOW GAS. FGR OFFLINE. CO2 RICH STREAM TO PSA.  
CASE #24: H2 PRODUCTION WITH ADDITIONAL CHEMICAL FEED AND DOW GAS. FLUE GAS RECYCLE ONLINE AT 100% CO2 LEAN STREAM TO PSA.
  - DUTY WINTER/SUMMER: FOR CASE #2.
  - FLOW CONTROL ON COMBUSTION AIR WITH TRIM FROM EXCESS O2 AT BURNER OUTLET.
  - FLUE GAS RECIRCULATION FAN CONTROLLED BY TOTAL CONVECTION SECTION FLOW WITH FEEDFORWARD FROM CO2 CAPTURED.

- REFERENCE**
- ◇ STREAM NUMBER
  - TEMPERATURE - CASE #2 (°C)  
□ TEMPERATURE - CASE #24 (°C)
  - PRESSURE - CASE #2 (kPa-a)  
○ PRESSURE - CASE #24 (kPa-a)
  - ▬ FLOW - CASE #2 (kg/Hr)  
▬ FLOW - CASE #24 (kg/Hr)
  - ▬ Std. VOL. FLOW - CASE #2 (m<sup>3</sup> (st)/hr)  
▬ Std. VOL. FLOW - CASE #24 (m<sup>3</sup> (st)/hr)

**ISSUED FOR CONSTRUCTION**  
21 Oct 2013

**FLUOR.** FLUOR'S RESPONSIBILITY IS LIMITED TO THE REVISION CONTENT SHOWN IN THIS DOCUMENT.

REV	DATE	DESCRIPTION	DWN	CK	ENG	AP1	AP2	C-APP
3	13 SEP 30	RE-ISSUED IFC ON NEXT HARD REV	GB	CC	LMF	KH	CV	
2C	13 JAN 08	ISSUED FOR CONSTRUCTION	GB	KB	LMF	KH	CV	
2B	11 AUG 31	RE-ISSUED FOR QUEST DESIGN	GB	SM	SM	JL	CV	W/SB
2A	11 MAR 04	RE-ISSUED FOR QUEST DESIGN	GB	SM	BS	JL	CV	W/SB
2	10 OCT 25	ISSUED FOR QUEST DESIGN	JH	SM	BS	JL	CV	W/SB
1A	10 AUG 24	ISSUED FOR QUEST COARSE HAZOP	JH					
1	02 SEP 20	AS-BUILT	LWM	MWP	AAI	MWP		HRM
0	00 OCT 23	IFC: ISSUED FOR CONSTRUCTION	WZF	SW	MWP	DLA		HRM


**SHELL CANADA LTD.**  
ATHABASCA OIL SANDS  
DOWNSTREAM PROJECT

PARSONS . KRUPP UHDE . TRI OCEAN

**PROCESS FLOW DIAGRAM**  
HYDROGEN MANUFACTURING UNIT  
STEAM REFORMING

SCALE: NTS TOE DWG. No.: 99049-1-DG-BB-00002.1  
SHELL DWG NO.: 241.0001.000.040.002 REV. 3



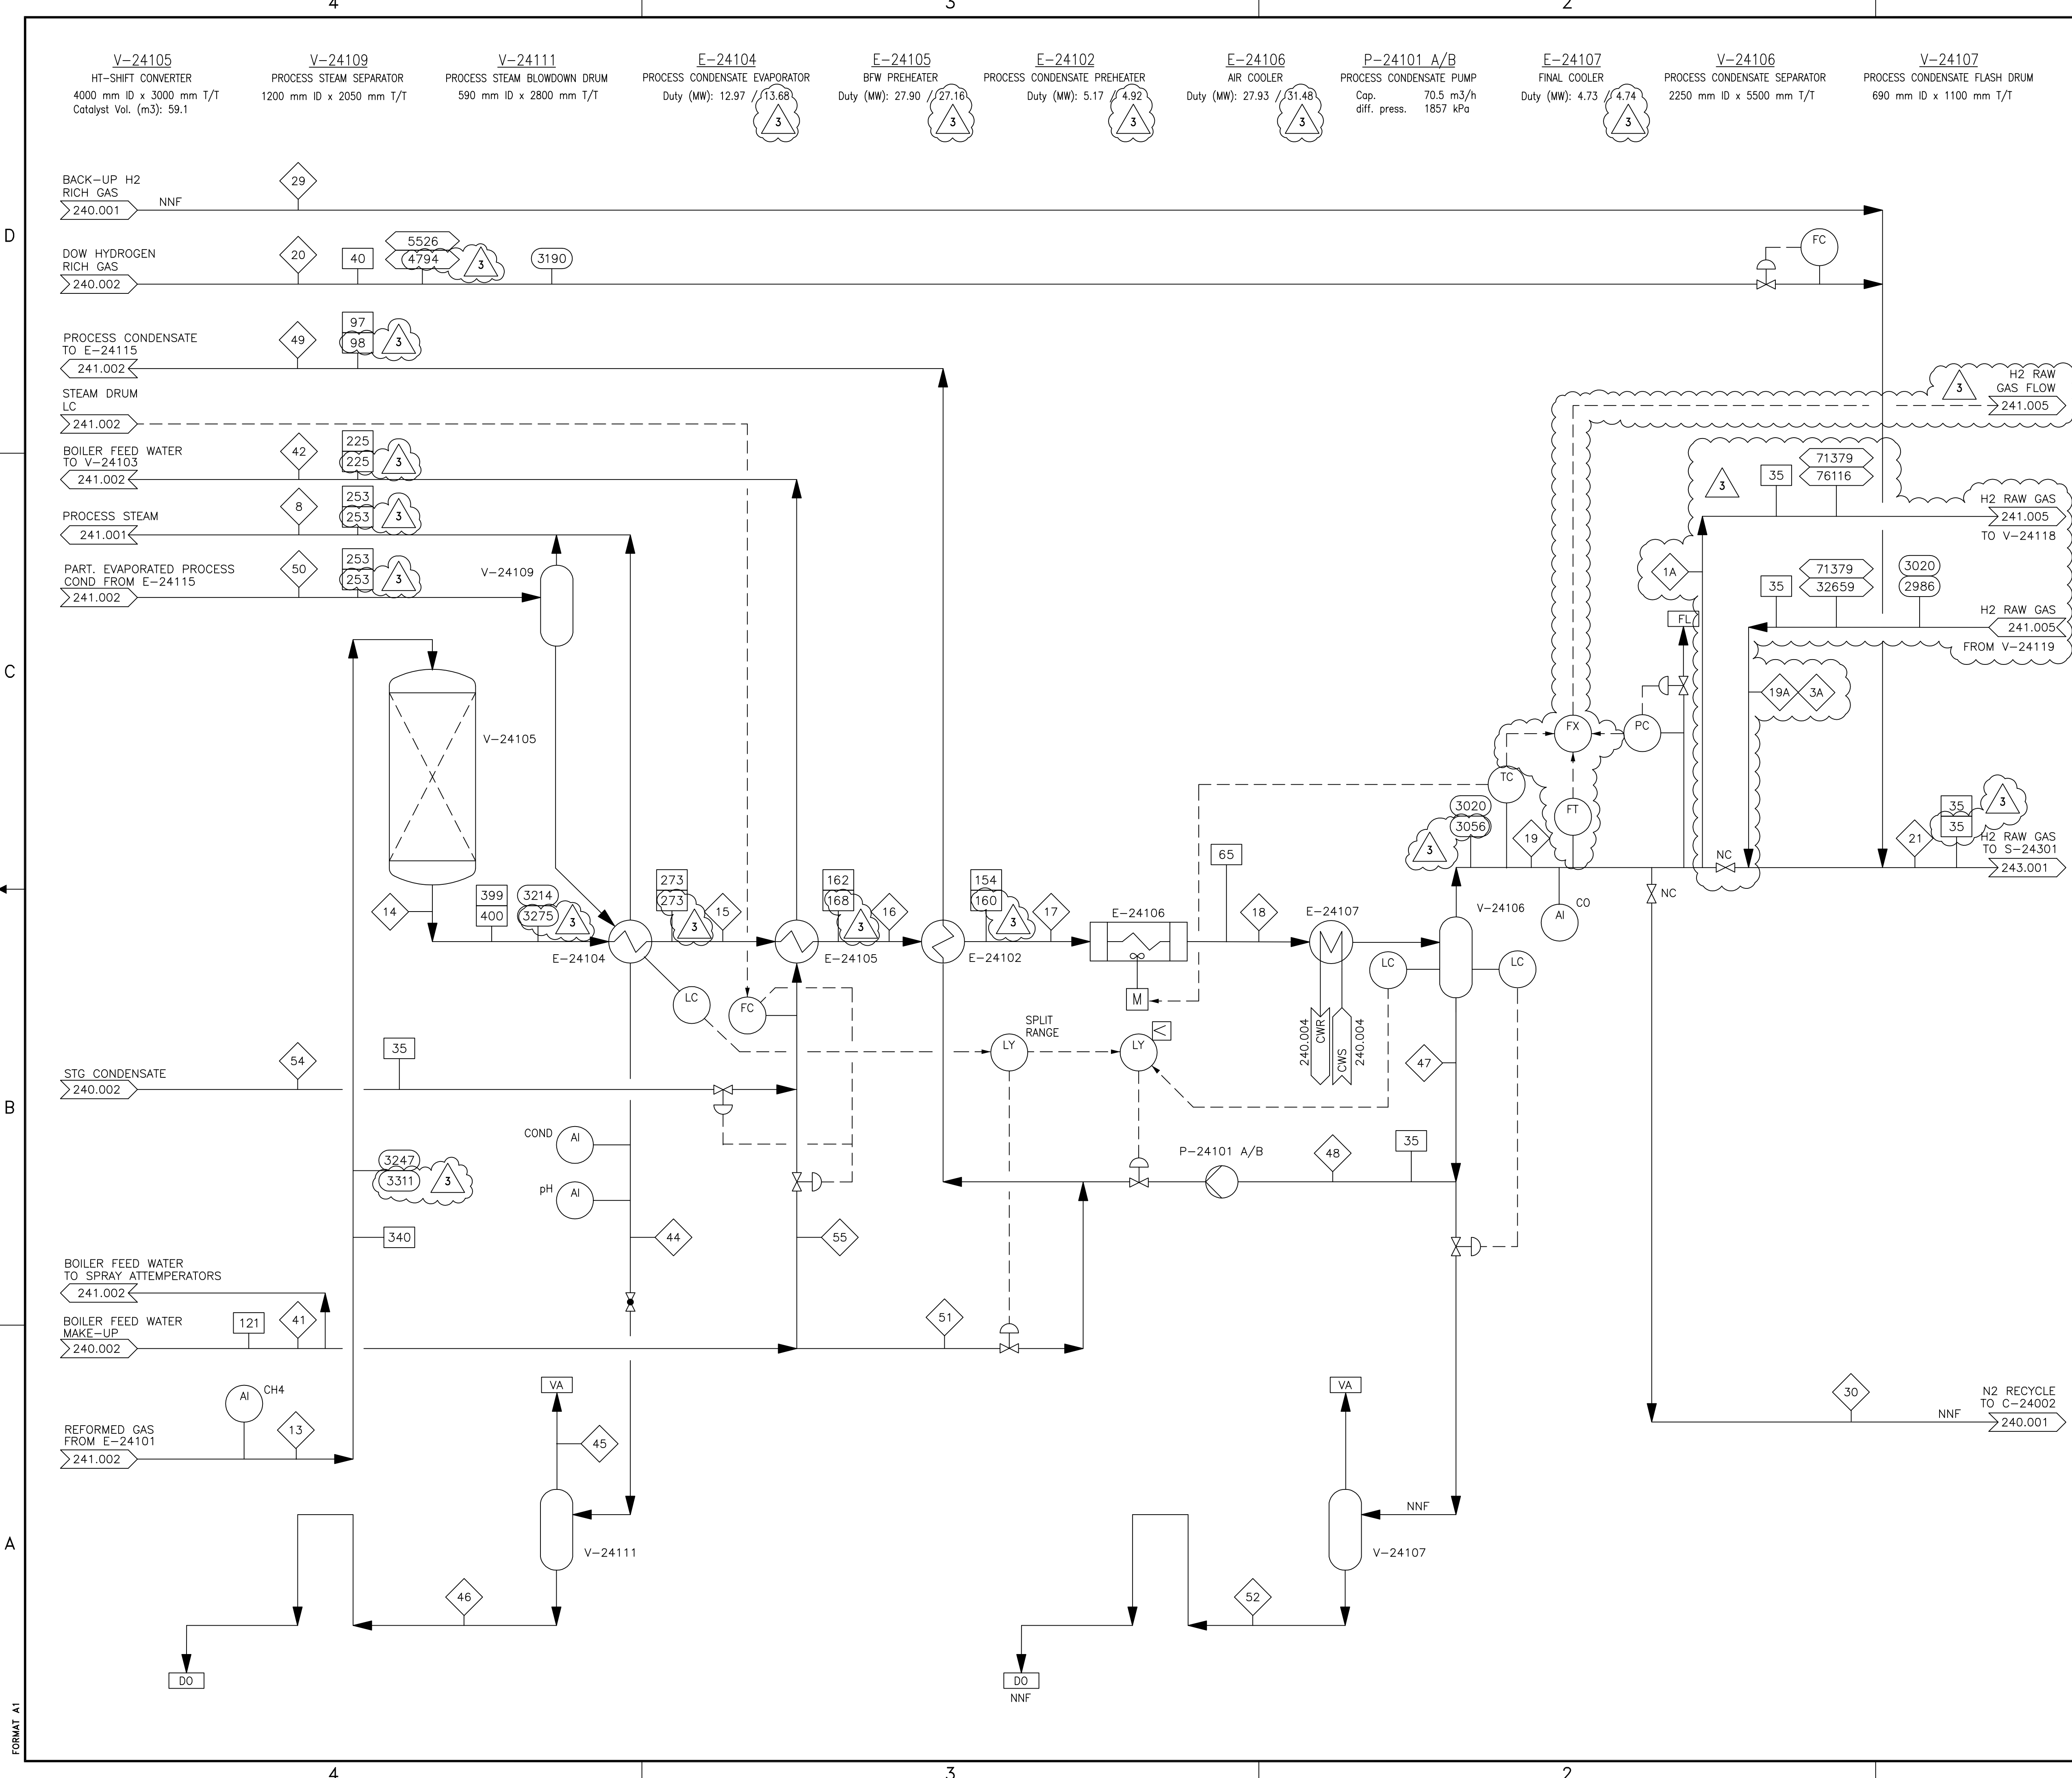

**NOTES**

1. FLOWS & DUTIES: CASE #2 / CASE #24.

CASE #2: H2 PRODUCTION WITH ADDITIONAL CHEMICAL FEED AND DOW GAS. FGR OFFLINE. CO2 RICH STREAM TO PSA.

CASE #24: H2 PRODUCTION WITH ADDITIONAL CHEMICAL FEED AND DOW GAS. FLUE GAS RECYCLE ONLINE AT 100% LOAD. CO2 LEAN STREAM TO PSA.

**REFERENCE**

	STREAM NUMBER
	TEMPERATURE - CASE #2 (°C) TEMPERATURE - CASE #24 (°C)
	PRESSURE - CASE #2 (kPa-a) PRESSURE - CASE #24 (kPa-a)
	FLOW - CASE #2 (kg/Hr) FLOW - CASE #24 (kg/Hr)
	Std. VOL. FLOW - CASE #2 (m <sup>3</sup> (st)/hr) Std. VOL. FLOW - CASE #24 (m <sup>3</sup> (st)/hr)

**ISSUED FOR CONSTRUCTION**  
21 Oct 2013

**FLUOR.** FLUOR'S RESPONSIBILITY IS LIMITED TO THE REVISION CONTENT SHOWN IN THIS DOCUMENT.

REV	ISSUED DATE	DESCRIPTION	DWN	CHKD	ENG	APP	APP	CLNT	APP
3	13 SEP 30	RE-ISSUED IFC ON NEXT HARD REV	GB	CC	LMF	KH	CV		
2C	12 DEC 21	ISSUED FOR CONSTRUCTION	GB	KB	LMF	KH	CV		
2B	11 AUG 31	RE-ISSUED FOR QUEST DESIGN	GB	SM	SM	JL	CV		10/98
2A	11 MAR 03	RE-ISSUED FOR QUEST DESIGN	GB	SM	BS	JL	CV		10/98
2	10 NOV 03	ISSUED FOR QUEST DESIGN	JH	SM	BS	JL	CV		10/98
1A	10 AUG 24	ISSUED FOR QUEST COARSE HAZOP	JH						
1	02 SEP 20	AS-BUILT	LWM	MWP	AAI	MWP			HRM
0	00 OCT 23	IFC: ISSUED FOR CONSTRUCTION	WZF	SW	SW	MWP	DLA		HRM

**SHELL CANADA LTD.**  
ATHABASCA OIL SANDS  
DOWNSTREAM PROJECT

PARSONS . KRUPP UHDE . TRI OCEAN


**PROCESS FLOW DIAGRAM**  
**HYDROGEN MANUFACTURING UNIT**  
**CO-CONVERSION COOLING TRAIN**

SCALE: NTS	TOE DWG. No.: 99049-1-DG-BB-00003.1
SHELL DWG NO.: 241.0001.000.040.003	REV. 3

FORMAT A1

0021-B9D



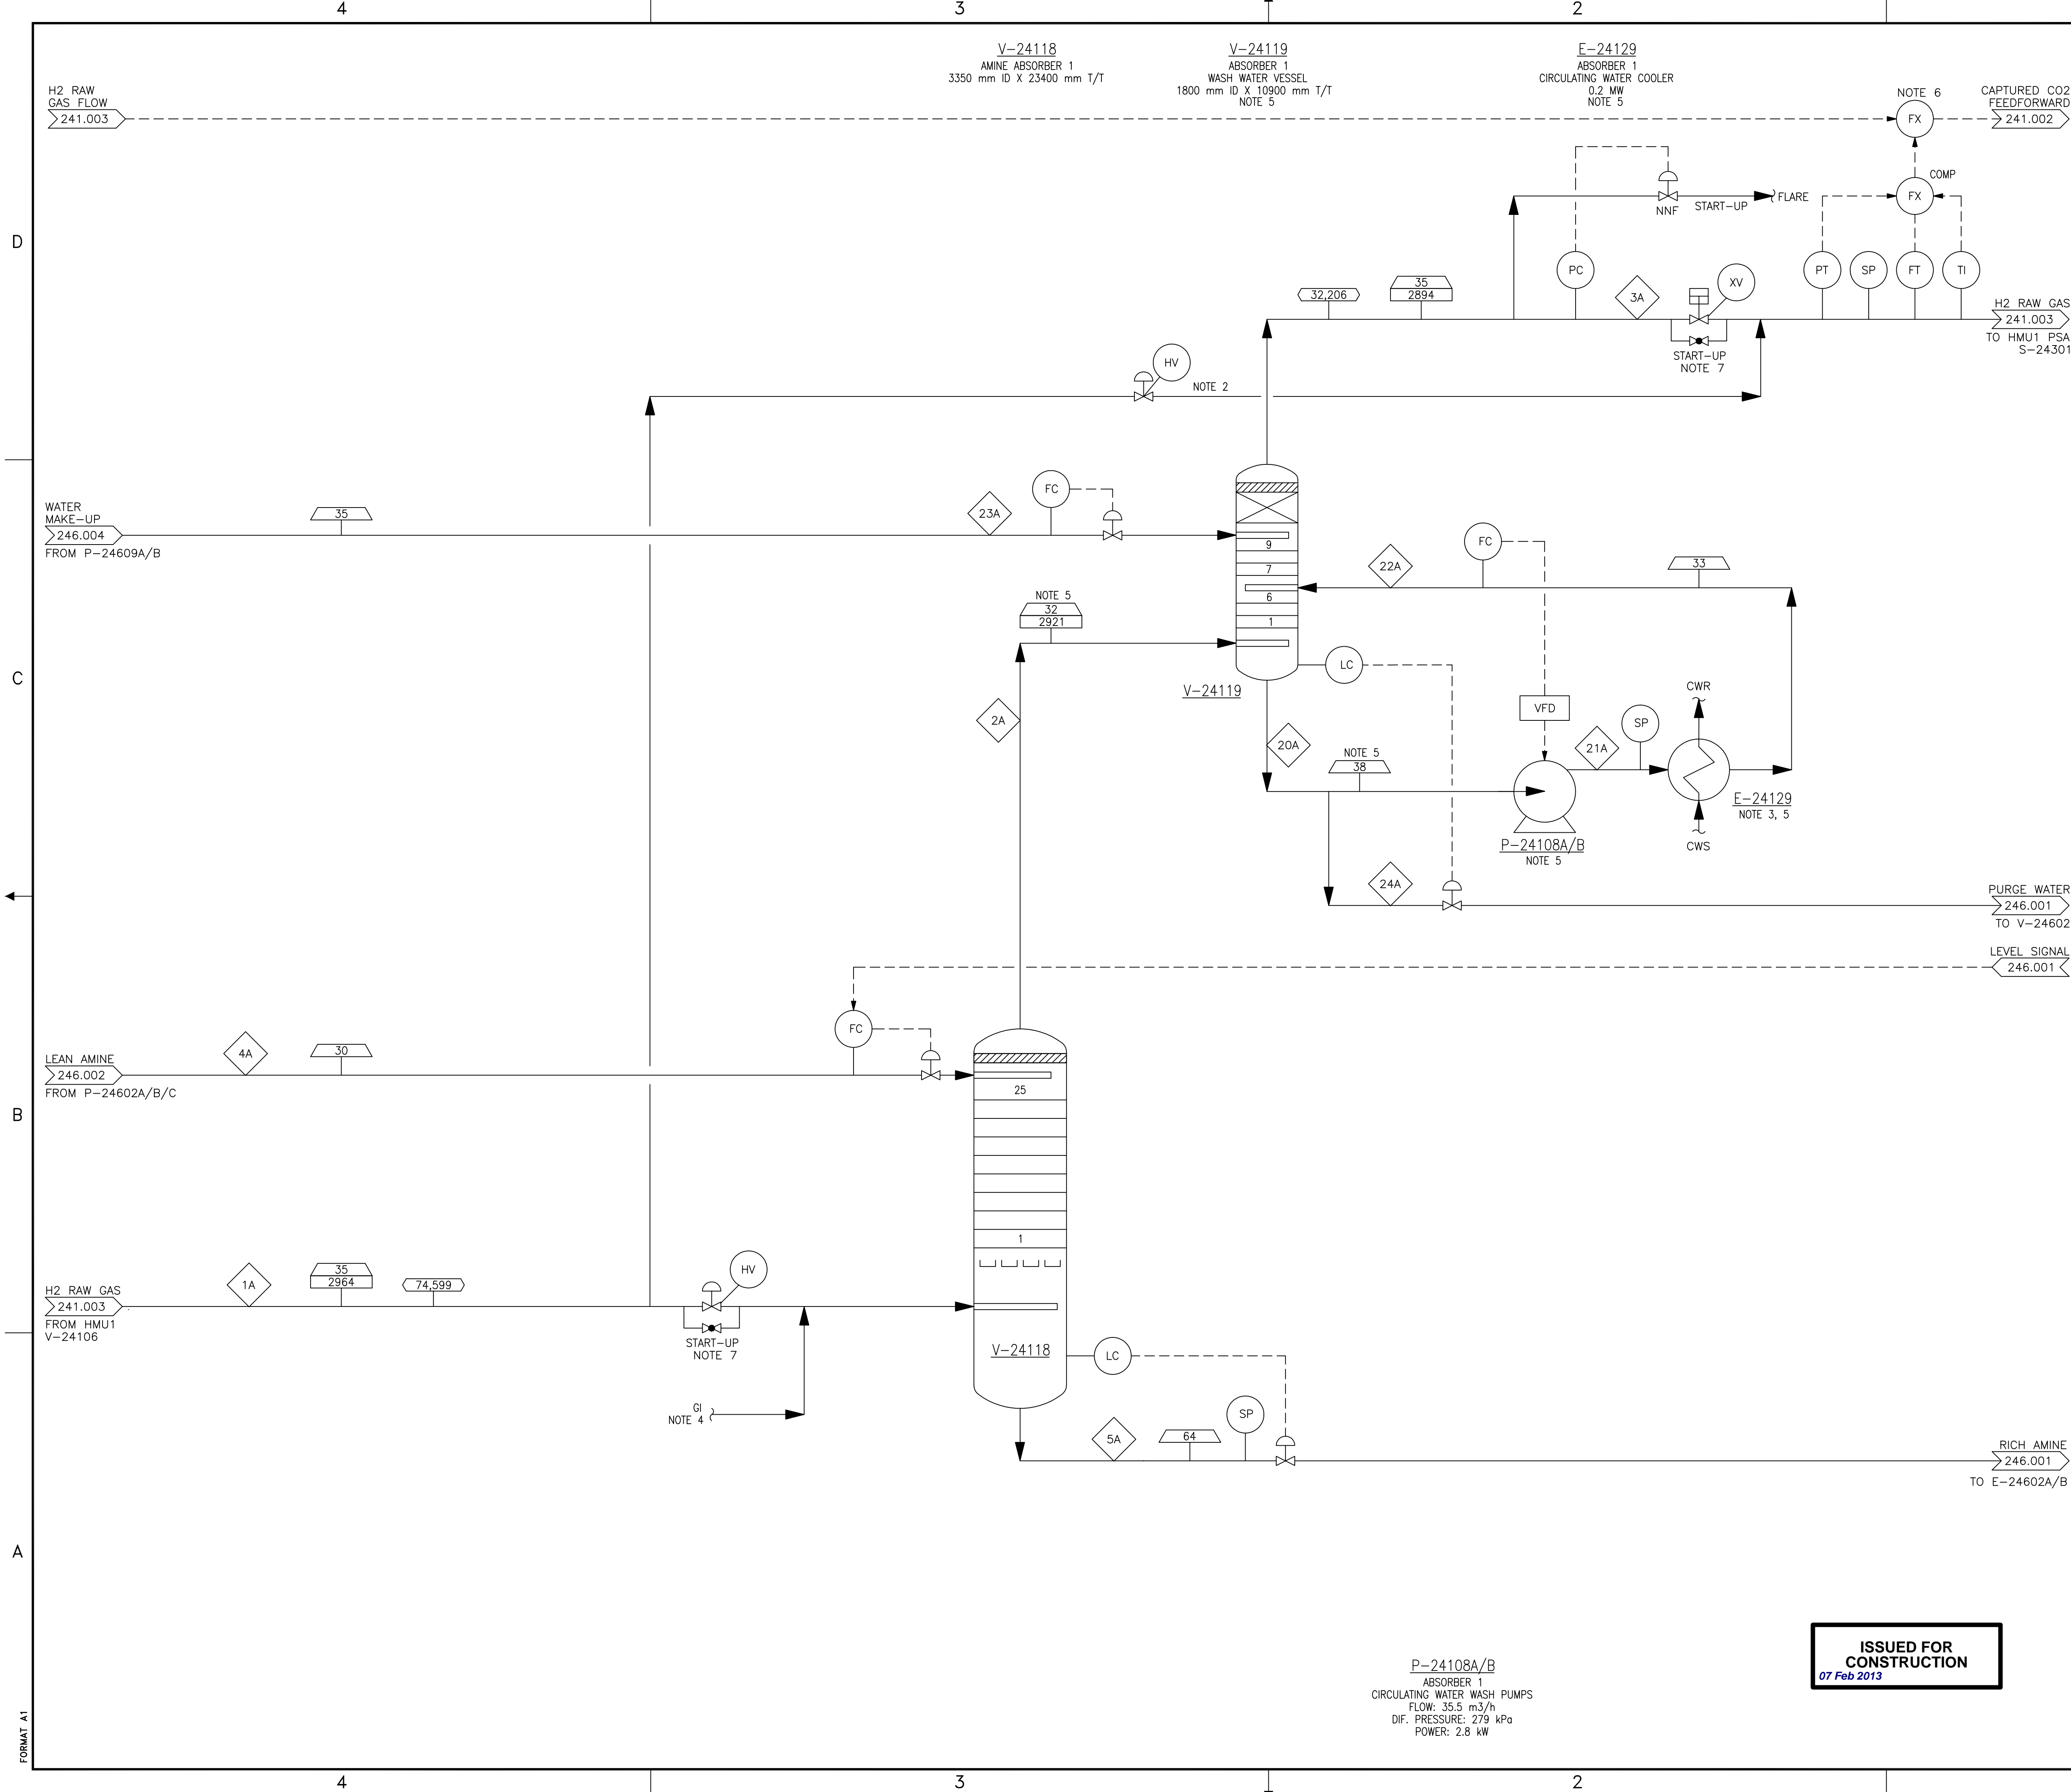

- NOTES**
- REFER TO HEAT AND MATERIAL BALANCE, DOCUMENT NUMBER 246.0001.000.046.001, FOR STREAM INFORMATION.
  - FEED GAS BYPASS AROUND THE HMU1 CO2 CAPTURE TRAIN.
  - COOLING WATER SOURCE IS HMU1 COOLING WATER SYSTEM. SOURCE TEMPERATURE IS 25°C FOR DESIGN.
  - NITROGEN PURGE FOR START-UP.
  - WATER WASH SECTION IS DESIGNED FOR A HIGHER TREATED GAS TEMPERATURE OF 39°C FROM THE AMINE ABSORBER.
  - CAPTURED CO2 CALCULATED AND USED AS AN INPUT TO CONTROL THE FLUE GAS RECIRCULATION FAN (C-24103).
  - H2 RAW GAS BYPASS FOR SYSTEM PURGE AND PRESSURIZATION AT START-UP.

- LEGEND**
- XXX STREAM NUMBER
  - XXX TEMPERATURE, °C
  - XXX PRESSURE, kPa<sub>g</sub>
  - XX,XXX FLOW, kg/h

REV	ISSUED DATE	DESCRIPTION	DWN	CHKD	ENG	APP	APP	CLNT APP
1	12/11/23	ISSUED FOR CONSTRUCTION	GB	KB	LMF	KH	CV	
0B	11/08/31	RE-ISSUED FOR DESIGN	GB	SM	KH	JI	CV	MD/SB
0A	11/03/01	RE-ISSUED FOR DESIGN	GB	SM	KH	JI	CV	MD/SB
0	10/11/08	ISSUED FOR DESIGN	JH	QC	KH	JI	CV	MD/SB

**ISSUED FOR CONSTRUCTION**  
07 Feb 2013

P-24108A/B  
ABSORBER 1  
CIRCULATING WATER WASH PUMPS  
FLOW: 35.5 m<sup>3</sup>/h  
DIF. PRESSURE: 279 kPa  
POWER: 2.8 kW

**SHELL CANADA**

**FLUOR**

PROCESS FLOW DIAGRAM  
QUEST CCS PROJECT  
HMU1 AMINE ABSORBER


SCALE: NONE	TOE DWG. No.:	
SHELL DWG NO.:	241.0001.000.040.005	REV. 1

FORMAT A1

FORMAT A1

**V-24201**  
HYDRODESULPHURIZATION REACTOR I  
2900 mm I.D. x 5600 mm T/T  
Catalyst Vol. (m<sup>3</sup>): 10.6 Hydrotreating  
5.0 Chloride Guard  
27.0 Desulphurization

**V-24202**  
HYDRODESULPHURIZATION REACTOR II  
2900 mm I.D. x 5600 mm T/T  
Catalyst Vol. (m<sup>3</sup>): 10.6 Hydrotreating  
5.0 Chloride Guard  
27.0 Desulphurization

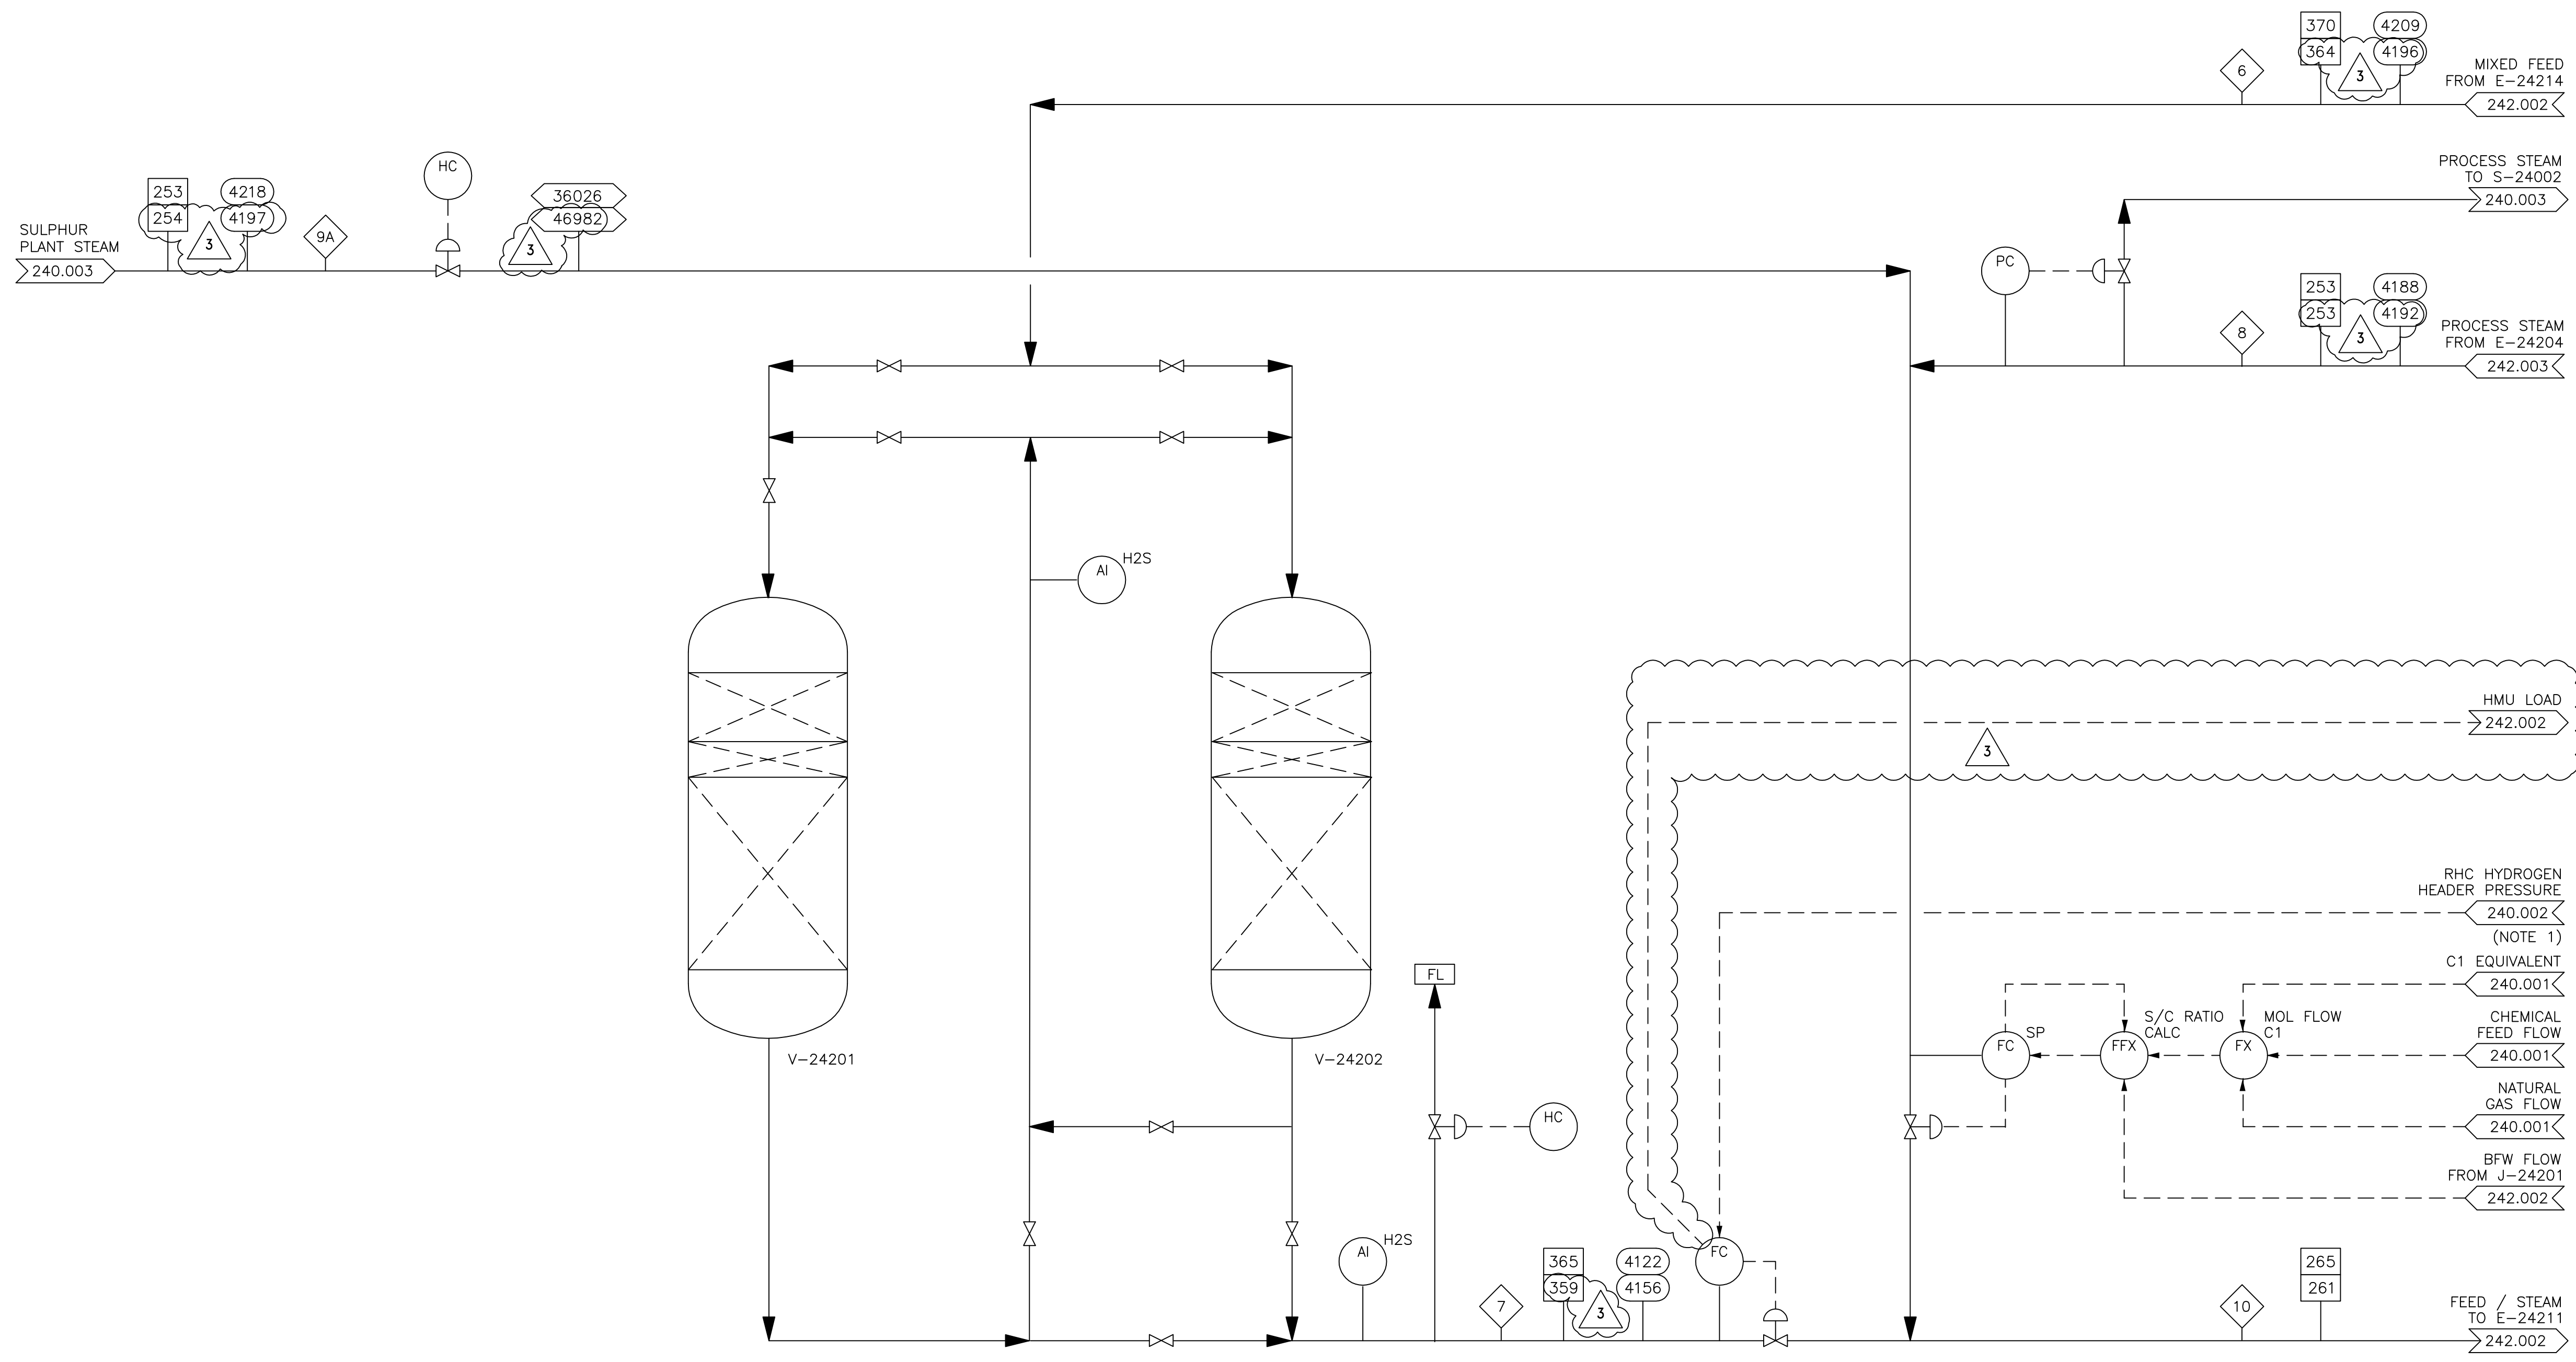

**NOTES**

1. HYDROGEN HEADER PRESSURE AT RHC WILL AUTOMATICALLY ADJUST HMU PRODUCTION. HMU IS RESPONSIBLE FOR ADJUSTMENT OF EACH HMU TRAIN BASED ON RHC HYDROGEN PRESSURE.
2. CASE #2: H<sub>2</sub> PRODUCTION WITH ADDITIONAL CHEMICAL FEED AND DOW GAS. FGR OFFLINE. CO<sub>2</sub> RICH STREAM TO PSA.
- CASE #24: H<sub>2</sub> PRODUCTION WITH ADDITIONAL CHEMICAL FEED AND DOW GAS. FLUE GAS RECYCLE ONLINE AT 100% LOAD. CO<sub>2</sub> LEAN STREAM TO PSA.

**REFERENCE**

- ◇ STREAM NUMBER
- TEMPERATURE - CASE #2 (°C)  
□ TEMPERATURE - CASE #24 (°C)
- PRESSURE - CASE #2 (kPa-a)  
○ PRESSURE - CASE #24 (kPa-a)
- ▭ FLOW - CASE #2 (kg/Hr)  
▭ FLOW - CASE #24 (kg/Hr)
- ▭ Std. VOL. FLOW - CASE #2 (m<sup>3</sup> (st)/hr)  
▭ Std. VOL. FLOW - CASE #24 (m<sup>3</sup> (st)/hr)

**ISSUED FOR CONSTRUCTION**  
21 Oct 2013

**FLUOR.** FLUOR'S RESPONSIBILITY IS LIMITED TO THE REVISION CONTENT SHOWN IN THIS DOCUMENT.

3	13 SEP 30	RE-ISSUED IFC ON NEXT HARD REV	GB	CC	LMF	KH	CV	
2C	13 JAN 09	ISSUED FOR CONSTRUCTION	GB	KB	LMF	KH	CV	
2B	11 AUG 31	RE-ISSUED FOR QUEST DESIGN	GB	SM	SM	JL	CV	M/98
2A	11 MAR 04	RE-ISSUED FOR QUEST DESIGN	GB	SM	BS	JL	CV	M/98
2	10 NOV 03	ISSUED FOR QUEST DESIGN	JH	SM	BS	JL	CV	M/98
1A	10 AUG 24	ISSUED FOR QUEST COARSE HAZOP	JH					
1	02 SEP 20	AS-BUILT	LWM	MWP	AAI	MWP		HRM
0	00 OCT 23	IFC: ISSUED FOR CONSTRUCTION	WZF	SW	SW	MWP	DLA	HRM
REV	ISSUED DATE	DESCRIPTION	DWN	CHKD	ENG	APP	APP	CLNT APP


**SHELL CANADA LTD.**  
ATHABASCA OIL SANDS  
DOWNSTREAM PROJECT  
PARSONS . KRUPP UHDE . TRI OCEAN

**PROCESS FLOW DIAGRAM**  
HYDROGEN MANUFACTURING UNIT  
FEED GAS DESULPHURIZATION

SCALE: NTS TOE DWG. No.: 99049-2-DG-BB-00001.1  
SHELL DWG NO.: 242.0001.000.040.001 REV. 3

0011-F8E



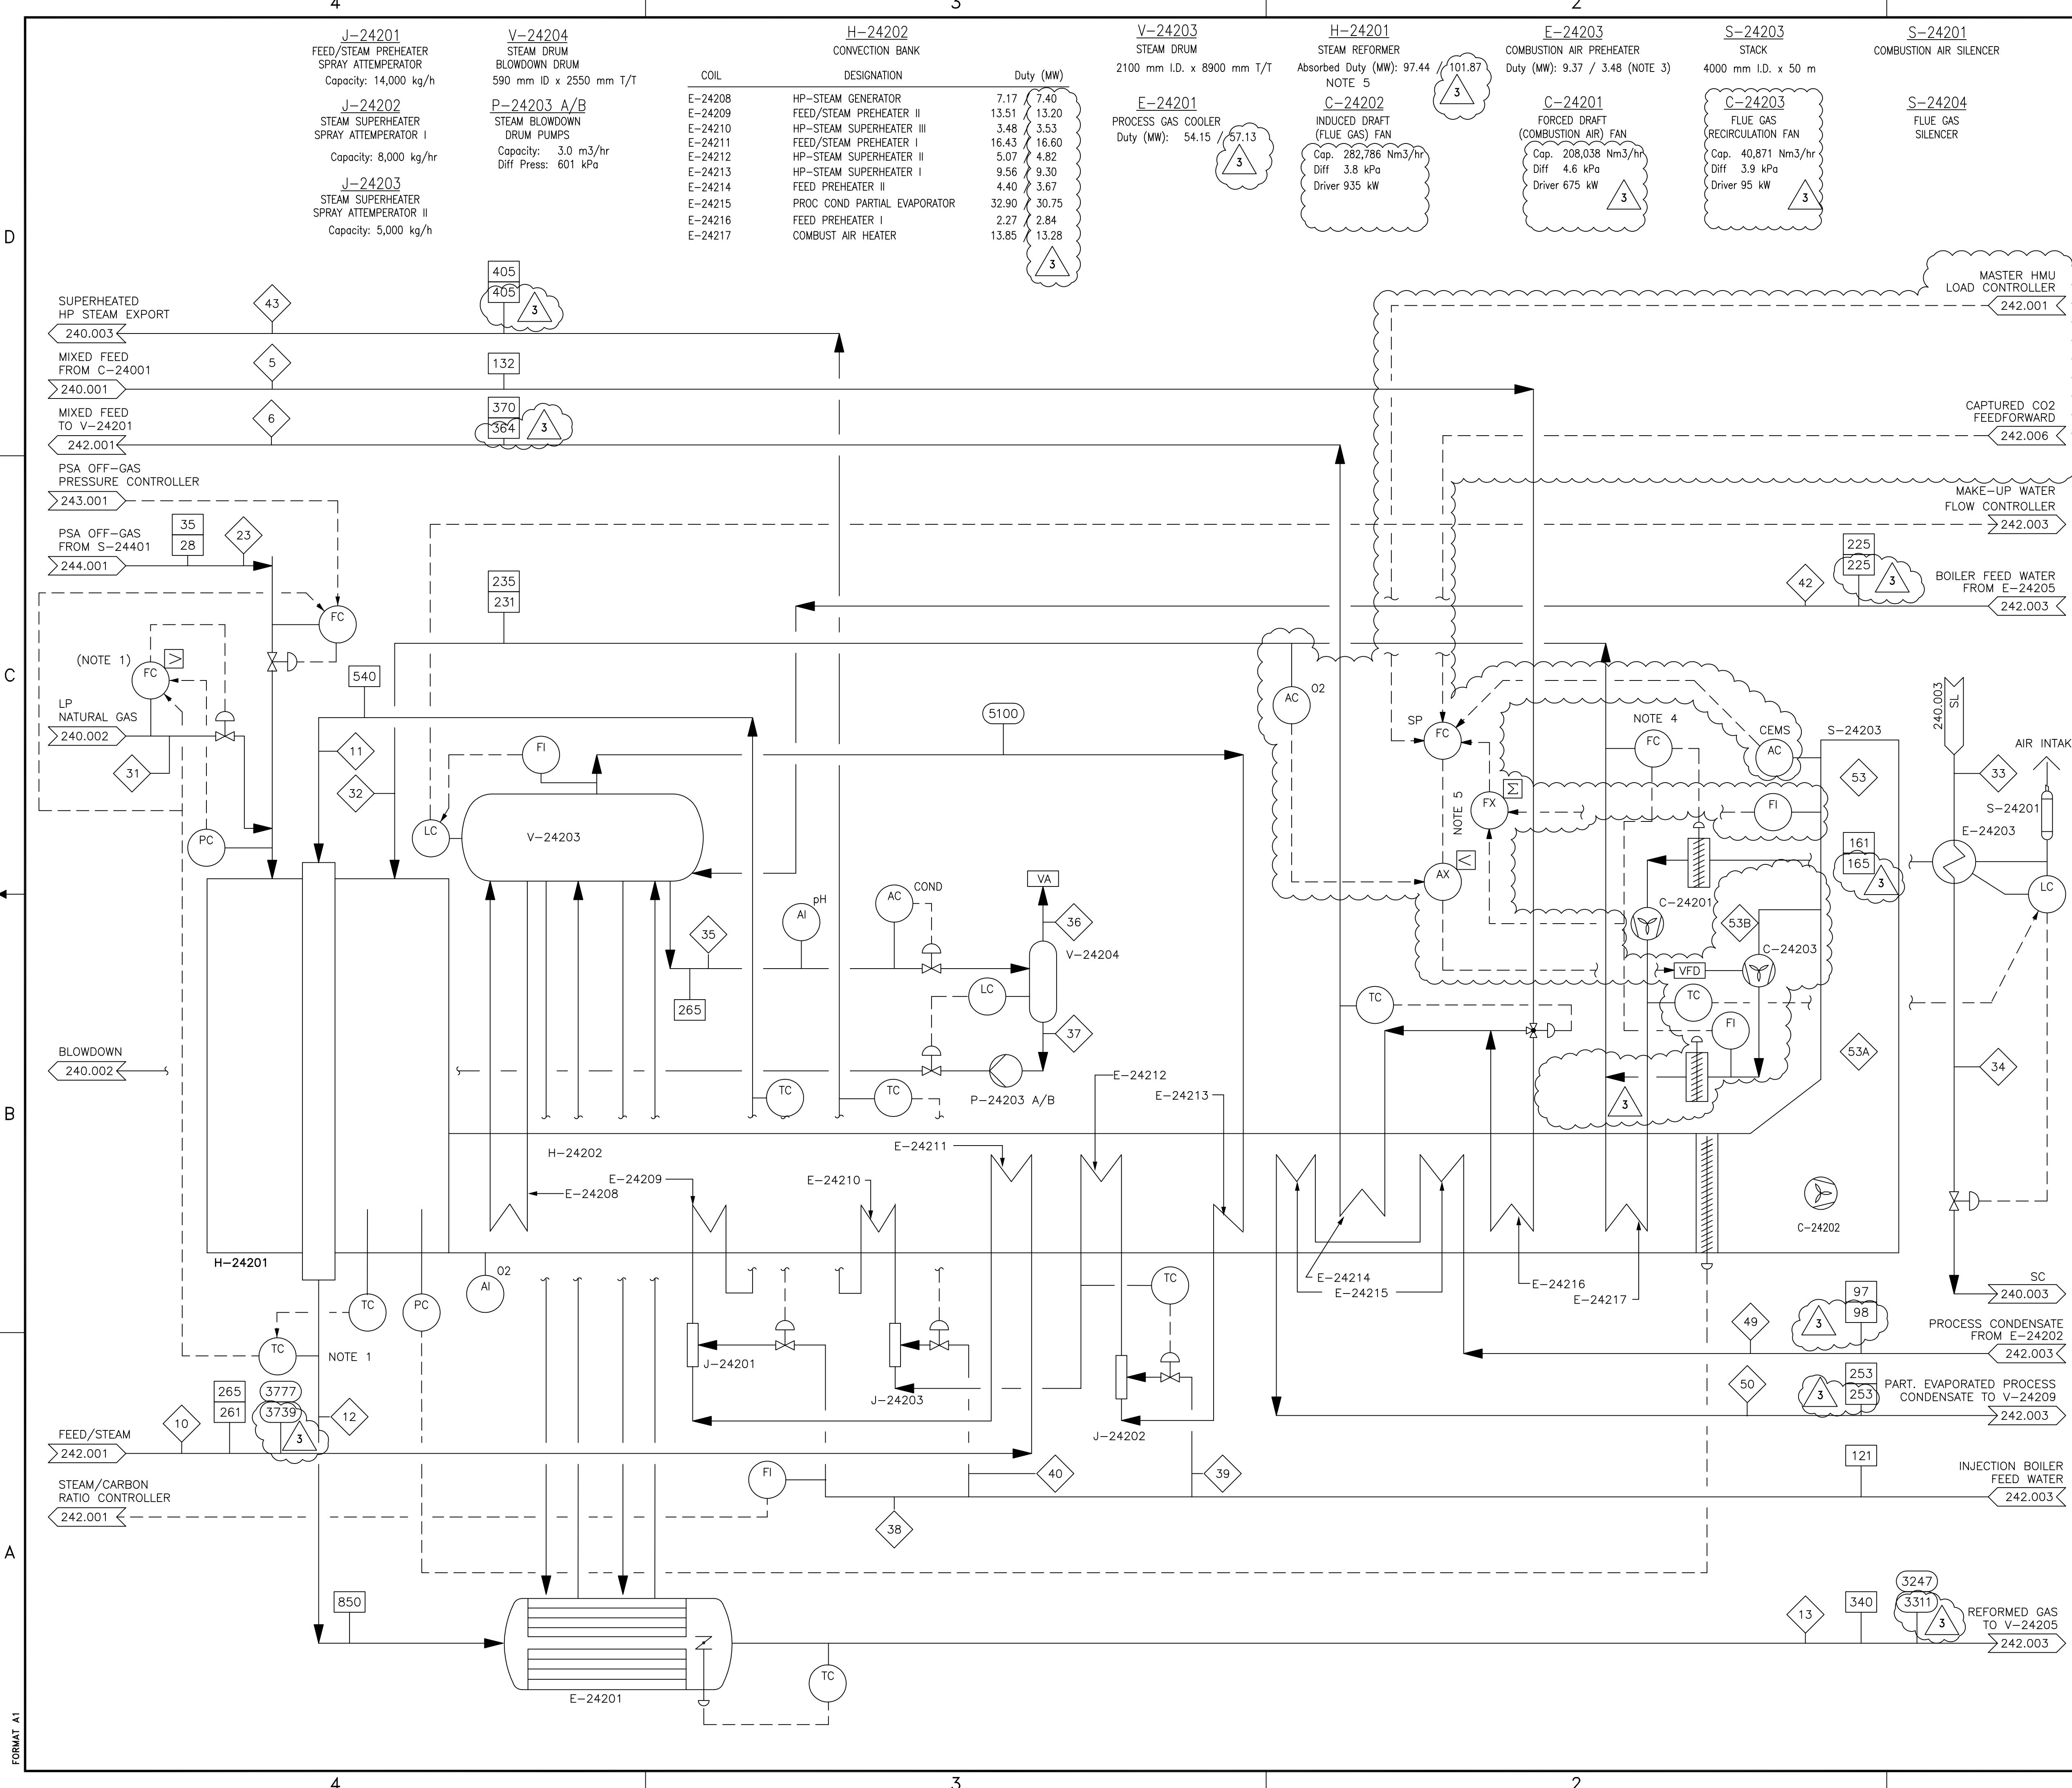

COIL	DESIGNATION	Duty (MW)	
E-24208	HP-STEAM GENERATOR	7.17	7.40
E-24209	FEED/STEAM PREHEATER II	13.51	13.20
E-24210	HP-STEAM SUPERHEATER III	3.48	3.53
E-24211	FEED/STEAM PREHEATER I	16.43	16.60
E-24212	HP-STEAM SUPERHEATER II	5.07	4.82
E-24213	HP-STEAM SUPERHEATER I	9.56	9.30
E-24214	FEED PREHEATER II	4.40	3.67
E-24215	PROC COND PARTIAL EVAPORATOR	32.90	30.75
E-24216	FEED PREHEATER I	2.27	2.84
E-24217	COMBUST AIR HEATER	13.85	13.28

- NOTES**
- PROCESS SIDE TEMPERATURE IS CONTROLLED, WITH CHANGES IN FLUE GAS TEMPERATURE USED TO INITIATE NATURAL GAS FLOW CHANGES TO MINIMIZE DEVIATIONS IN THE PROCESS TEMPERATURE.
  - FLOWS & DUTIES: CASE #2 / CASE #24.
  - CASE #2: H2 PRODUCTION WITH ADDITIONAL CHEMICAL FEED AND DOW GAS. FGR OFFLINE. CO2 RICH STREAM TO PSA.
  - CASE #24: H2 PRODUCTION WITH ADDITIONAL CHEMICAL FEED AND DOW GAS. FLUE GAS RECYCLE ONLINE AT 100% LOAD. CO2 LEAN STREAM TO PSA.
  - DUTY WINTER/SUMMER: FOR CASE #2.
  - FLOW CONTROL ON COMBUSTION AIR WITH TRIM FROM EXCESS O2 AT BURNER OUTLET.
  - FLUE GAS RECIRCULATION FAN CONTROLLED BY TOTAL CONVECTION SECTION FLOW WITH FEEDFORWARD FROM CO2 CAPTURED.

- REFERENCE**
- ◇ STREAM NUMBER
  - TEMPERATURE - CASE #2 (°C)  
□ TEMPERATURE - CASE #24 (°C)
  - PRESSURE - CASE #2 (kPa-a)  
○ PRESSURE - CASE #24 (kPa-a)
  - ▬ FLOW - CASE #2 (kg/Hr)  
▬ FLOW - CASE #24 (kg/Hr)
  - ▬ Std. VOL. FLOW - CASE #2 (m<sup>3</sup> (st)/hr)  
▬ Std. VOL. FLOW - CASE #24 (m<sup>3</sup> (st)/hr)

**ISSUED FOR CONSTRUCTION**  
21 Oct 2013

**FLUOR.** FLUOR'S RESPONSIBILITY IS LIMITED TO THE REVISION CONTENT SHOWN IN THIS DOCUMENT.

REV	ISSUED DATE	DESCRIPTION	DWN	CHKD	ENG	APP	APP	CLNT	APP
3	13 SEP 30	RE-ISSUED IFC ON NEXT HARD REV	GB	CC	LMF	KH	CV		
2C	13 JAN 09	ISSUED FOR CONSTRUCTION	GB	KB	LMF	KH	CV		
2B	11 AUG 31	RE-ISSUED FOR QUEST DESIGN	GB	SM	SM	JL	CV		
2A	11 MAR 04	RE-ISSUED FOR QUEST DESIGN	GB	SM	BS	JL	CV		
2	10 NOV 03	ISSUED FOR QUEST DESIGN	JH	SM	BS	JL	CV		
1A	10 AUG 24	ISSUED FOR QUEST COARSE HAZOP	JH						
1	02 SEP 20	AS-BUILT	LWM	MWP	AAI	MWP	HRM		
0	00 OCT 23	IFC: ISSUED FOR CONSTRUCTION	WZF	SW	SW	MWP	DLA	HRM	

**SHELL CANADA LTD.**  
ATHABASCA OIL SANDS  
DOWNSTREAM PROJECT

PARSONS . KRUPP UHDE . TRI OCEAN


**PROCESS FLOW DIAGRAM**  
HYDROGEN MANUFACTURING UNIT  
STEAM REFORMING

SCALE: NTS TOE DWG. No.: 99049-2-DG-BB-00002.1  
SHELL DWG NO.: 242.0001.000.040.002 REV. 3

FORMAT A1

0021-FG5



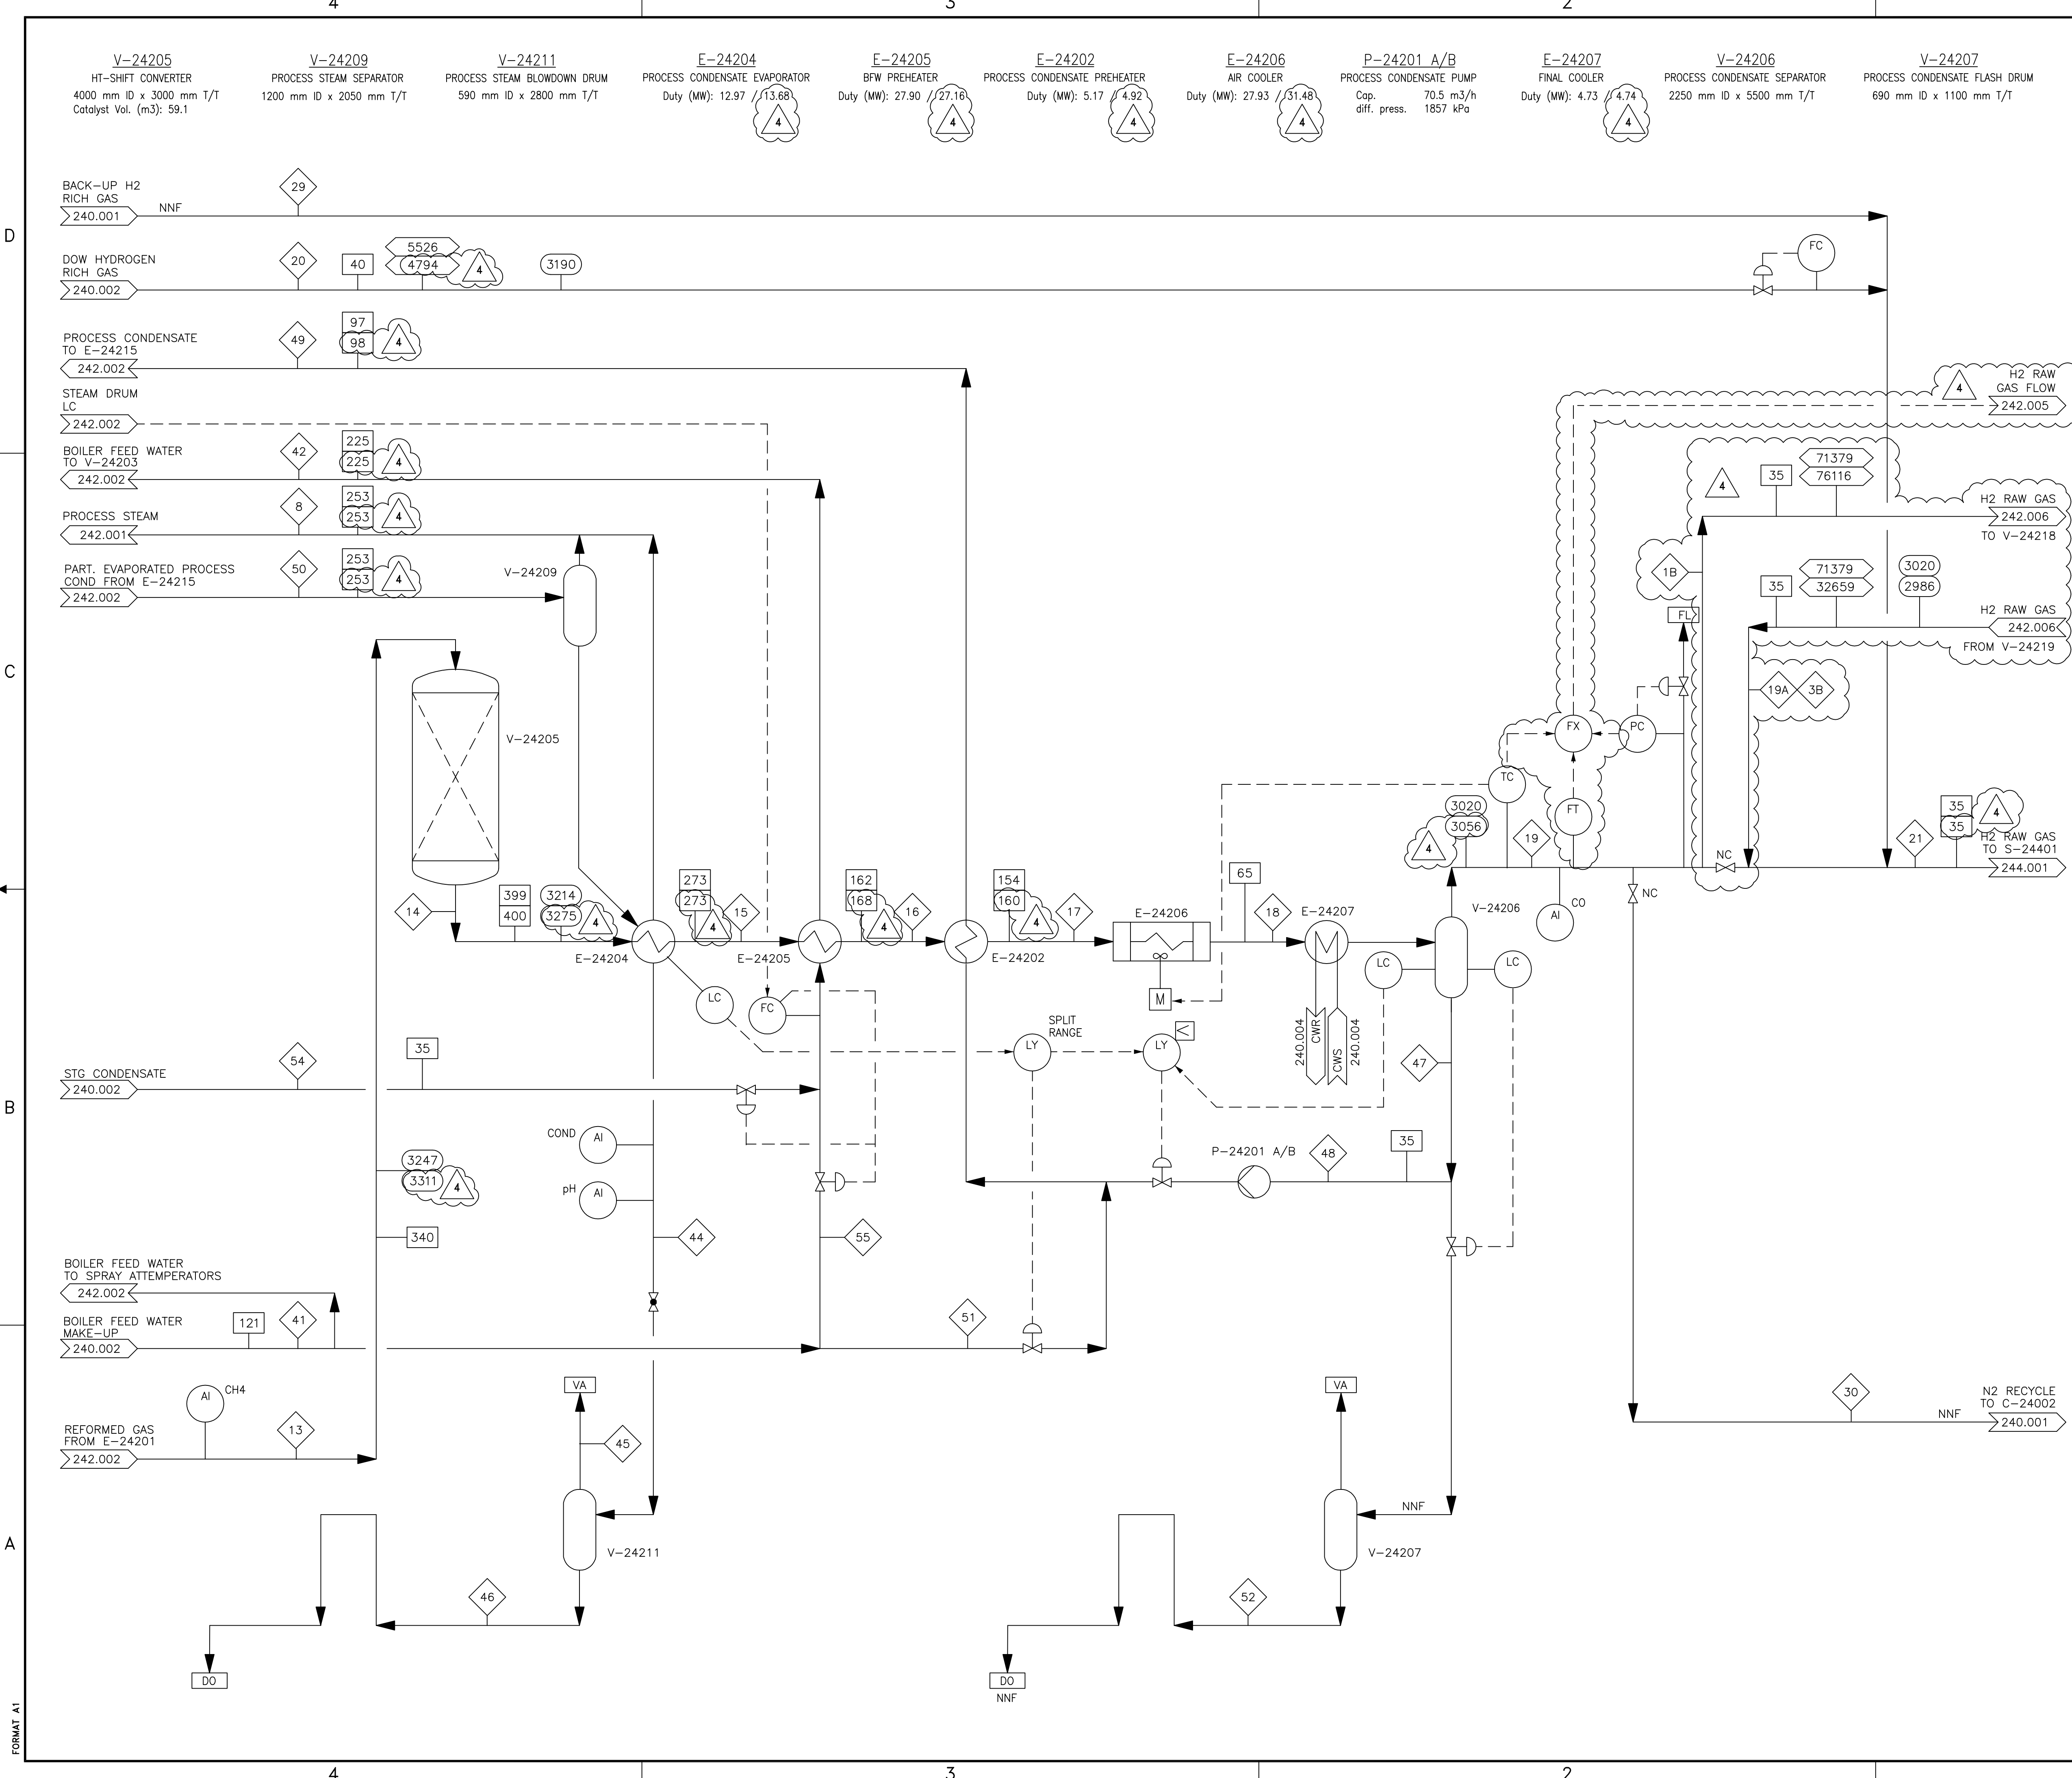

**NOTES**

1. FLOWS & DUTIES: CASE #2 / CASE #24.

CASE #2: H2 PRODUCTION WITH ADDITIONAL CHEMICAL FEED AND DOW GAS. FGR OFFLINE. CO2 RICH STREAM TO PSA.

CASE #24: H2 PRODUCTION WITH ADDITIONAL CHEMICAL FEED AND DOW GAS. FLUE GAS RECYCLE ONLINE AT 100% LOAD. CO2 LEAN STREAM TO PSA.

**REFERENCE**

◇ STREAM NUMBER

□ TEMPERATURE - CASE #2 (°C)  
□ TEMPERATURE - CASE #24 (°C)

○ PRESSURE - CASE #2 (kPa-a)  
○ PRESSURE - CASE #24 (kPa-a)

▬ FLOW - CASE #2 (kg/hr)  
▬ FLOW - CASE #24 (kg/hr)

▬ Std. VOL. FLOW - CASE #2 (m<sup>3</sup> (st)/hr)  
▬ Std. VOL. FLOW - CASE #24 (m<sup>3</sup> (st)/hr)


**ISSUED FOR CONSTRUCTION**  
21 Oct 2013

**FLUOR.** FLUOR'S RESPONSIBILITY IS LIMITED TO THE REVISION CONTENT SHOWN IN THIS DOCUMENT.

REV	ISSUED DATE	DESCRIPTION	DWN	CHKD	ENG	APP	APP	CLNT	APP
4	13 SEP 30	RE-ISSUED IFC ON NEXT HARD REV	GB	CC	LMF	KH	CV		
3C	13 JAN 09	ISSUED FOR CONSTRUCTION	GB	KB	LMF	KH	CV		
3B	11 AUG 31	RE-ISSUED FOR QUEST DESIGN	GB	SM	SM	JL	CV	WJ/SB	
3A	11 MAR 03	RE-ISSUED FOR QUEST DESIGN	GB	SM	BS	JL	CV	WJ/SB	
3	10 NOV 03	ISSUED FOR QUEST DESIGN	JH	SM	BS	JL	CV	WJ/SB	
2A	10 AUG 24	ISSUED FOR QUEST COARSE HAZOP	JH						
2	02 SEP 20	AS-BUILT	LWM	MWP	AAI	MWP			HRM
1	01 MAY 31	IFC: ISSUED FOR CONSTRUCTION	LWM	EG	RAMC	MWP			DCL

DRAWING REVISION "0"  
AFFIXED WITH P.ENG.  
STAMP ON 00.10.16  
AND STAMPED BY:  
ROBERT A. MACDONALD.

FULL SIZE VERSION OF THIS DRAWING  
STAMPED WITH PERMIT TO PRACTICE  
AT REV.0

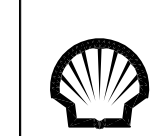

**SHELL CANADA LTD.**  
ATHABASCA OIL SANDS  
DOWNSTREAM PROJECT


PARSONS . KRUPP UHDE . TRI OCEAN

**PROCESS FLOW DIAGRAM**  
HYDROGEN MANUFACTURING UNIT  
CO-CONVERSION COOLING TRAIN

SCALE: NTS TOE DWG. No.: 99049-2-DG-BB-00003.1  
SHELL DWG NO.: 242.0001.000.040.003 REV. 4

FORMAT A1

0031-FBI

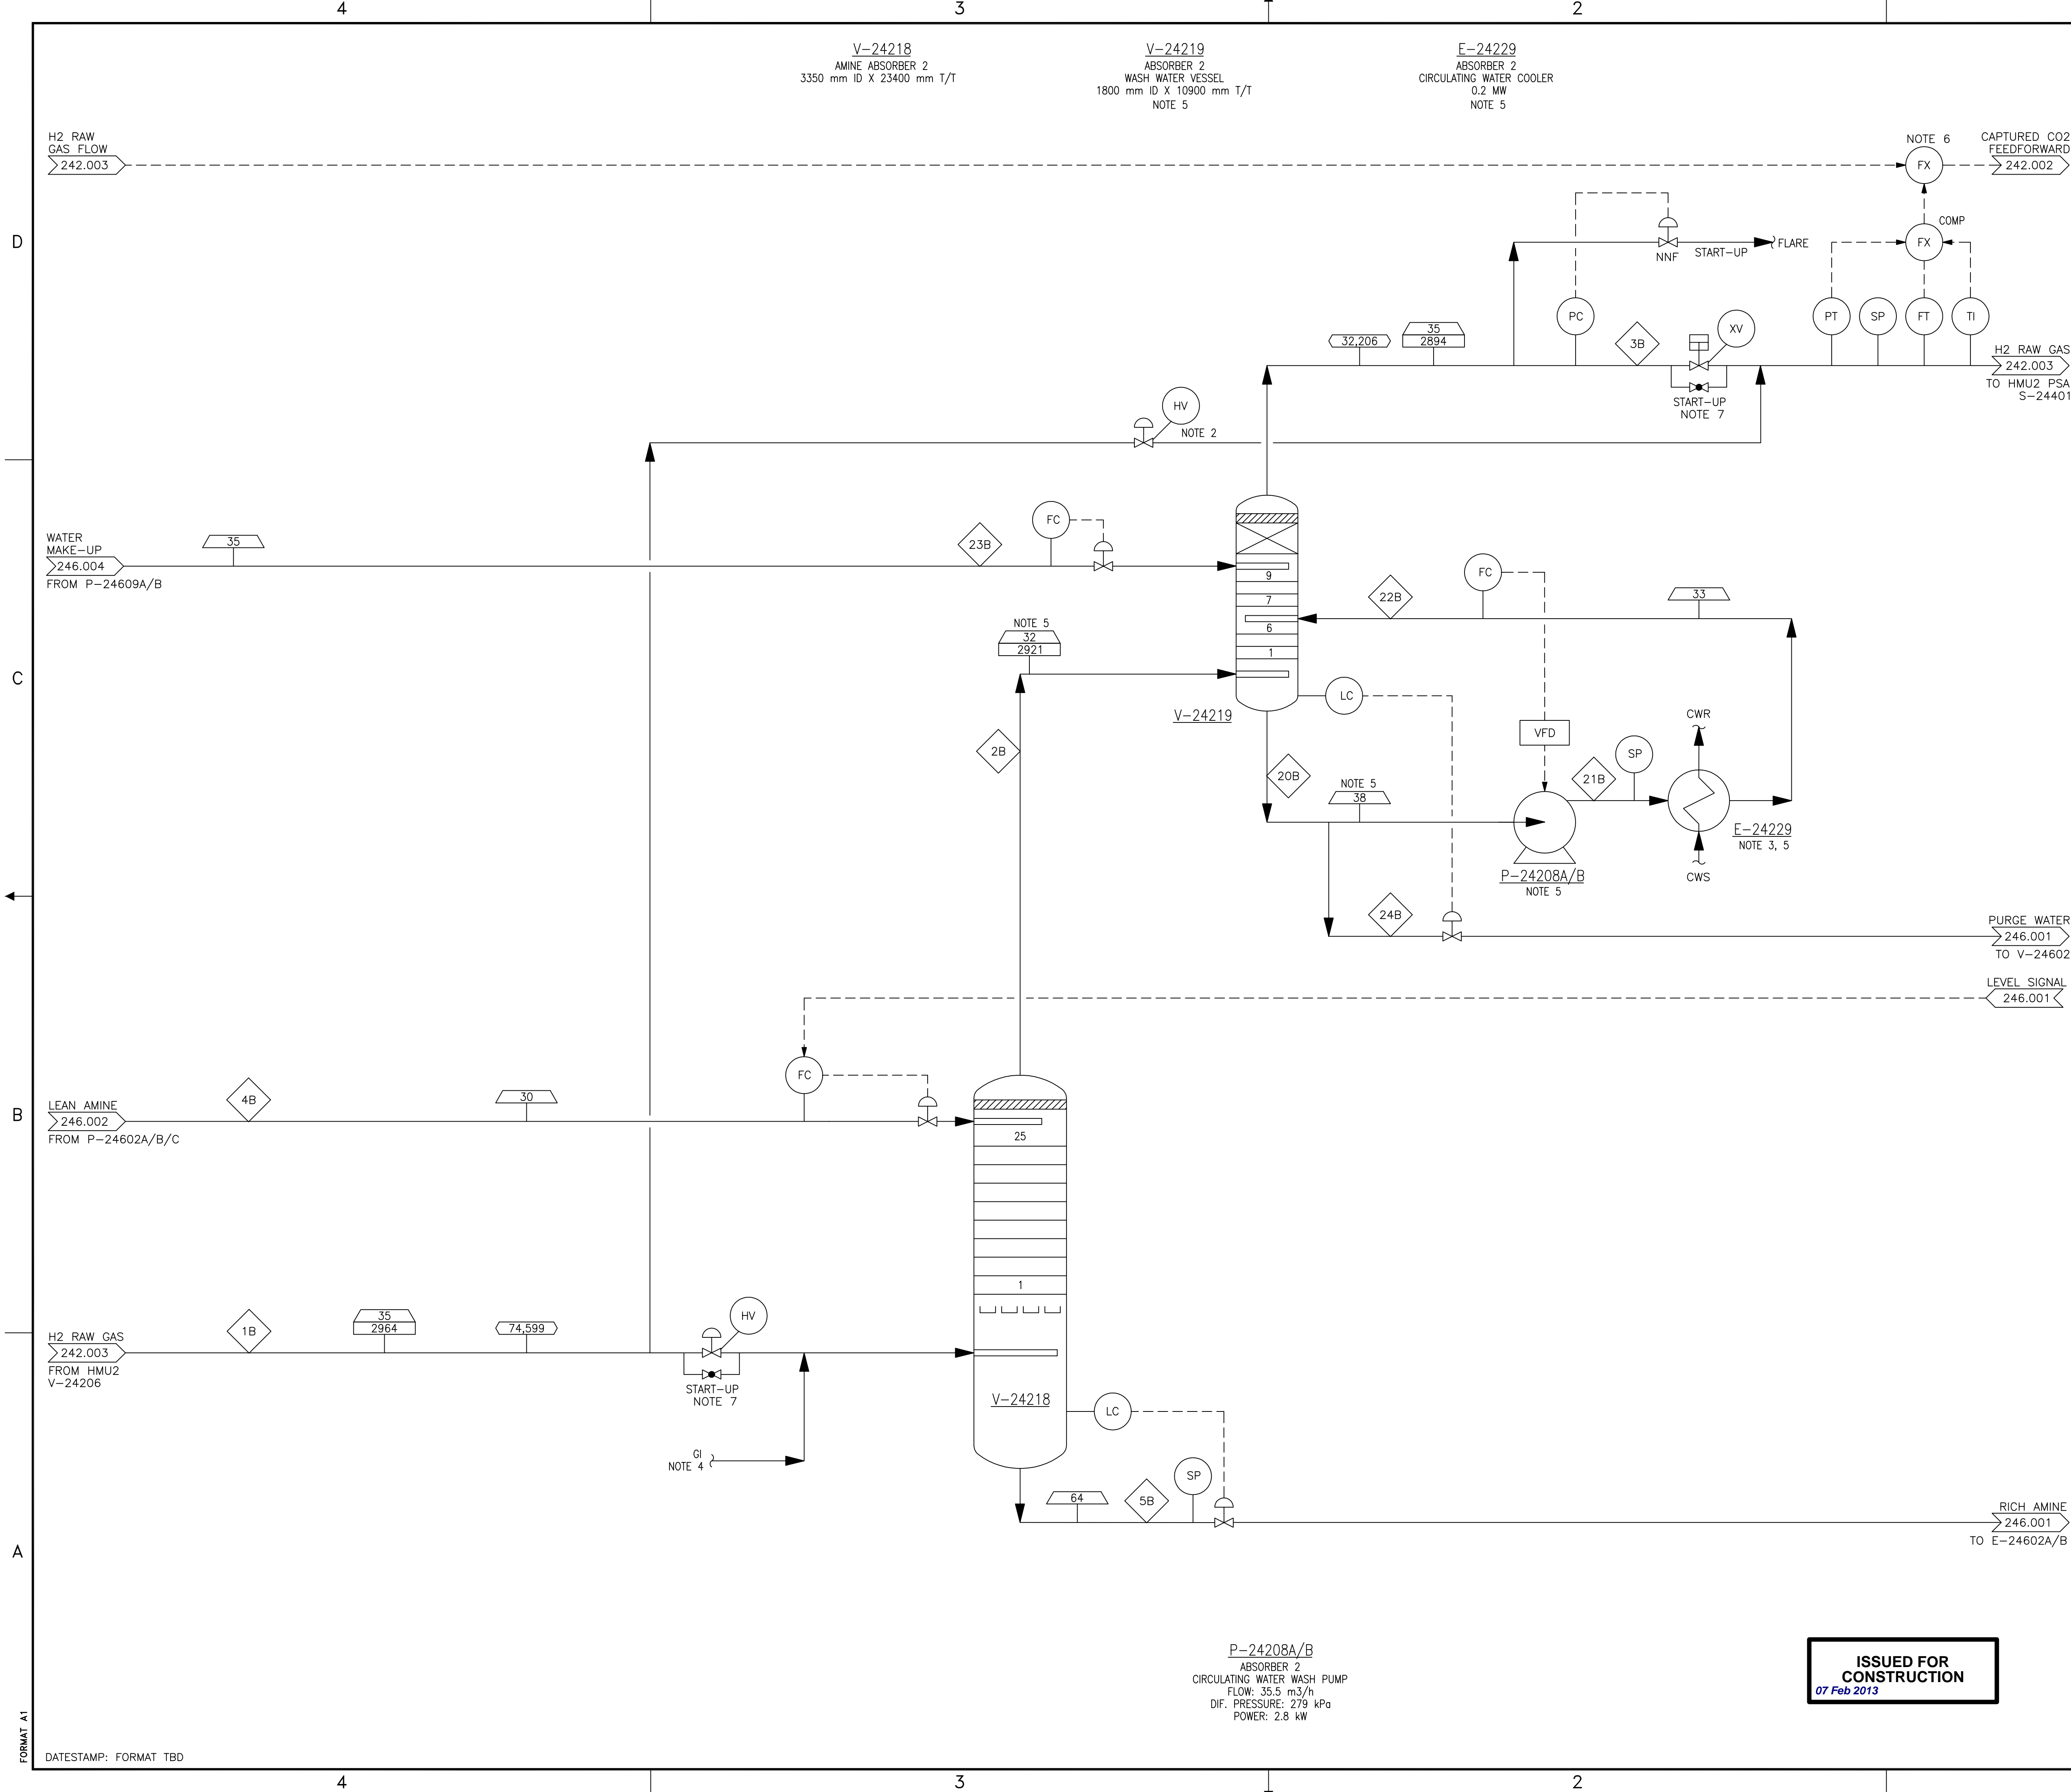

- NOTES**
- REFER TO HEAT AND MATERIAL BALANCE, DOCUMENT NUMBER 246.0001.000.046.001, FOR STREAM INFORMATION.
  - FEED GAS BYPASS AROUND HMU2 CO2 CAPTURE TRAIN.
  - COOLING WATER SOURCE IS HMU2 COOLING WATER SYSTEM. SOURCE TEMPERATURE IS 25°C FOR DESIGN.
  - NITROGEN PURGE FOR START-UP.
  - WATER WASH SECTION IS DESIGNED FOR A HIGHER TREATED GAS TEMPERATURE OF 39°C FROM THE AMINE ABSORBER.
  - CAPTURED CO2 CALCULATED AND USED AS AN INPUT TO CONTROL THE FLUE GAS RECIRCULATION FAN (C-24203).
  - H2 RAW GAS BYPASS FOR SYSTEM PURGE AND PRESSURIZATION AT START-UP.

- LEGEND**
- XXX STREAM NUMBER
  - XXX TEMPERATURE, °C
  - XXX PRESSURE, kPag
  - XX,XXX FLOW, kg/h

REV	ISSUED DATE	DESCRIPTION	DWN	CHKD	ENG	APP	APP	CLNT	APP
1	12/11/23	ISSUED FOR CONSTRUCTION	GB	KB	LMF	KH	CV		
0B	11/08/31	RE-ISSUED FOR DESIGN	GB	SM	KH	JI	CV	MD/SB	
0A	11/03/01	RE-ISSUED FOR DESIGN	GB	SM	KH	JI	CV	MD/SB	
0	10/11/08	ISSUED FOR DESIGN	JH	QC	KH	JI	CV	MD/SB	

**SHELL CANADA**

**FLUOR**

PROCESS FLOW DIAGRAM  
QUEST CCS PROJECT  
HMU2 AMINE ABSORBER

**ISSUED FOR CONSTRUCTION**  
07 Feb 2013


P-24208A/B  
ABSORBER 2  
CIRCULATING WATER WASH PUMP  
FLOW: 35.5 m<sup>3</sup>/h  
DIF. PRESSURE: 279 kPa  
POWER: 2.8 kW

SCALE: NONE	TOE DWG. No.:	
SHELL DWG NO.:	242.0001.000.040.006	REV. 1

FORMAT A1

DATE/STAMP: FORMAT TBD



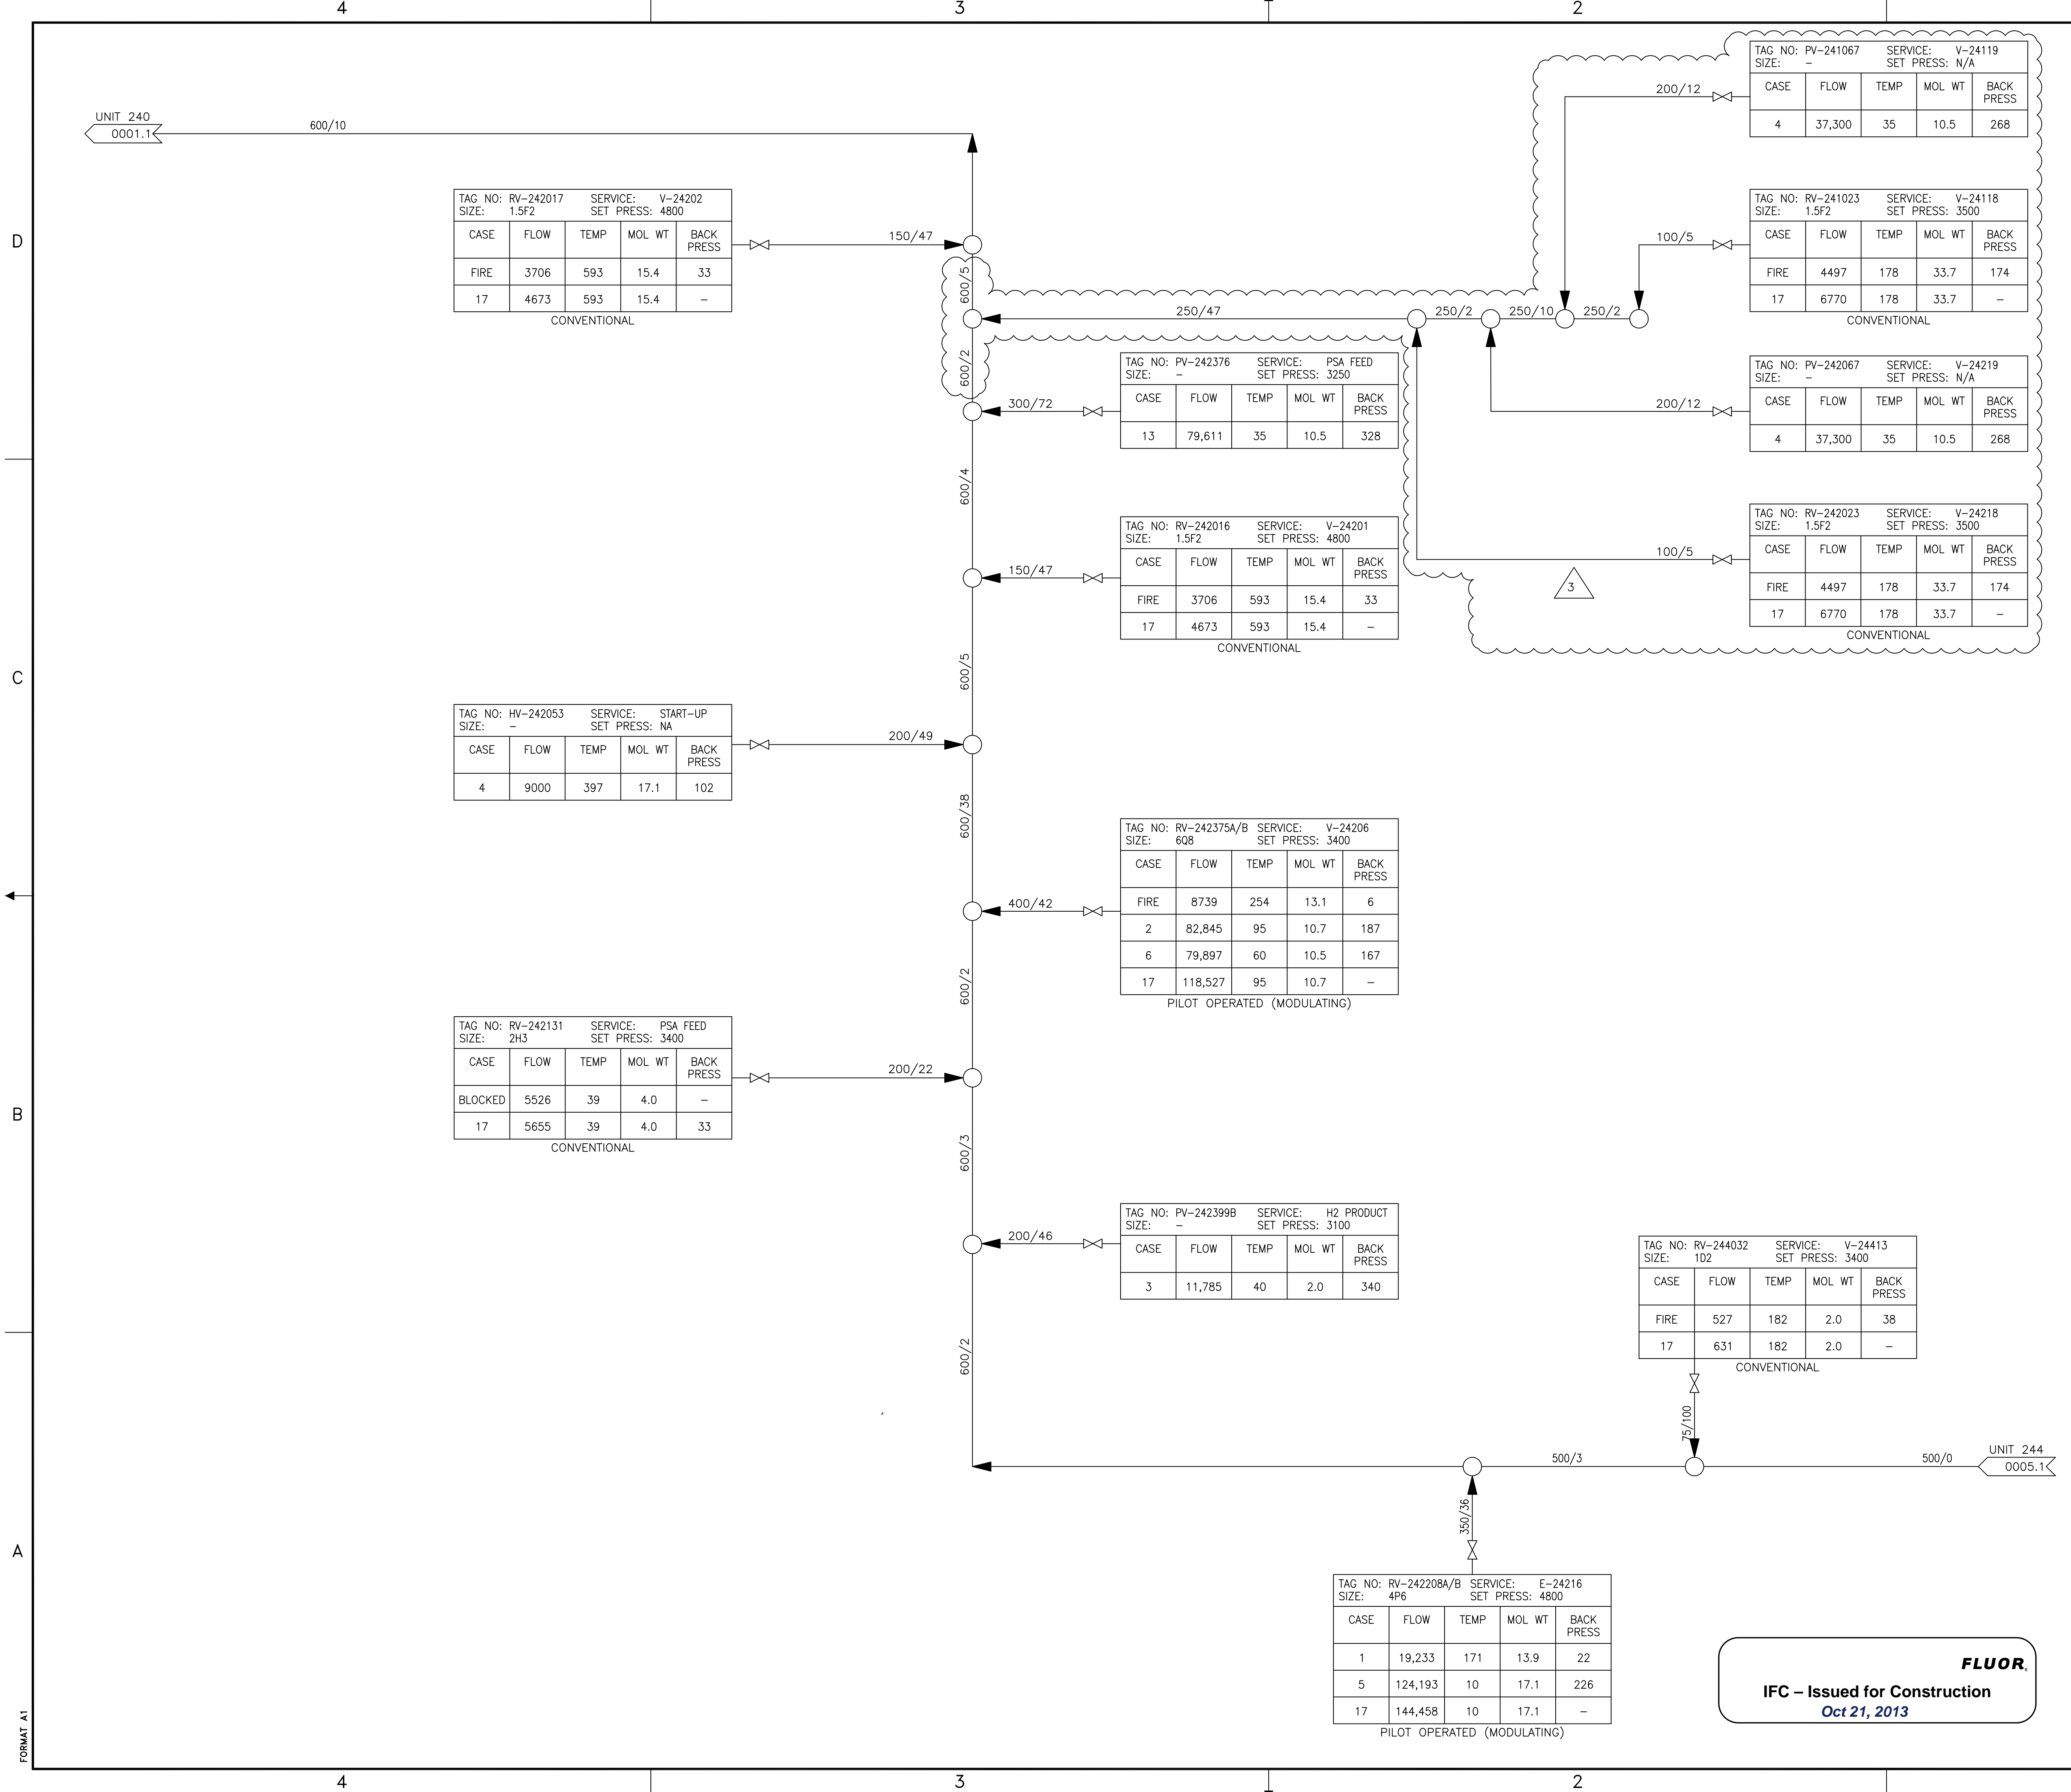

**NOTES**

**CASES:**

- REFORMER TRIP (ONE TRAIN)
- AIR COOLER FAILURE (ONE TRAIN)
- 2HRDP + HMU (TWO TRAINS)
- START-UP (ONE TRAIN)
- NG PV FAILURE (ONE TRAIN)
- STEAM MIXING VALVE FAILURE (ONE TRAIN)
- H2 RICH GAS PV FAILURE
- CHEM FEED COMP RECYCLE VALVE FAILURE
- PSA UNIT - VALVE OUT OF SEQUENCE
- FIRE - INLET AREA
- FIRE - SYN GAS COOLING TRIN AREA
- FIRE - PSA AREA
- BLOCKED FLOW TO PSA (ONE TRAIN)
- PSA UNIT - BLOCKED IN TAIL GAS
- PSA UNIT - TAIL GAS VENT VALVE FAILURE
- PSA UNIT - FEED BY-PASS VALVE FAILURE
- RATED CAPACITY OF VALVE (FROM VALVE MANUFACTURER)

**KEY PLAN**

**LINE CODE:**  
e.g. 150/53  
150 - LINE DIAMETER (mm)  
53 - LINE EQUIVALENT LENGTH (m) BETWEEN NODE POINTS

**LEGEND**  
PRESSURE: kPa (ga)  
TEMPERATURE: °C  
FLOW: kg/h  
○ NODE POINT

**REFERENCE DRAWINGS**

3	13 SEP 30	RE-ISSUED IFC ON NEXT HARD REV							
2A	13 JAN 14	ISSUED FOR CONSTRUCTION	GB	KB	KH	CV			
1	02 OCT 03	AS-BUILT	RVM	EG	DEW	MWP			
0	01 JUL 26	IFD: ISSUED FOR DESIGN	LWM	EG	RAMC	MWP			DCL
B	01 JUN 19	IFR: ISSUED FOR REVIEW	LWM	EG	BTK				
A	00 AUG 02	IFR: ISSUED FOR REVIEW	LWM	RAMC	RAMC				
REV	ISSUED DATE	DESCRIPTION	DWN	CHKD	ENG	APP	APP	CLNT	APP

UNIT 244	0005.1
----------	--------

**SHELL CANADA LTD.**  
ATHABASCA OIL SANDS  
DOWNSTREAM PROJECT

PARSONS . KRUPP UHDE . TRI OCEAN

**RELIEF & DEPRESS FLOW DATA SUMMARY**  
HYDROGEN MANUFACTURING UNIT  
UNIT 242


**FLUOR**  
IFC - Issued for Construction  
Oct 21, 2013

SCALE: NTS	TOE DWG. No.: 99049-2-DG-BG-00001.1
SHELL DWG NO.: 242.0001.000.043.001	REV: 3

FORMAT A1

P-111-001



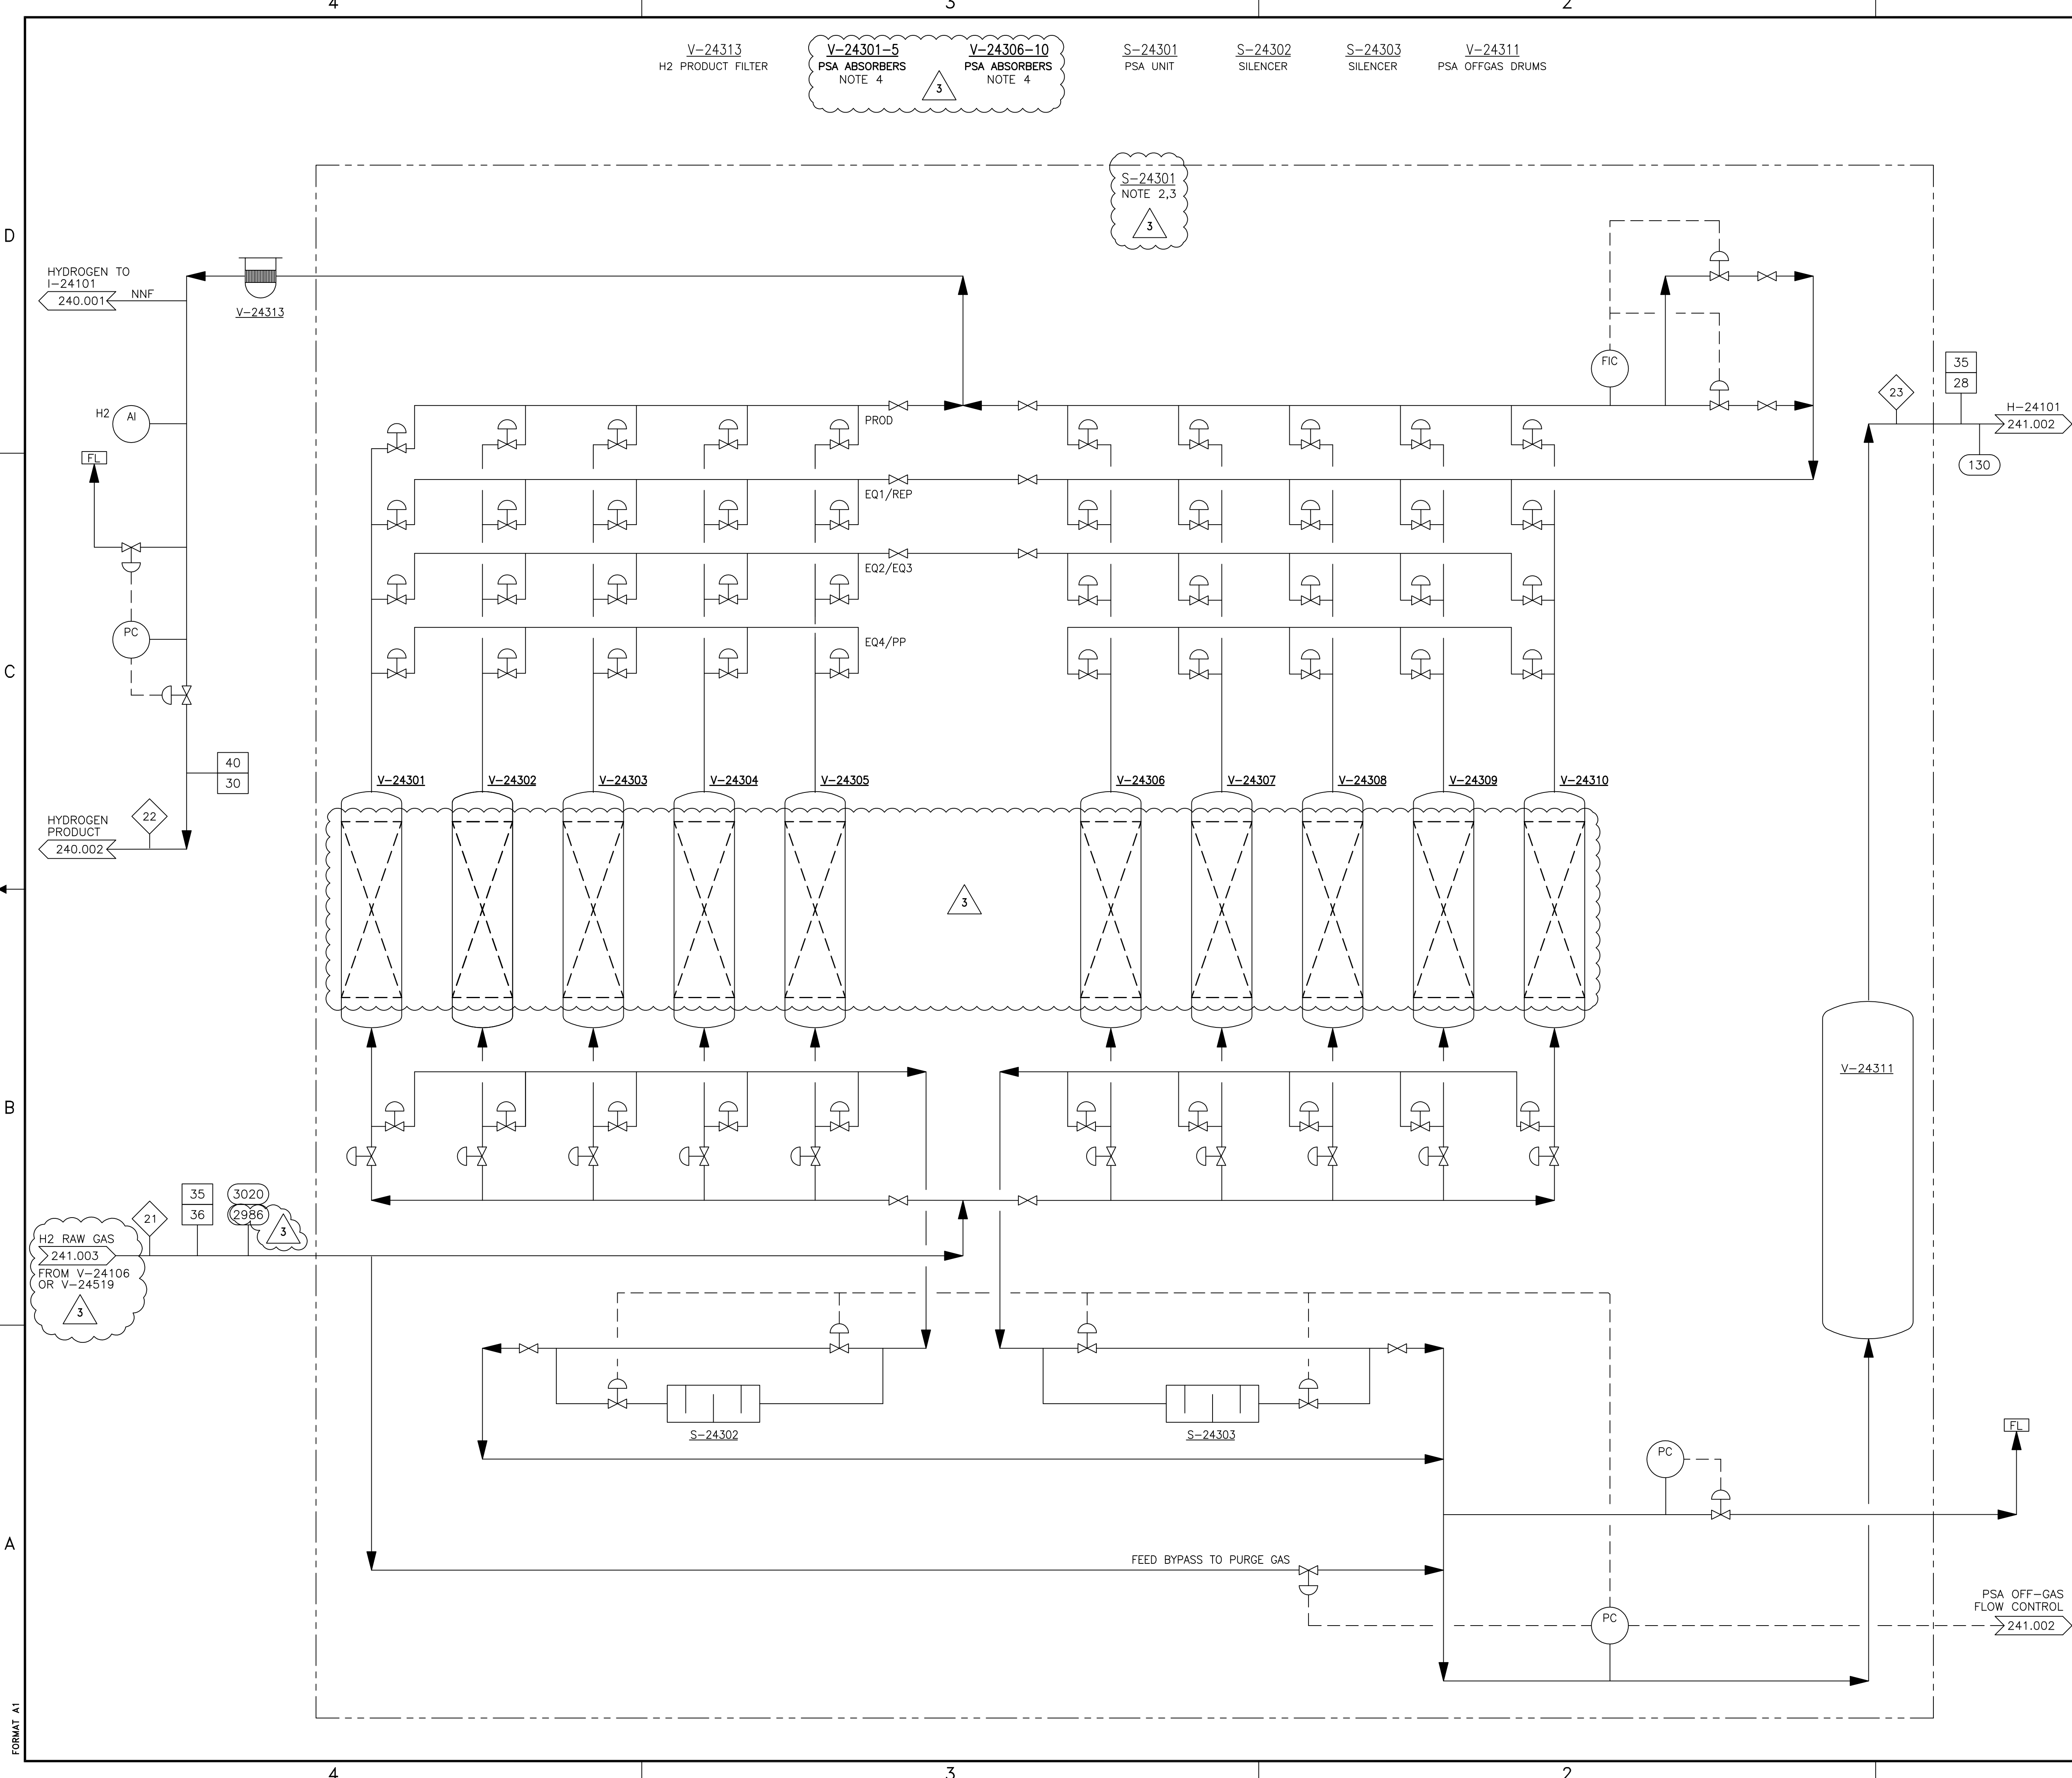

**NOTES**

1. FLOWS & DUTIES: CASE #2 / CASE #24.
2. CASE #2: H2 PRODUCTION WITH ADDITIONAL CHEMICAL FEED AND DOW GAS. FGR OFFLINE. CO2 RICH STREAM TO PSA.
3. CASE #24: H2 PRODUCTION WITH ADDITIONAL CHEMICAL FEED AND DOW GAS. FLUE GAS RECYCLE ONLINE AT 100%. CO2 LEAN STREAM TO PSA.
4. MODIFICATIONS TO THE PSA UNIT TO BE DESIGNED BY AIR PRODUCTS.
5. LOGIC CHANGES REQUIRED FOR SWITCHING BETWEEN LEAN AND RICH CO2 CASES.
6. REPLACE PSA ABSORBENT.

**REFERENCE**

- ◇ STREAM NUMBER
- TEMPERATURE - CASE #2 (°C)  
□ TEMPERATURE - CASE #24 (°C)
- PRESSURE - CASE #2 (kPa-a)  
○ PRESSURE - CASE #24 (kPa-a)
- ▬ FLOW - CASE #2 (kg/Hr)  
▬ FLOW - CASE #24 (kg/Hr)
- ▬ Std. VOL. FLOW - CASE #2 (m<sup>3</sup> (st)/hr)  
▬ Std. VOL. FLOW - CASE #24 (m<sup>3</sup> (st)/hr)

**ISSUED FOR CONSTRUCTION**  
21 Oct 2013

**FLUOR.** FLUOR'S RESPONSIBILITY IS LIMITED TO THE REVISION CONTENT SHOWN IN THIS DOCUMENT.

REV	ISSUED DATE	DESCRIPTION	DWN	CHKD	ENG	APP	APP	CLNT APP
3	13 SEP 30	RE-ISSUED IFC ON NEXT HARD REV	GB	CC	LMF	KH	CV	
2C	13 JAN 09	ISSUED FOR CONSTRUCTION	GB	KB		KH	CV	
2B	11 AUG 31	RE-ISSUED FOR QUEST DESIGN	GB	SM	SM	JL	CV	MO/98
2A	11 MAR 04	RE-ISSUED FOR QUEST DESIGN	GB	SM	BS	JL	CV	MO/98
2	10 NOV 03	ISSUED FOR QUEST DESIGN	JH	SM	BS	JL	CV	MO/98
1A	10 AUG 24	ISSUED FOR QUEST COARSE HAZOP	JH					
1	02 SEP 20	AS-BUILT	LWM	MWP	AAI	MWP	HRM	
0	00 OCT 23	IFC: ISSUED FOR CONSTRUCTION	WZF	SW	SW	MWP	DLA	HRM


**SHELL CANADA LTD.**  
ATHABASCA OIL SANDS  
DOWNSTREAM PROJECT  
PARSONS . KRUPP UHDE . TRI OCEAN

**PROCESS FLOW DIAGRAM**  
HYDROGEN MANUFACTURING UNIT  
H2 PURIFICATION

SCALE: NTS TOE DWG. No.: 99049-2-DG-BB-00003.1  
SHELL DWG NO.: 243.0001.000.040.001 REV. 3

FORMAT A1

0031-F61

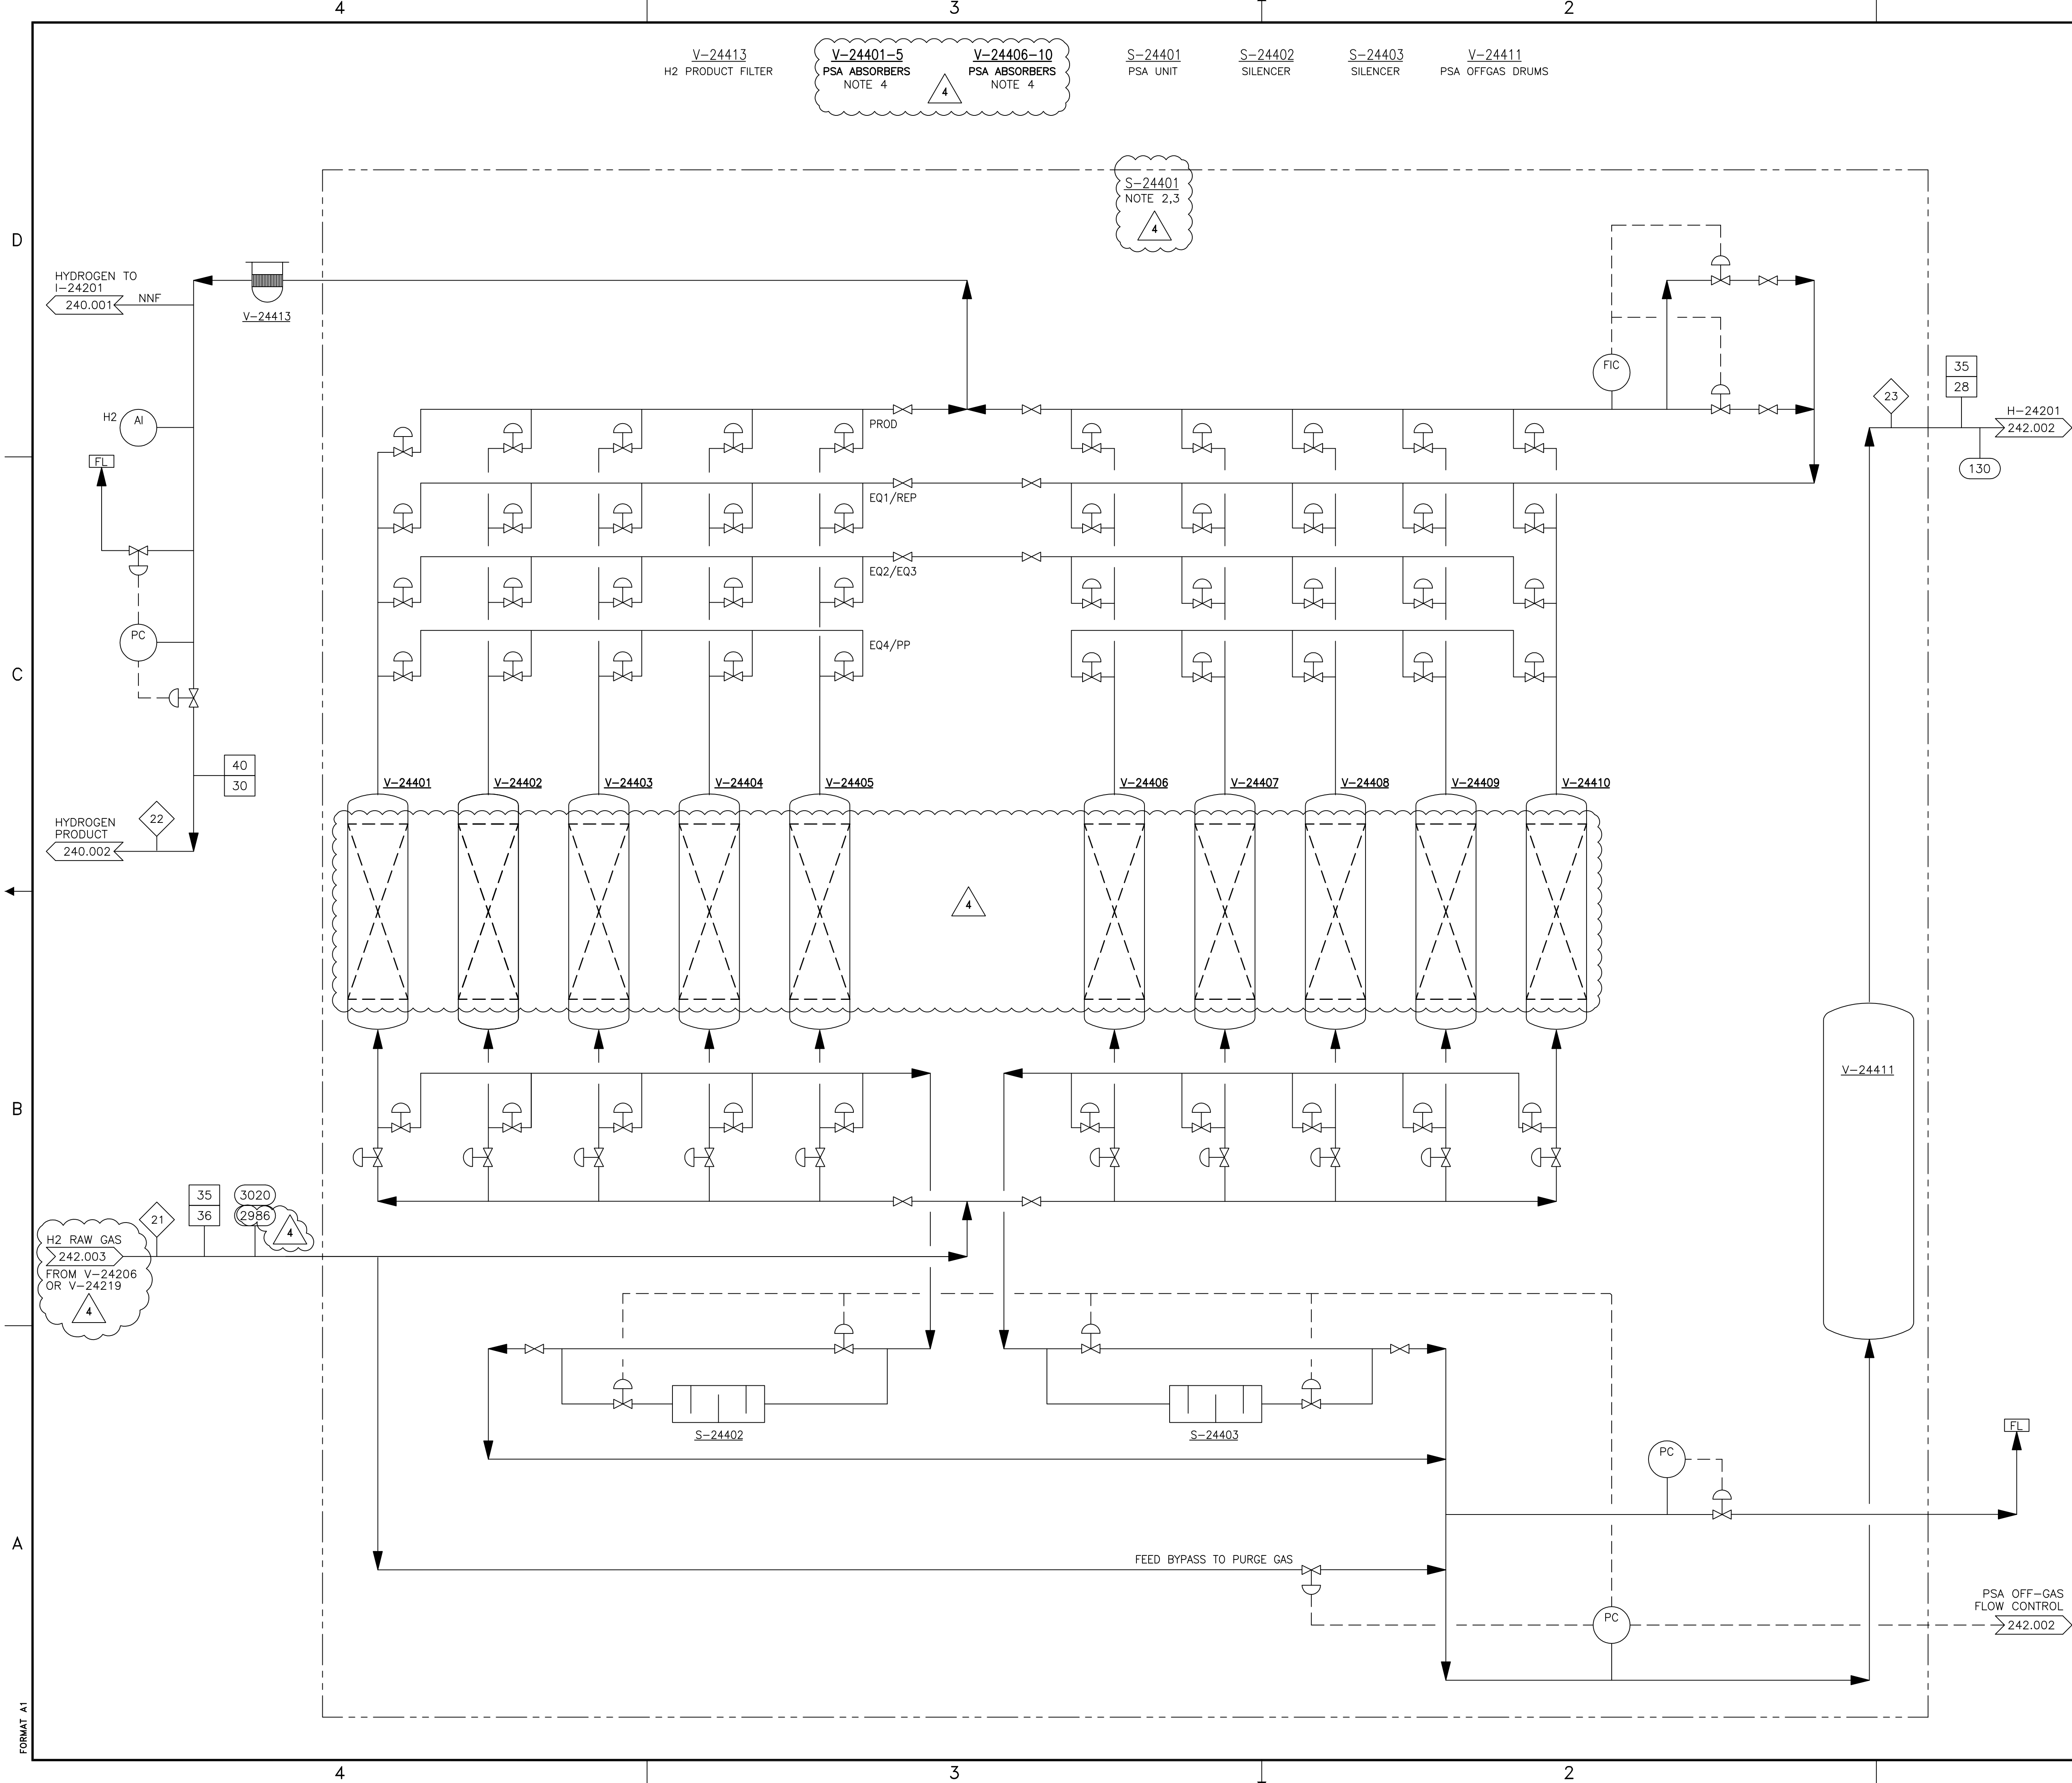

- NOTES**
1. FLOWS & DUTIES: CASE #2 / CASE #24.  
CASE #2: H2 PRODUCTION WITH ADDITIONAL CHEMICAL FEED AND DOW GAS. FGR OFFLINE. CO2 RICH STREAM TO PSA.  
CASE #24: H2 PRODUCTION WITH ADDITIONAL CHEMICAL FEED AND DOW GAS. FLUE GAS RECYCLE ONLINE AT 100%. CO2 LEAN STREAM TO PSA.
  2. MODIFICATIONS TO THE PSA UNIT TO BE DESIGNED BY AIR PRODUCTS.
  3. LOGIC CHANGES REQUIRED FOR SWITCHING BETWEEN LEAN AND RICH CO2 CASES.
  4. REPLACE PSA ABSORBENT.

- REFERENCE**
- ◇ STREAM NUMBER
  - TEMPERATURE - CASE #2 (°C)  
□ TEMPERATURE - CASE #24 (°C)
  - PRESSURE - CASE #2 (kPa-a)  
○ PRESSURE - CASE #24 (kPa-a)
  - ▬ FLOW - CASE #2 (kg/Hr)  
▬ FLOW - CASE #24 (kg/Hr)
  - ▬ Std. VOL. FLOW - CASE #2 (m<sup>3</sup> (st)/hr)  
▬ Std. VOL. FLOW - CASE #24 (m<sup>3</sup> (st)/hr)

**ISSUED FOR CONSTRUCTION**  
21 Oct 2013

**FLUOR.** FLUOR'S RESPONSIBILITY IS LIMITED TO THE REVISION CONTENT SHOWN IN THIS DOCUMENT.

REV	ISSUED DATE	DESCRIPTION	DWN	CHKD	ENG	APP	APP	CLNT	APP
4	13 SEP 30	RE-ISSUED IFC ON NEXT HARD REV	GB	CC	LMF	KH	CV		
3C	12 DEC 21	ISSUED FOR CONSTRUCTION	GB	KB		KH	CV		
3B	11 AUG 31	RE-ISSUED FOR QUEST DESIGN	GB	SM	SM	JL	CV		M/98
3A	11 MAR 04	RE-ISSUED FOR QUEST DESIGN	GB	SM	BS	JL	CV		M/98
3	10 NOV 03	ISSUED FOR QUEST DESIGN	JH	SM	BS	JL	CV		M/98
2A	10 AUG 24	ISSUED FOR QUEST COARSE HAZOP	JH						
2	02 SEP 20	AS-BUILT	LWM	MWP	AAI	MWP			HRM
1	01 MAY 31	IFC: ISSUED FOR CONSTRUCTION	LWM	EG	RAMC	MWP			DCL

DRAWING REVISION "0"  
AFFIXED WITH P.ENG.  
STAMP ON 00.10.16  
AND STAMPED BY:  
ROBERT A. MACDONALD.

FULL SIZE VERSION OF THIS DRAWING  
STAMPED WITH PERMIT TO PRACTICE  
AT REV.0

**SHELL CANADA LTD.**  
ATHABASCA OIL SANDS  
DOWNSTREAM PROJECT  
PARSONS . KRUPP UHDE . TRI OCEAN


**PROCESS FLOW DIAGRAM**  
HYDROGEN MANUFACTURING UNIT  
H2 - PURIFICATION

SCALE: NTS TOE DWG. No.: 99049-4-DG-BB-00001.1  
SHELL DWG NO.: 244.0001.000.040.001 REV. 4

FORMAT A1

0011-FEL



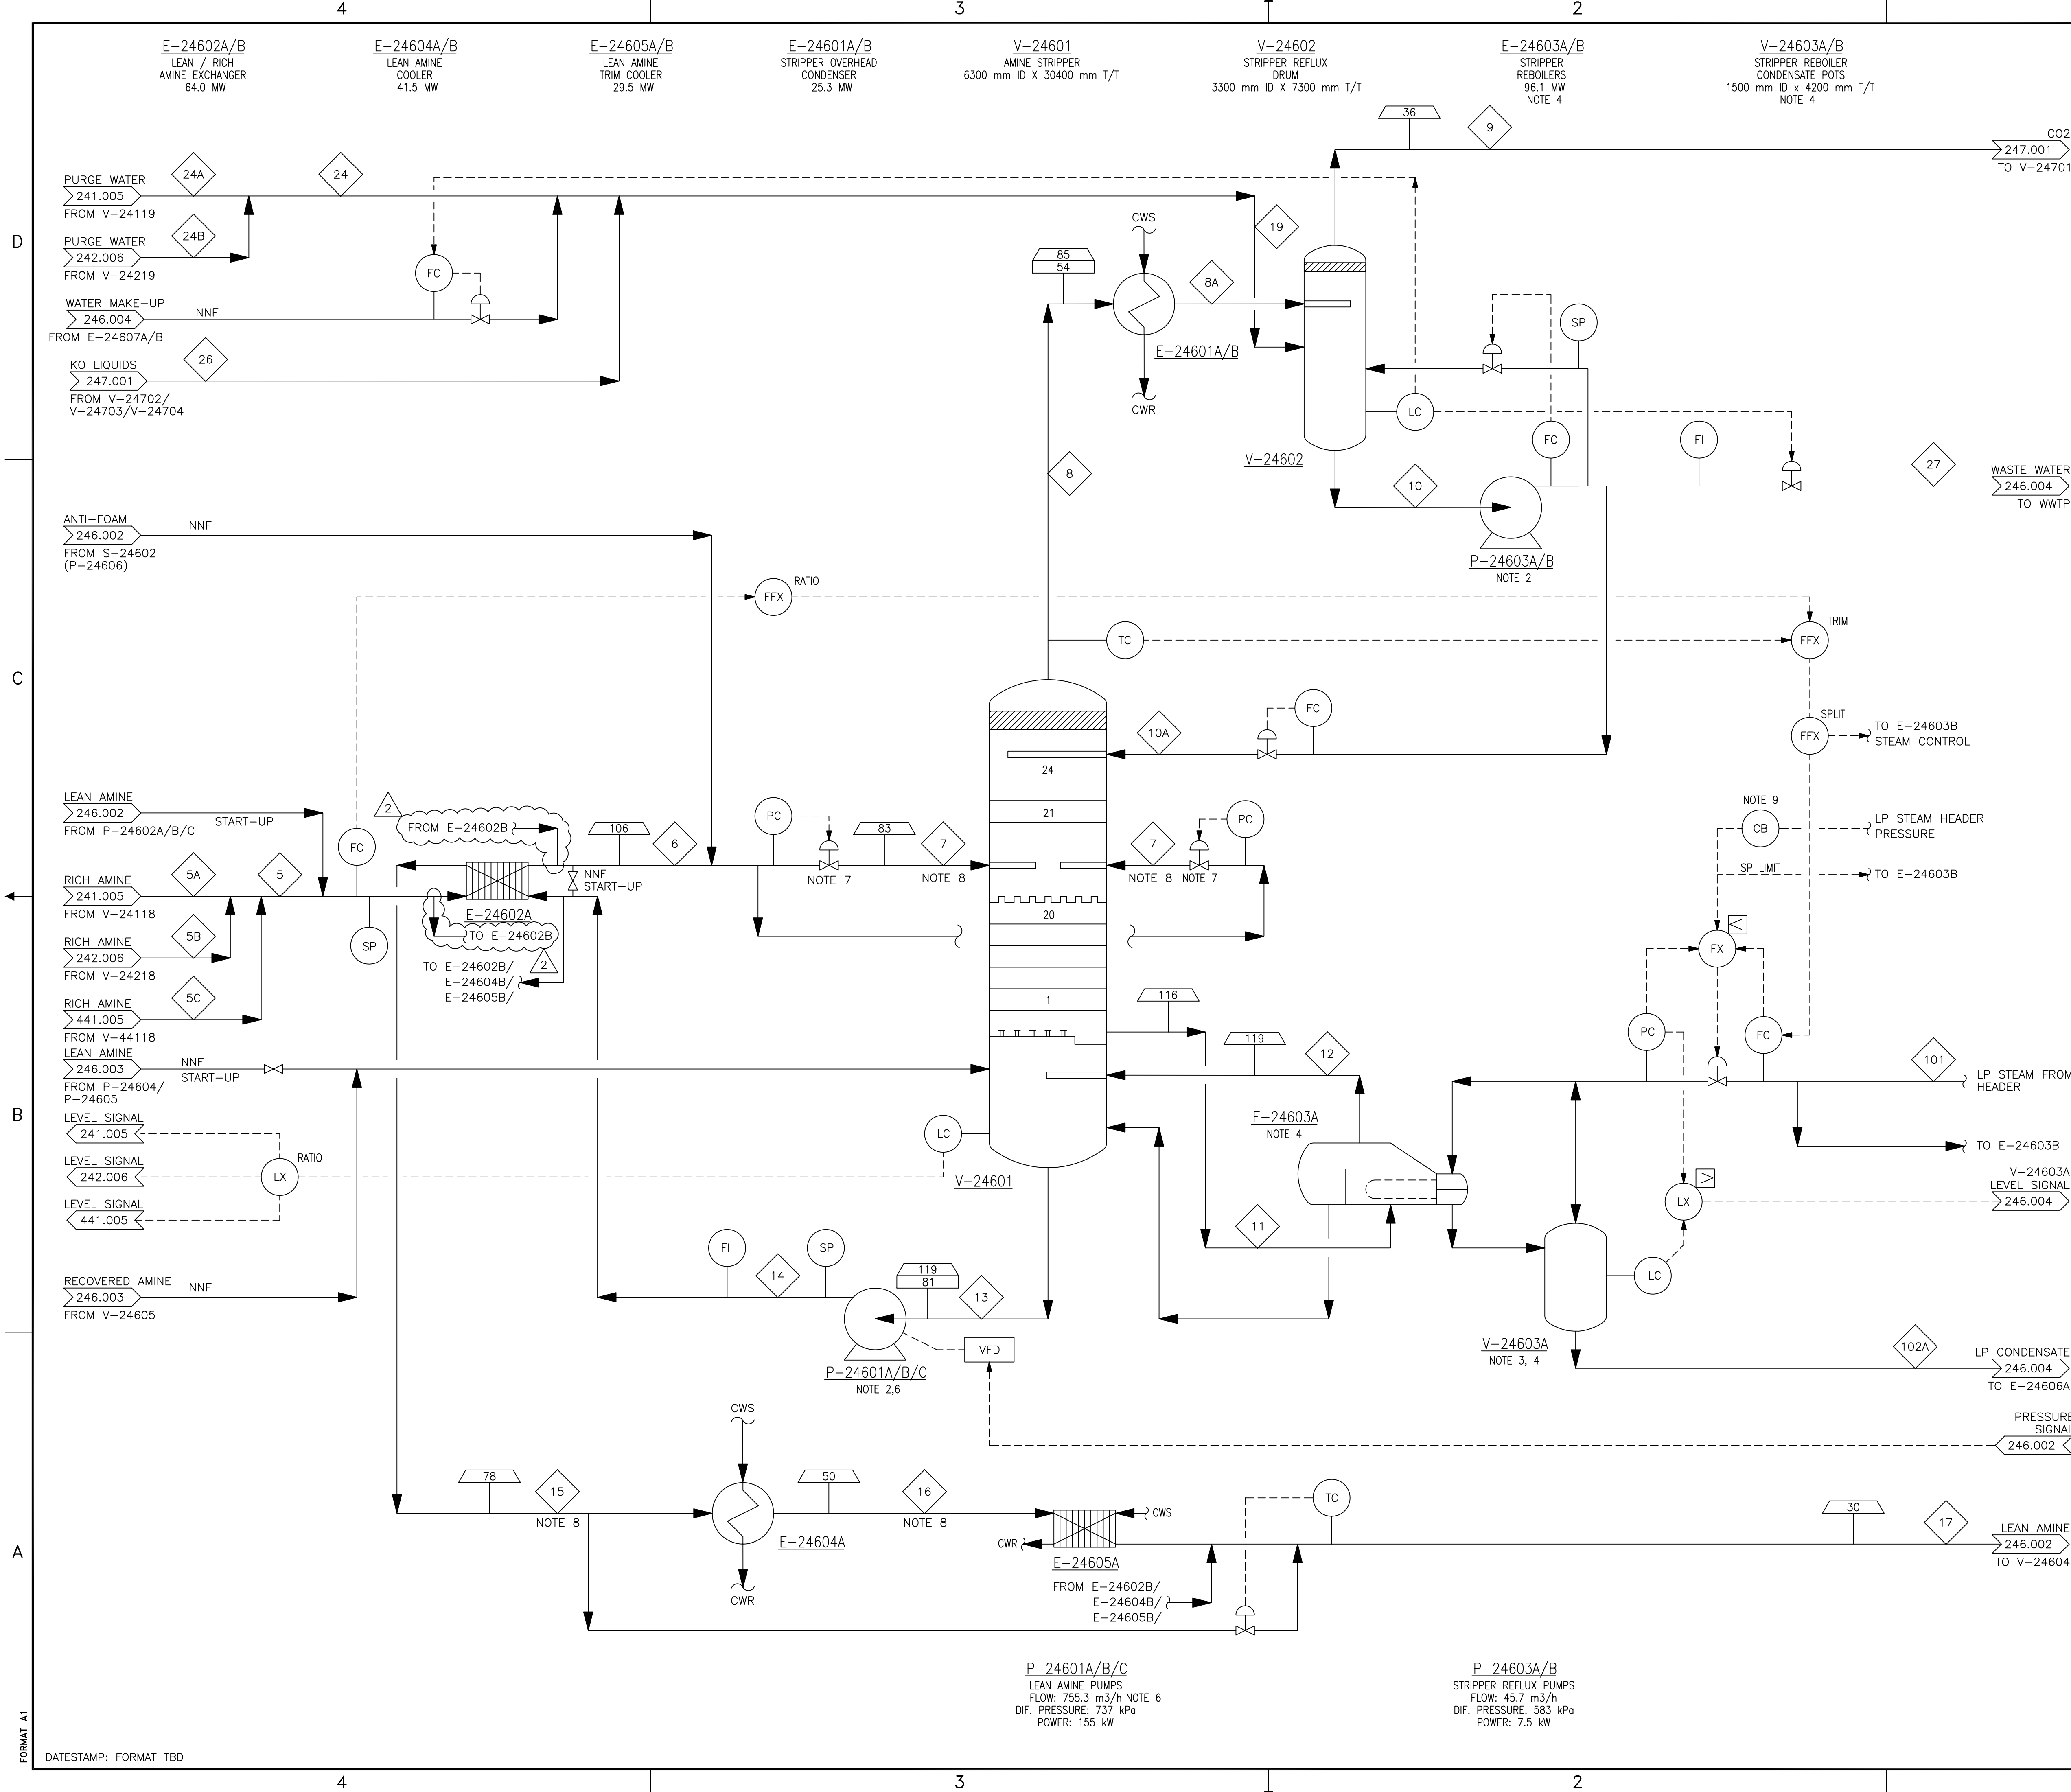

- NOTES**
- REFER TO HEAT AND MATERIAL BALANCE, DOCUMENT NUMBER 245.0001.000.046.001, FOR STREAM INFORMATION.
  - ALL AMINE PUMPS ARE CONTAINED WITHIN CURBED CONTAINMENT AREAS.
  - REBOILER CONDENSATE POT LEVEL TO BE SET TO ALLOW FLOODING OF STRIPPER REBOILER TUBES.
  - REBOILERS AND CONDENSATE POTS ARE 2 X 50%. ONE TRAIN IS SHOWN.
  - EQUIPMENT DRAINS ARE HARD-PIPED TO THE AMINE DRAIN DRUM.
  - 3 X 50% PUMPS FOR A TOTAL FLOW RATE OF 1511 m<sup>3</sup>/h.
  - CONTROL VALVES ARE 2 X 50%.
  - HMB FLOW RATE FOR STREAMS 7, 15 AND 16 REFLECT THE TOTAL AMINE FLOW.
  - STAGED CUTBACK FOR REDUCTION OF LP STEAM TO REBOILERS BASED ON LP STEAM HEADER PRESSURE.

**ISSUED FOR CONSTRUCTION**  
04 Jun 2013

- LEGEND**
- ◇ XXX STREAM NUMBER
  - △ XXX TEMPERATURE, °C
  - XXX PRESSURE, kPag
  - ▭ XX,XXX FLOW, kg/h

REV	ISSUED DATE	DESCRIPTION	DWN	CHKD	ENG	APP	APP	CLNT	APP
2	13/05/24	ISSUED FOR CONSTRUCTION	GB	KB	SL	KH	CV		
1	12/11/23	ISSUED FOR CONSTRUCTION	GB	KB	SL	KH	CV		
OB	11/08/31	RE-ISSUED FOR DESIGN	GB	SM	KH	JL	CV	MD/SB	
OA	11/03/01	RE-ISSUED FOR DESIGN	GB	SM	KH	JL	CV	MD/SB	
0	10/11/08	ISSUED FOR DESIGN	JH	QC	KH	JL	CV	MD/SB	

**SHELL CANADA**

**FLUOR**

PROCESS FLOW DIAGRAM  
QUEST CCS PROJECT  
AMINE STRIPPER SYSTEM

SCALE: NONE	TOE DWG. No.:	
SHELL DWG NO.:	246.0001.000.040.001	REV. 2

FORMAT A1

DATE/STAMP: FORMAT TBD

**P-24601A/B/C**  
LEAN AMINE PUMPS  
FLOW: 755.3 m<sup>3</sup>/h NOTE 6  
DIF. PRESSURE: 737 kPa  
POWER: 155 kW

**P-24603A/B**  
STRIPPER REFLUX PUMPS  
FLOW: 45.7 m<sup>3</sup>/h  
DIF. PRESSURE: 583 kPa  
POWER: 7.5 kW



D

C

B

A

FORMAT A1

DATESTAMP: FORMAT TBD

4

3

2

1



V-24604  
LEAN AMINE  
FILTER  
355 m3/h

TK-24602  
ANTI-FOAM  
INJECTION TANK  
1 m3

S-24602  
ANTI-FOAM  
INJECTION PACKAGE

V-24608  
LEAN AMINE  
CARBON FILTER  
75 m3/h

V-24609  
LEAN AMINE  
POST FILTER  
75 m3/h

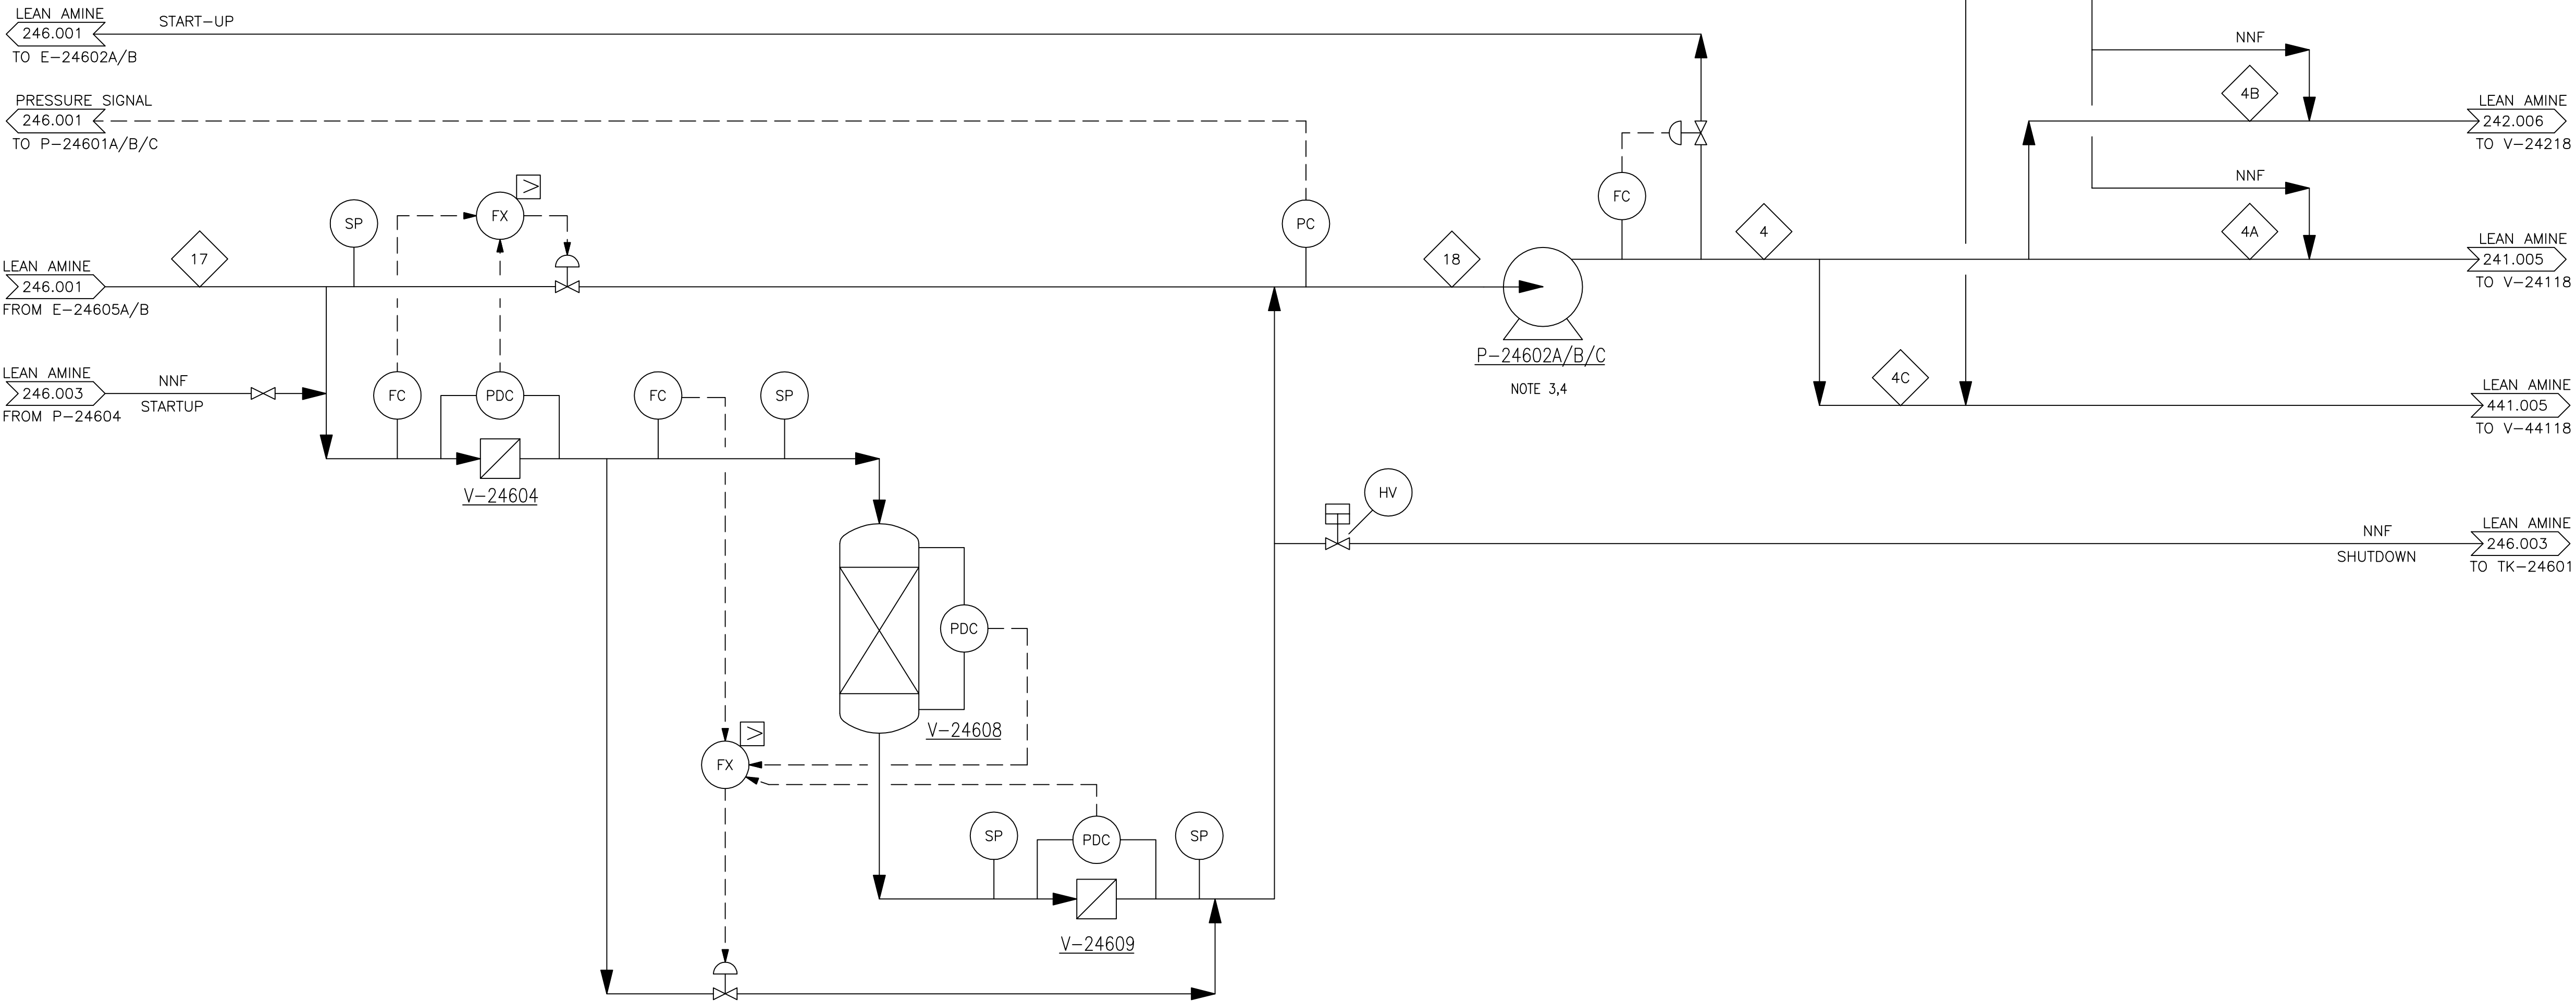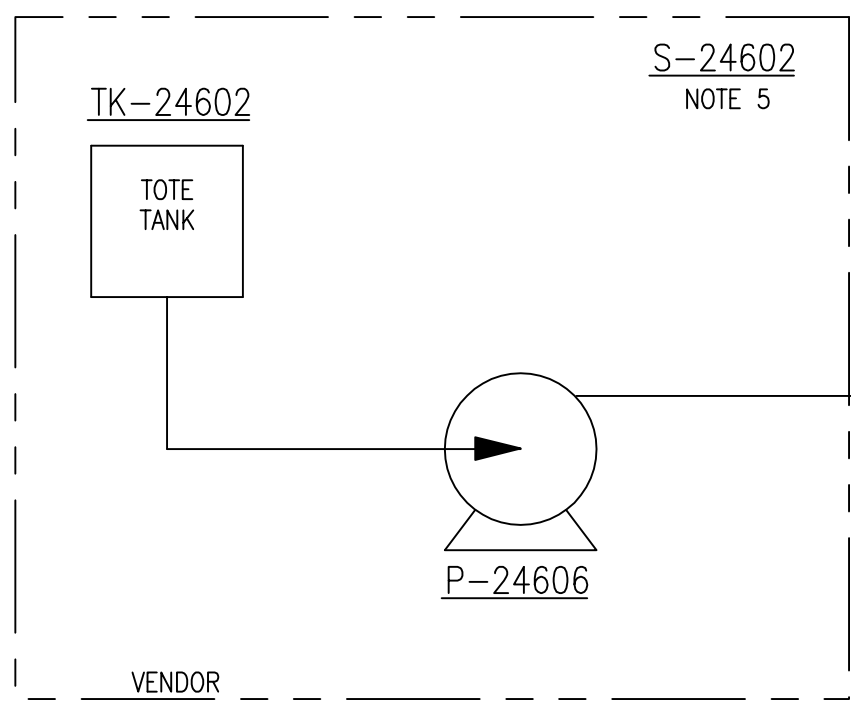

P-24606  
ANTI-FOAM  
INJECTION PUMP  
NOTE 5

P-24602A/B/C  
LEAN AMINE  
CHARGE PUMPS  
FLOW: 709.2 m3/h NOTE 4  
DIF. PRESSURE: 3603 kPa  
POWER: 710 kW

**ISSUED FOR CONSTRUCTION**  
07 Feb 2013

**NOTES**

- REFER TO HEAT AND MATERIAL BALANCE, DOCUMENT NUMBER 246.0001.000.046.001, FOR STREAM INFORMATION.
- EQUIPMENT DRAINS ARE HARD-PIPED TO THE CLOSED AMINE DRAIN COLLECTION DRUM.
- ALL AMINE PUMPS ARE CONTAINED WITHIN CURBED CONTAINMENT AREAS.
- 3 X 50% PUMPS FOR A TOTAL OPERATING FLOW RATE OF 1418 m3/h.
- TOTE TANK AND P-24606 ARE PART OF VENDOR PACKAGE S-24602.

**LEGEND**


- XXX STREAM NUMBER
- XXX TEMPERATURE, °C
- XXX PRESSURE, kPag
- XX,XXX FLOW, kg/h

REV	ISSUED DATE	DESCRIPTION	DWN	CHKD	ENG	APP	APP	CLNT APP
1	12/11/23	ISSUED FOR CONSTRUCTION	GB	KB	SL	KH	CV	
OB	11/08/31	RE-ISSUED FOR DESIGN	GB	SM	KH	JJ	CV	MD/SB
OA	11/03/01	RE-ISSUED FOR DESIGN	GB	SM	KH	JJ	CV	MD/SB
O	10/11/08	ISSUED FOR DESIGN	JH	QC	KH	JJ	CV	MD/SB



**FLUOR**  
PROCESS FLOW DIAGRAM  
QUEST CCS PROJECT  
AMINE FILTRATION AND  
ANTI-FOAM INJECTION

SCALE: NONE TOE DWG. No.: SHELL DWG NO.: 246.0001.000.040.002 REV. 1

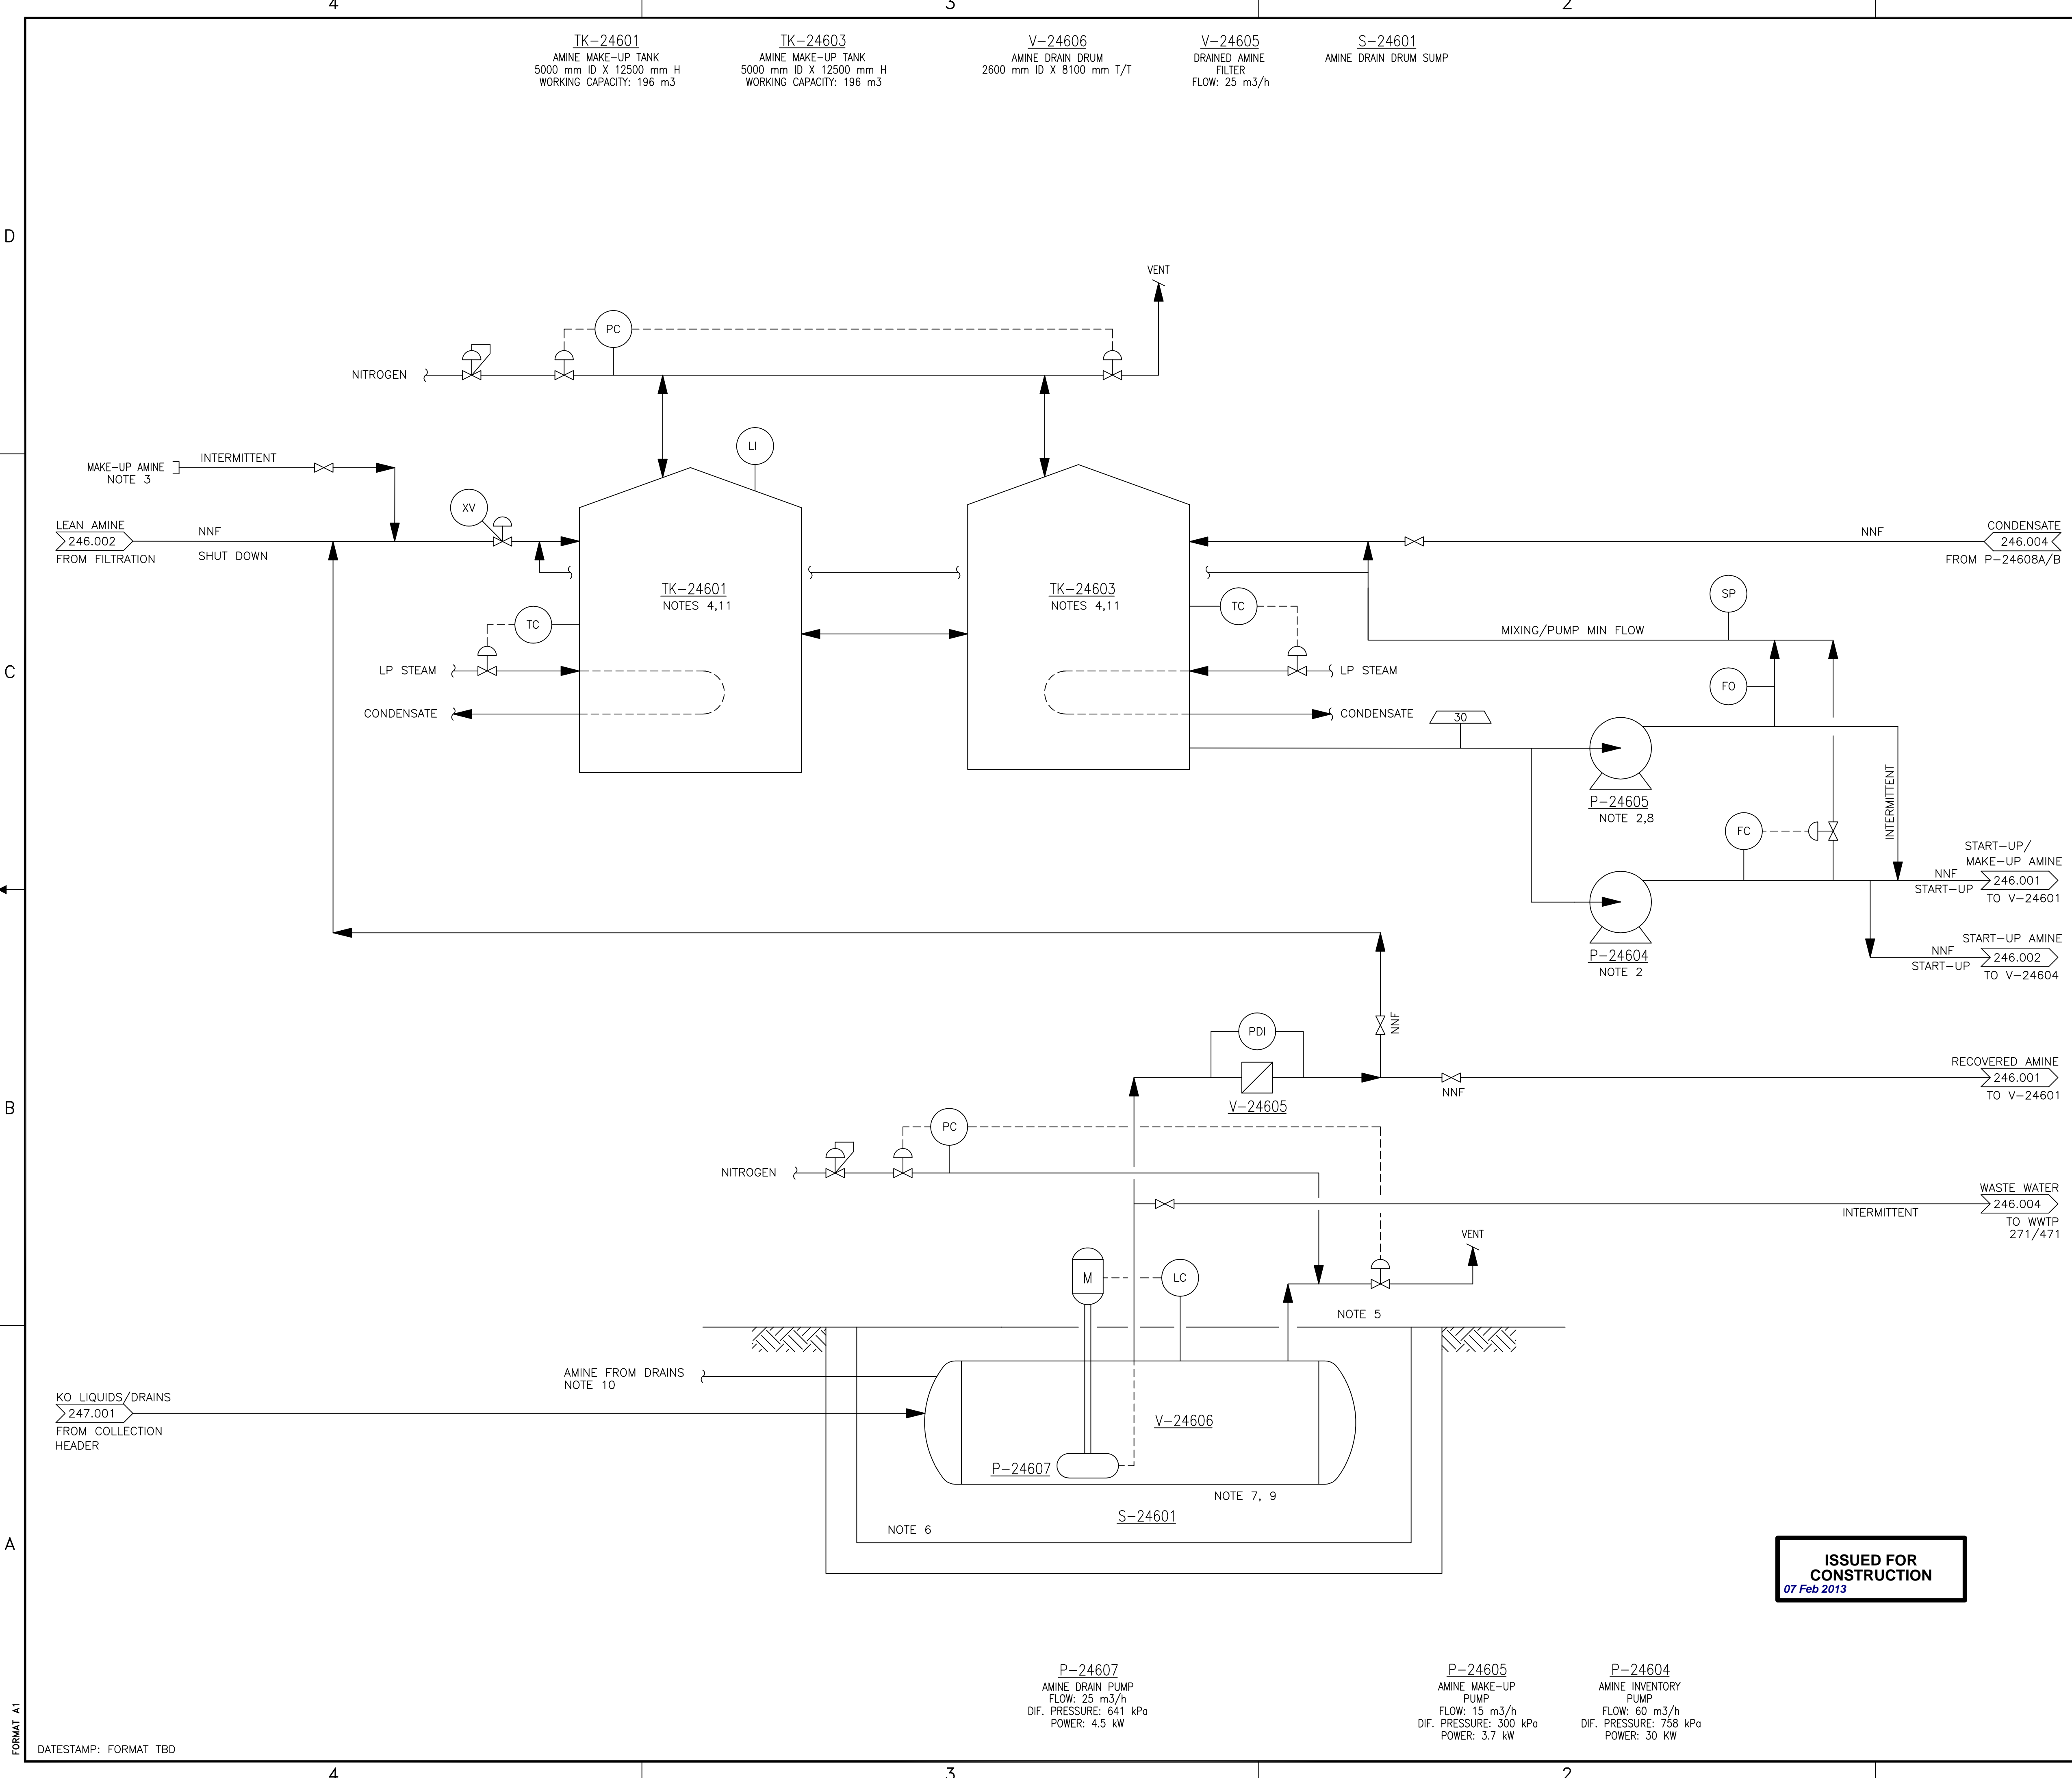

- NOTES**
- REFER TO HEAT AND MATERIAL BALANCE, DOCUMENT NUMBER 246.0001.000.046.001, FOR STREAM INFORMATION.
  - ALL AMINE PUMPS ARE CONTAINED WITHIN CURBED CONTAINMENT AREAS.
  - TRUCK CONNECTION NEAR TANK.
  - AMINE MAKE-UP TANK NORMALLY CONTAINS UNDILUTED MDEA/DEDA, BUT WILL CONTAIN DILUTED AMINE SOLUTION DURING MAINTENANCE TURNAROUNDS.
  - CHECKER PLATE ON TOP OF SUMP.
  - LIQUID COLLECTION IN SUMP TO BE REMOVED BY VACUUM TRUCK.
  - DRUM TO BE ELECTRICALLY TRACED.
  - PUMP WILL HAVE A WAREHOUSE SPARE.
  - SUMP TO COMPLY WITH ERCB DIRECTIVE 55 CONTAINMENT REQUIREMENTS.
  - EQUIPMENT DRAINS ARE HARD-PIPED TO THE CLOSED AMINE DRAIN COLLECTION DRUM.
  - ALL LIQUID NOZZLES ON TANKS ARE LOCATED BELOW LLL.
  - TANKS TK-24601 AND TK-24602 OPERATE AS ONE STORAGE FACILITY AND MUST BE ISOLATED TOGETHER. TANKS CANNOT OPERATE INDEPENDENTLY.

- LEGEND**
- ◇ XXX STREAM NUMBER
  - △ XXX TEMPERATURE, °C
  - XXX PRESSURE, kPag
  - ▭ XX,XXX FLOW, kg/h

REV	ISSUED DATE	DESCRIPTION	DWN	CHKD	ENG	APP	APP	CLNT APP
1	12/11/23	ISSUED FOR CONSTRUCTION	GB	KB	SL	KH	CV	
OB	11/08/31	RE-ISSUED FOR DESIGN	GB	SM	KH	JL	CV	MD/SB
OA	11/03/01	RE-ISSUED FOR DESIGN	GB	SM	KH	JL	CV	MD/SB
O	10/11/08	ISSUED FOR DESIGN	JH	QC	KH	JL	CV	MD/SB

REV	ISSUED DATE	DESCRIPTION	DWN	CHKD	ENG	APP	APP	CLNT APP

**SHELL CANADA**  
**FLUOR**  
 PROCESS FLOW DIAGRAM  
 QUEST CCS PROJECT  
 AMINE STORAGE AND DRAIN COLLECTION


SCALE: NONE	TOE DWG. No.:	
SHELL DWG NO.:	246.0001.000.040.003	REV. 1

**ISSUED FOR CONSTRUCTION**  
 07 Feb 2013

**P-24607**  
 AMINE DRAIN PUMP  
 FLOW: 25 m<sup>3</sup>/h  
 DIF. PRESSURE: 641 kPa  
 POWER: 4.5 kW

**P-24605**  
 AMINE MAKE-UP PUMP  
 FLOW: 15 m<sup>3</sup>/h  
 DIF. PRESSURE: 300 kPa  
 POWER: 3.7 kW

**P-24604**  
 AMINE INVENTORY PUMP  
 FLOW: 60 m<sup>3</sup>/h  
 DIF. PRESSURE: 758 kPa  
 POWER: 30 kW

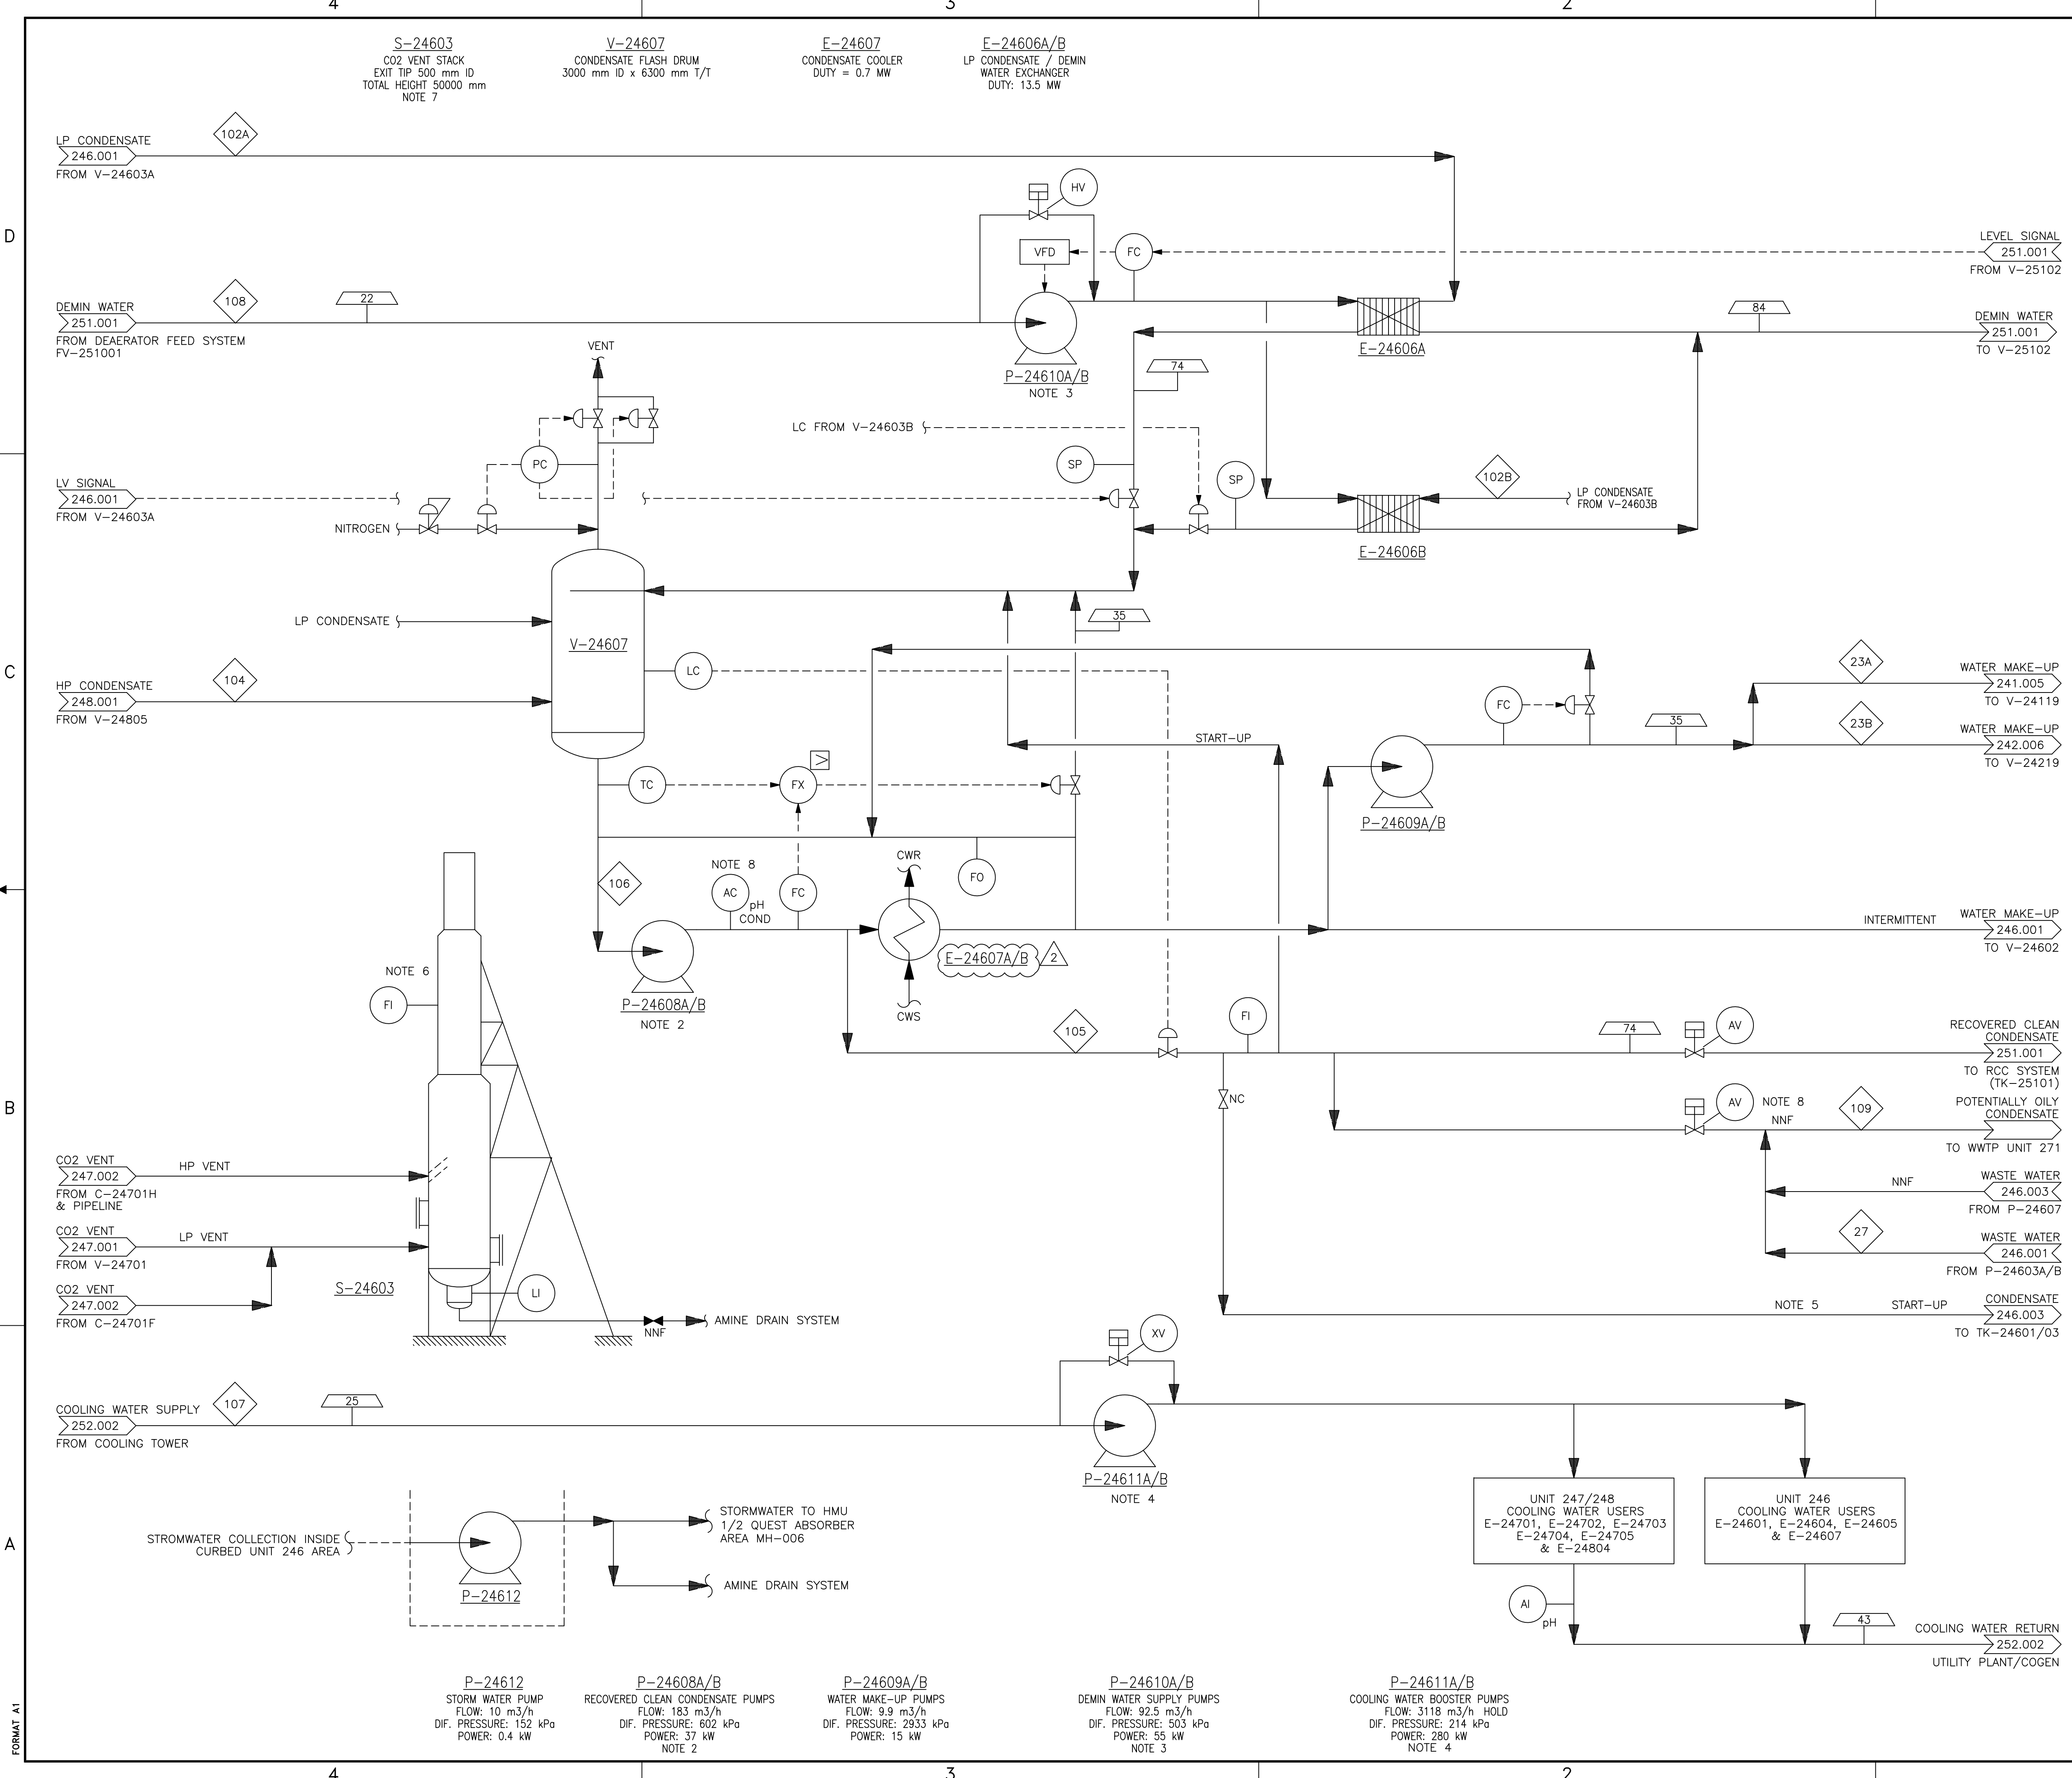

- NOTES**
- REFER TO HEAT AND MATERIAL BALANCE, DOCUMENT NUMBER 246.0001.000.046.001, FOR STREAM INFORMATION.
  - 2 X 100% PUMPS FOR TOTAL FLOW RATE OF 183 m<sup>3</sup>/h.
  - 2 X 50% PUMPS FOR TOTAL DESIGN FLOW RATE OF 185 m<sup>3</sup>/h.
  - 2 X 50% PUMPS FOR TOTAL DESIGN FLOW RATE OF 6236 m<sup>3</sup>/h.
  - START-UP PIPING REQUIRED FOR INITIAL AMINE FILL AND DILUTION WITH CONDENSATE.
  - TO MEASURE THE QUEST CCS UNIT CAPACITY DURING INITIAL START-UP, AS PROPOSED TO THE GOVERNMENT OF ALBERTA.
  - CO2 VENT STACK HAS A 900 mm BASE DIAMETER WHICH IS PROVIDED FOR PIPING CONNECTIONS, A MAIN RISER STACK WHICH IS 600 mm DIAMETER AND A 500 mm TIP DIAMETER WHICH IS 2.4 m LONG.
  - RECOVERED CONDENSATE ANALYSER (pH & COND.) LOCATED IN UNIT 246 WITH SWITCHING VALVES LOCATED AT UNIT 251 SOUTHWEST OF RCC TANK TK-25101. WASTE WATER LINE FROM QUEST AND RE-ROUTED QUEST POC COMBINE ON NEW PIPERACK FOR DELIVERY TO POC TIE-IN ON MAIN UTILITY PIPERACK (TO UNIT 271).

**ISSUED FOR CONSTRUCTION**  
04 Jun 2013

**LEGEND**

- ◇ XXX STREAM NUMBER
- △ XXX TEMPERATURE, °C
- XXX PRESSURE, kPag
- ▭ XX,XXX FLOW, kg/h

REV	ISSUED DATE	DESCRIPTION	DWN	CHKD	ENG	APP	APP	CLNT	APP
2	13/05/24	ISSUED FOR CONSTRUCTION	GB	KB	SL	KH	CV		
1	12/11/23	ISSUED FOR CONSTRUCTION	GB	KB	SL	KH	CV		
OB	11/08/31	RE-ISSUED FOR DESIGN	GB	SM	KH	JL	CV	MD/SS	
OA	11/03/01	RE-ISSUED FOR DESIGN	GB	SM	KH	JL	CV	MD/SS	
O	10/11/08	ISSUED FOR DESIGN	JH	QC	KH	JL	CV	MD/SS	

**SHELL CANADA**

**FLUOR**

**PROCESS FLOW DIAGRAM  
QUEST CCS PROJECT  
UTILITIES SYSTEM**

SCALE: NONE TOE DWG. No.: SHELL DWG NO.: 246.0001.000.040.004 REV. 2

FORMAT A1



ISSUED FOR DESIGN

SHELL CANADA ENERGY  
ATHABASCA OIL SANDS  
DOWNSTREAM PROJECT  
**FLUOR**


BATTERY LIMIT INTERFACE TABLE  
QUEST CAPTURE INTERFACE  
UNIT 246

246.0006.000.067.001

0	15-Aug-11	Issued for Basic Design Engineering Package							
B	3-Mar-11	Issued For PHA II Review							
A	8-Nov-10	Issued for information							
REV	DATE	DESCRIPTION	BY	CHK	APP	APP	CLNT APP	Rev	

ISBL	OSBL	Fluid Description	Pipe Cl el	Northing	Easting	Conn. Type	In / Out	Phase	P&ID Number	Sch.	Line Size	Fluid Code	Line Number	Matl. Class	Insulation Type / Mat'l	Thickness	Tracing	Const. Class	Severity Rating	Mass Flow				Pressure		Temperature		Properties		Design Code		Notes	Rev		
																				Minimum	Normal	Maximum	Design	Normal	Maximum	Normal	Max	Viscosity	Density / (MW)	Press	Temp				
																				kg/h	kg/h	kg/h	kg/h	kPa(ga)	kPa(ga)	°C	°C	mPa-s	kg/m³	kPa(ga)	°C				
<b>Unit 246 Quest - Process Lines to HMU 1 / 2 - West Side of Unit 246</b>																																			
ISBL	OSBL	Lean Amine to HMU1/2				BW	OUT	L	246.011		16	P	248080	DAG	H /	xx	ET / 10				849,758	849,758	849,758	3769		30		5.46	1,040	6000	90	2 m/s velocity limit for CS pipe	C		
ISBL	OSBL	Rich Amine from HMU1/2				BW	IN	V/L	246.001		10	P	242064	DJE	H /	xx	ET / 10				934,642	934,642	934,642	2001		64		4.11	1,102	3500	95	Upper bound 5m/s velocity limit for SS pipe. Properties are for liquid fraction	C		
ISBL	OSBL	Wash Water Makeup to HMU 1/2				BW	OUT	L	246.022		2	SCH	246003	SAG	H /	xx	ET / 10				9,018	9,018	9,018	2920		35		0.74	994	4650	60		C		
ISBL	OSBL	Wash Water Purge				BW	IN	L	246.006		3	P	241076	PJE	H /	xx	ET / 10				9,126	9,126	9,126	76		38		0.68	994	3500	60	Includes CO2 rich waters, Line number to reflect origin point	C		
ISBL	OSBL	Anti Foam Injection					OUT	L	246.014		3/4	KP	246005	PJG	H /	xx	ET / 10				42		85	3800		15		168.00	1,016	4000	50	Small bore Injection piping to be supported Based on injection rate to meet 200 ppmw into Lean Amine	C		
ISBL	OSBL	Potentially Oily Storm Water Sewer (POSWS)				BW	OUT	L	246.035		2	WW	246001	UAB	H /	xx	ET / 10				0	0	10,000	10,000	350		5 - 15		1.50	1,000	700	50		C	
<b>Unit 246 Quest - Process Lines to Pipeline Scope area - North West Side of Unit 246</b>																																			
ISBL	OSBL	CO2 to Pipeline				BW	OUT	Dense Phase	247.014		8	GC	247059	PJL(C)							148,496	148,496	148,496	9000	13900	43		0.029	402.0	14790	60	U/G piping temperature constraint to be checked, check 16NPS as part of future	C		
ISBL	OSBL	Pipeline Vent				BW	IN	V	247.044		2	VA	247014	PJB(C)							NNF			1600		??							HOLD destination in Quest Capture unit not defined and metallurgy effect not known	C	
<b>Unit 246 Quest - Underground Utilities Lines - North Side of Unit 246</b>																																			
ISBL	OSBL	Potable Water					IN	L			2	WD	246xxx	UJB	H /	xx	ET-10				NNF		14,990	760		96		0.30	962.2	1400	130	Underground is the current supply point. Need to consider using standalone water storage for safety shower / eye wash stations	C		
ISBL	OSBL	Firewater					IN	L	258.004		12	FW	258xxx	UHY							NNF		250,000	900		5		1.52	1,000.4	1100	27	1 of 2 Tie-Ins - Underground	C		
ISBL	OSBL	Firewater					IN	L	258.004		12	FW	258xxx	UHY							NNF		250,000	900		5		1.52	1,000.4	1100	27	2 of 2 Tie Ins - Underground	C		
<b>Unit 246 Quest - Process &amp; Utilities Lines - North Side of Unit 246</b>																																			
ISBL	OSBL	Lean Amine to HMU3				BW	OUT	L	246.101		14	P	246081	DAG	H /	xx	ET / 10				625,733	625,733	625,733	3769		30		5.46	1,040	6000	90	2 m/s velocity limit for CS pipe	C		
ISBL	OSBL	Rich Amine from HMU3				BW	IN	V/L	246.101		10	P	246002	DJE	H /	xx	ET / 10				689,658	689,658	689,658	2870		64		4.11	1,103	3500	95	Upper bound 5m/s velocity limit for SS pipe. Properties are for liquid fraction	C		
ISBL	OSBL	DWR Demin Water Return				BW	OUT	L	246.101		6	WI	246007	UJD	H /	xx	ET / 10				184,890	203,400	203,400	416		84		0.49	985.2	xxx TBD	125	Requires re-rate of existing spec to allow DT to be increased to match new operating temperature.	C		
ISBL	OSBL	RCC Recovered Clean Condensate				BW	OUT	L	246.101		6	SC	246008	SAB	H /	xx	ET / 10				153,894	161,718	161,718	350		74		0.30	975.6	1400	130	need to check pressure profile	C		
ISBL	OSBL	LT RHC H P Steam				BW	IN	V	246.101		2	SS	248001	SAG	H /	xx					589	850	850	4350		257		0.02	(18.0)	5170	415	used for TEG Regeneration	C		
ISBL	OSBL	SL L P Steam				BW	IN	V	246.101		36	SL	246001	SAB	H /	xx					166,300	166,300	170,326	335		160		0.01	(18.0)	500	250	includes utility stations	C		
ISBL	OSBL	AU Utility Air				BW	IN	V	246.101		2	AU	246001	ULB							NNF	250	250	700		45		0.02	(29.0)	1200	70		C		
ISBL	OSBL	WU Utility Water				BW	IN	L	246.101		2	WU	246001	UAB	H /	xx	ET / 10				NNF	11,000	11,000	250		35		0.72	994.1	1650	122		C		
ISBL	OSBL	AI Instrument Air				BW	IN	V	246.101		3	AI	246001	ULB							131	164	164	700		45		0.02	(29.0)	1200	70		C		
ISBL	OSBL	Waste Water				BW	OUT	L	246.101		4	WP	246002	PJB	H /	xx	ET / 10				12,000	12,000	12,000	250		40		0.72	992.3	1650	122	Includes CO2 rich waters, tie-in to POC, HOLD on Line Size	C		
ISBL	OSBL	GI Nitrogen				BW	IN	V	246.101		2	GI	246001	ULB							94	486	486	900		5	45	0.02	(28.0)	1500	70	N2 Stripping gas at 285 kg/h to TEG (change from 170 kg/h) + blanketing requirements	C		
ISBL	OSBL	DWS Demin Water Supply				BW	IN	L	246.101		6	WI	246001	UJB	H /	xx	ET / 10				184,890	203,400	203,400	416		22		0.95	997.9	1700	70		C		
<b>Unit 246 Quest - Underground Utilities Lines - East Side of Unit 246</b>																																			
ISBL	OSBL	CWR Cooling Water Return				BW	OUT	L	246.025		30	CWR	246018	UAB							5,700,134	5,832,003	6,079,878	340		42		0.63	991.5	1200	58	Line is Underground outside of Unit 246	C		
ISBL	OSBL	CWS Cooling Water Supply				BW	IN	L	246.024		30	CWS	246001	UAB							5,700,134	5,832,003	6,079,878	420		25		0.89	997.2	800	58	Line is Underground outside of Unit 246	C		

FORMAT A1

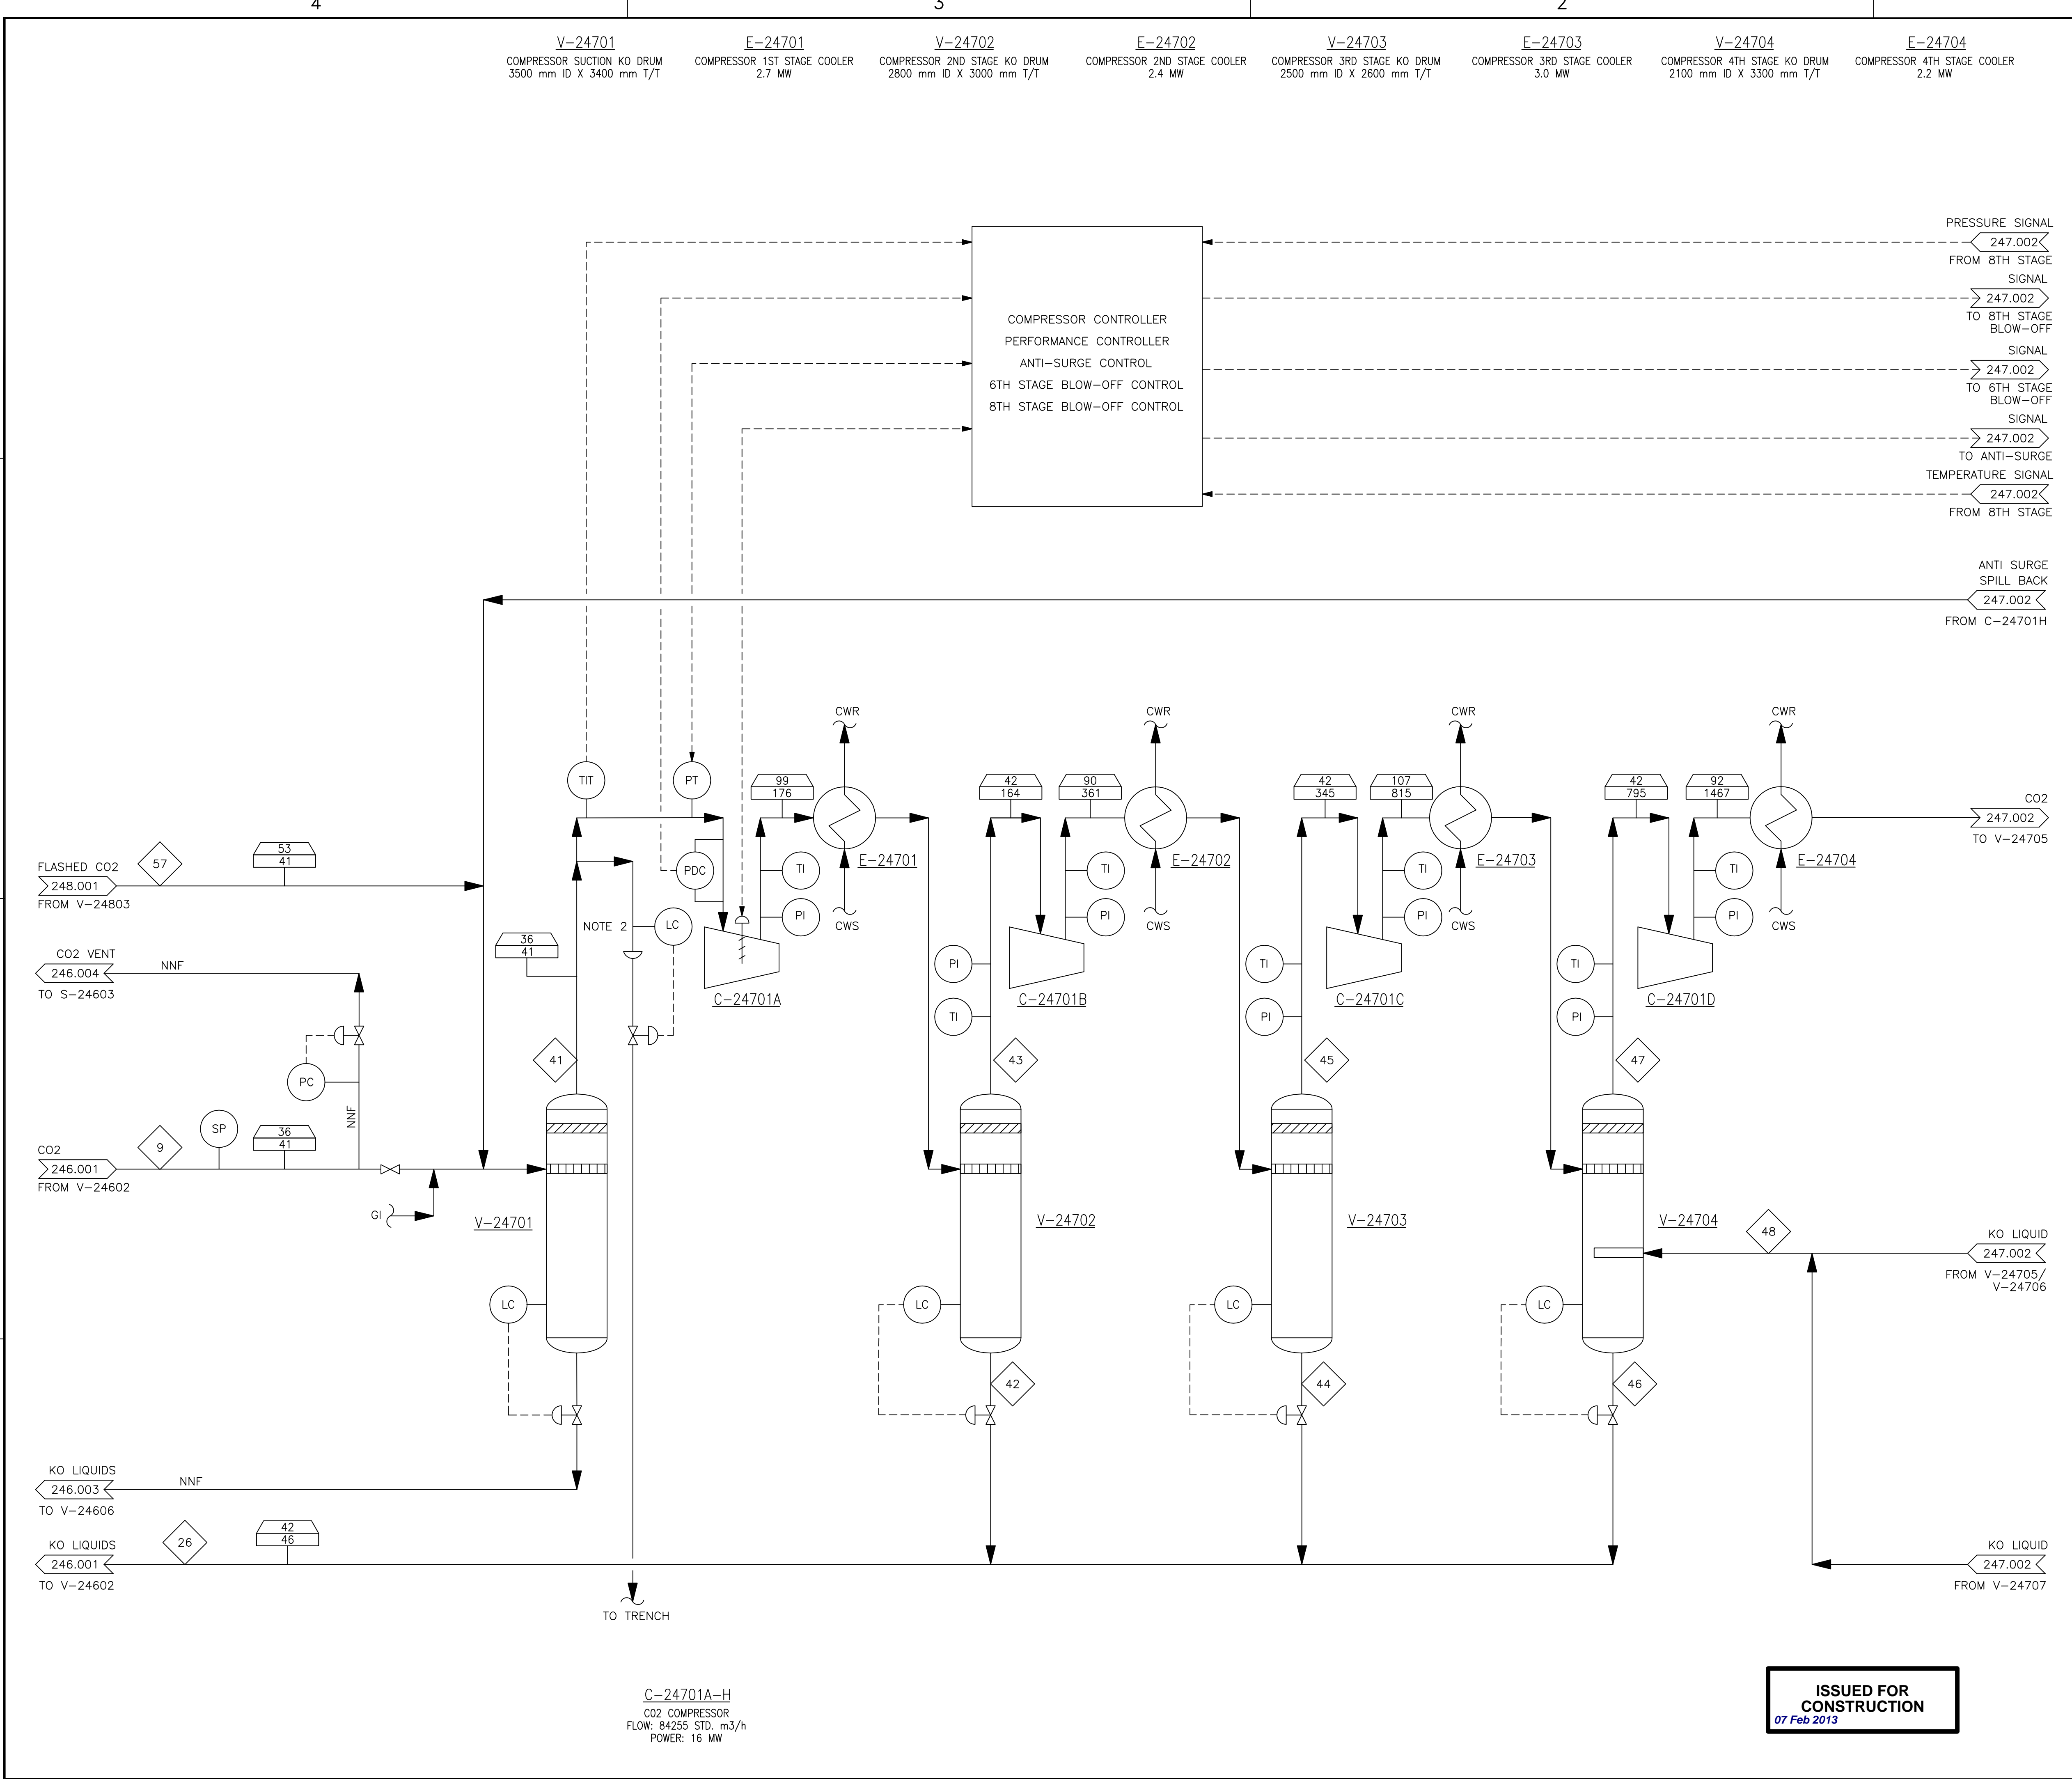

- NOTES**
- REFER TO HEAT AND MATERIAL BALANCE, DOCUMENT NUMBER 246.0001.000.046.001, FOR STREAM INFORMATION.
  - LIQUID COLLECTION BOOT.

- LEGEND**
- XXX STREAM NUMBER
  - XXX TEMPERATURE, °C
  - XXX PRESSURE, kPag
  - XX,XXX FLOW, kg/h

REV	ISSUED DATE	DESCRIPTION	DWN	CHKD	ENG	APP	APP	CLNT APP
1	12/11/23	ISSUED FOR CONSTRUCTION	GB	KB	SL	KH	CV	
OB	11/08/31	RE-ISSUED FOR DESIGN	GB	SM	KH	JJ	CV	MD/SB
OA	11/03/01	RE-ISSUED FOR DESIGN	GB	SM	KH	JJ	CV	MD/SB
O	10/11/08	ISSUED FOR DESIGN	JH	QC	KH	JJ	CV	MD/SB

**SHELL CANADA**

**FLUOR**  
 PROCESS FLOW DIAGRAM  
 QUEST CCS PROJECT  
 CO2 COMPRESSION (SHEET 1)

**ISSUED FOR CONSTRUCTION**  
 07 Feb 2013

SCALE: NONE TOE DWG. No.: SHELL DWG NO.: 247.0001.000.040.001 REV. 1

V-24705 COMPRESSOR 5TH STAGE KO DRUM  
1900 mm ID X 2200 mm T/T

E-24705 COMPRESSOR 5TH STAGE COOLER  
2.4 MW

V-24706 COMPRESSOR 6TH STAGE KO DRUM  
1700 mm ID X 2000 mm T/T


E-24706 COMPRESSOR 6TH STAGE COOLER  
1.9 MW

V-24707 TEG INLET SCRUBBER  
959 mm ID X 3300 mm T/F

V-24708 COMPRESSOR 7TH STAGE KO DRUM  
959 mm ID X 3400 mm T/F

**NOTES**

1. REFER TO HEAT AND MATERIAL BALANCE, DOCUMENT NUMBER 246.001.000.046.001, FOR STREAM INFORMATION.

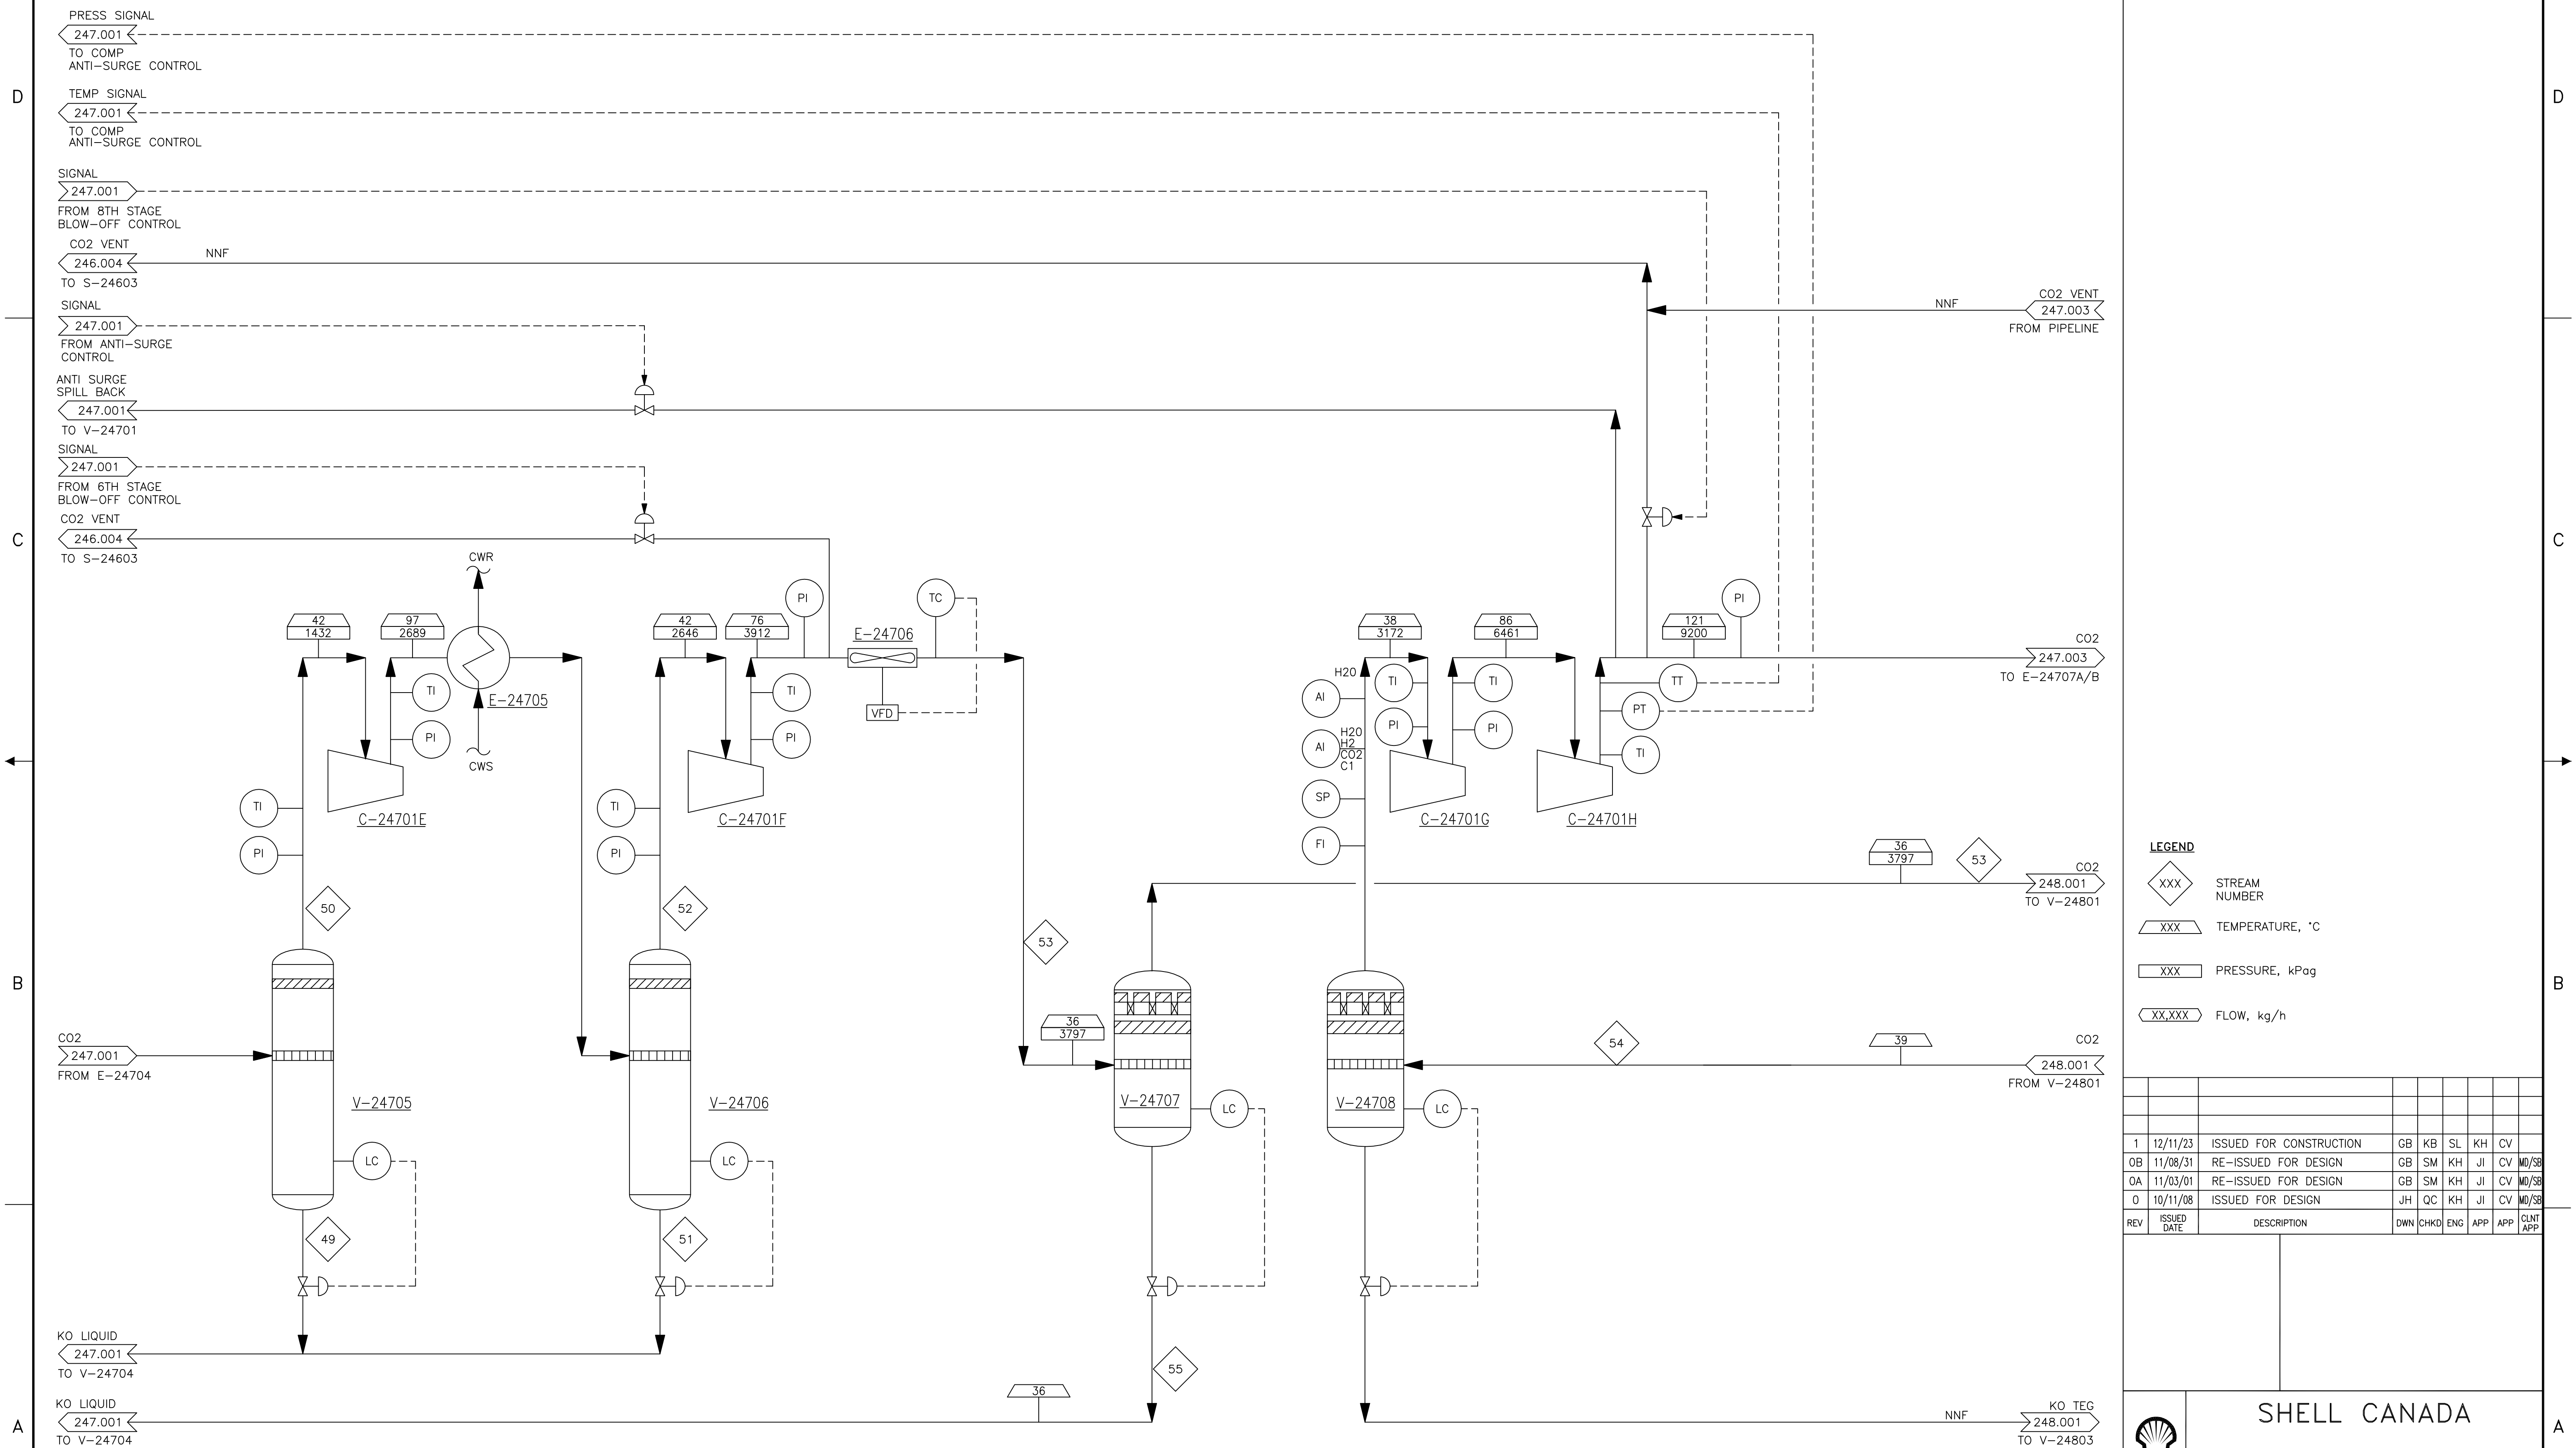

D

C

B

A

D

C

B

A

FORMAT A1

C-24701A-H  
CO2 COMPRESSOR  
FLOW: 84255 STD. m3/h  
POWER: 16 MW

**ISSUED FOR CONSTRUCTION**  
07 Feb 2013

**LEGEND**


XXX STREAM NUMBER

XXX TEMPERATURE, °C

XXX PRESSURE, kPag

XX,XXX FLOW, kg/h

1	12/11/23	ISSUED FOR CONSTRUCTION	GB	KB	SL	KH	CV
OB	11/08/31	RE-ISSUED FOR DESIGN	GB	SM	KH	JI	CV MD/SB
OA	11/03/01	RE-ISSUED FOR DESIGN	GB	SM	KH	JI	CV MD/SB
O	10/11/08	ISSUED FOR DESIGN	JH	QC	KH	JI	CV MD/SB
REV	ISSUED DATE	DESCRIPTION	DWN	CHKD	ENG	APP	APP CLNT APP

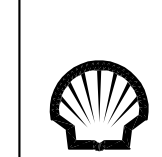

SHELL CANADA

**FLUOR**

PROCESS FLOW DIAGRAM  
QUEST CCS PROJECT  
CO2 COMPRESSION (SHEET 2)

SCALE: NONE TOE DWG. No.: SHELL DWG NO.: 247.0001.000.040.002 REV. 1



4

3

2


1

E-24707A/B  
CO2 COMPRESSOR AFTERCOOLER  
7.1 MW

S-24902  
PIPELINE PIG LAUNCHER

NOTES

- 1. REFER TO HEAT AND MATERIAL BALANCE, DOCUMENT NUMBER 246.0001.000.046.001, FOR STREAM INFORMATION.
- 2. PIG LAUNCH VENT.

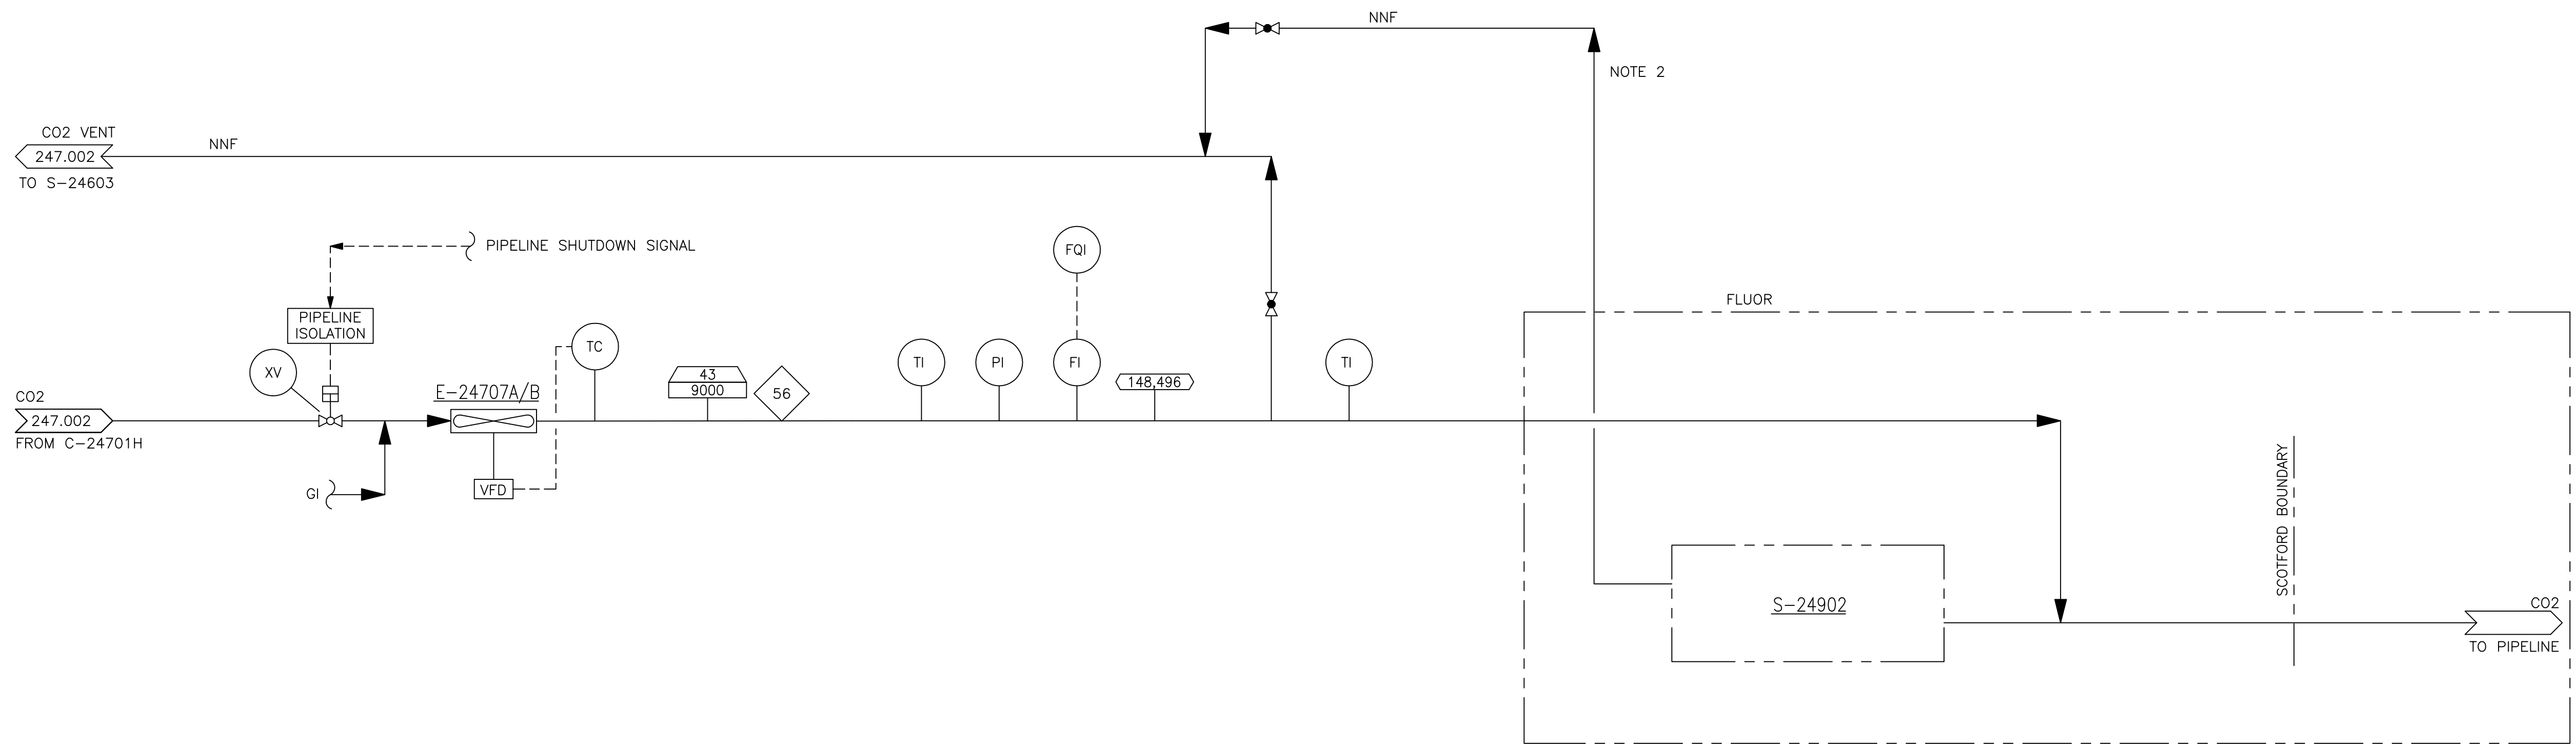

LEGEND

- ◇ XXX STREAM NUMBER
- ▭ XXX TEMPERATURE, °C
- ▭ XXX PRESSURE, kPag
- ▭ XX,XXX FLOW, kg/h

1	12/11/23	ISSUED FOR CONSTRUCTION	GB	KB	SL	KH	CV	
OB	11/08/31	RE-ISSUED FOR DESIGN	GB	SM	KH	JJ	CV	MD/SB
OA	11/03/01	RE-ISSUED FOR DESIGN	GB	SM	KH	JJ	CV	MD/SB
O	10/11/08	ISSUED FOR DESIGN	JH	QC	KH	JJ	CV	MD/SB
REV	ISSUED DATE	DESCRIPTION	DWN	CHKD	ENG	APP	APP	CLNT APP



SHELL CANADA

FLUOR

PROCESS FLOW DIAGRAM  
QUEST CCS PROJECT  
CO2 METERING STATION & PIG LAUNCHER


ISSUED FOR CONSTRUCTION  
07 Feb 2013

SCALE: NONE TOE DWG. No.: SHELL DWG NO.: 247.0001.000.040.003 REV. 1

FORMAT A1

- S-24802 TEG MAKE-UP PACKAGE
- V-24801 TEG ABSORBER 1500 mm ID X 10200 mm T/T
- E-24804A-E LEAN TEG COOLER 0.19 MW
- V-24804A/B LEAN TEG FILTER 4.8 m3/h
- V-24803 TEG FLASH DRUM 2000 mm ID X 5000 mm T/T
- E-24803 LEAN/RICH TEG EXCHANGER 0.46 MW
- E-24801 TEG STRIPPER CONDENSER 0.069 MW NOTE 3
- V-24802 TEG STRIPPER STILL: 560 mm ID X 4740 mm T/T STRIPPER: 560 mm ID X 2850 mm T/T NOTE 3
- E-24802 TEG STRIPPER REBOILER 0.28 MW NOTE 3
- V-24806 TEG SURGE DRUM 1300 mm ID X 3900 mm T/T NOTE 3
- V-24805 TEG STRIPPER REBOILER CONDENSATE POT 600 mm ID X 1800 mm T/T
- TK-24801 TEG MAKE-UP TANK 2 m3
- TK-24802 TEG DRAIN TANK 1 m3
- V-24807 LEAN TEG CARBON FILTER 1.2 m3/h
- V-24808 LEAN TEG POST FILTER 1.2 m3/h
- S-24801 TEG REGENERATION PACKAGE

- NOTES**
- REFER TO HEAT AND MATERIAL BALANCE, DOCUMENT NUMBER 246.0001.000.046.001, FOR STREAM INFORMATION.
  - THE LEAN TEG PUMPS (P-24801A/B) ARE POSITIVE DISPLACEMENT PUMPS WITH SUCTION STABILIZERS AND DISCHARGE DAMPENERS.
  - EQUIPMENT ITEMS V-24802, V-24806, E-24801, AND E-24802 ARE PART OF VENDOR PACKAGE S-24801.
  - TOTE TANK AND P-24802 ARE PART OF VENDOR PACKAGE S-24802.

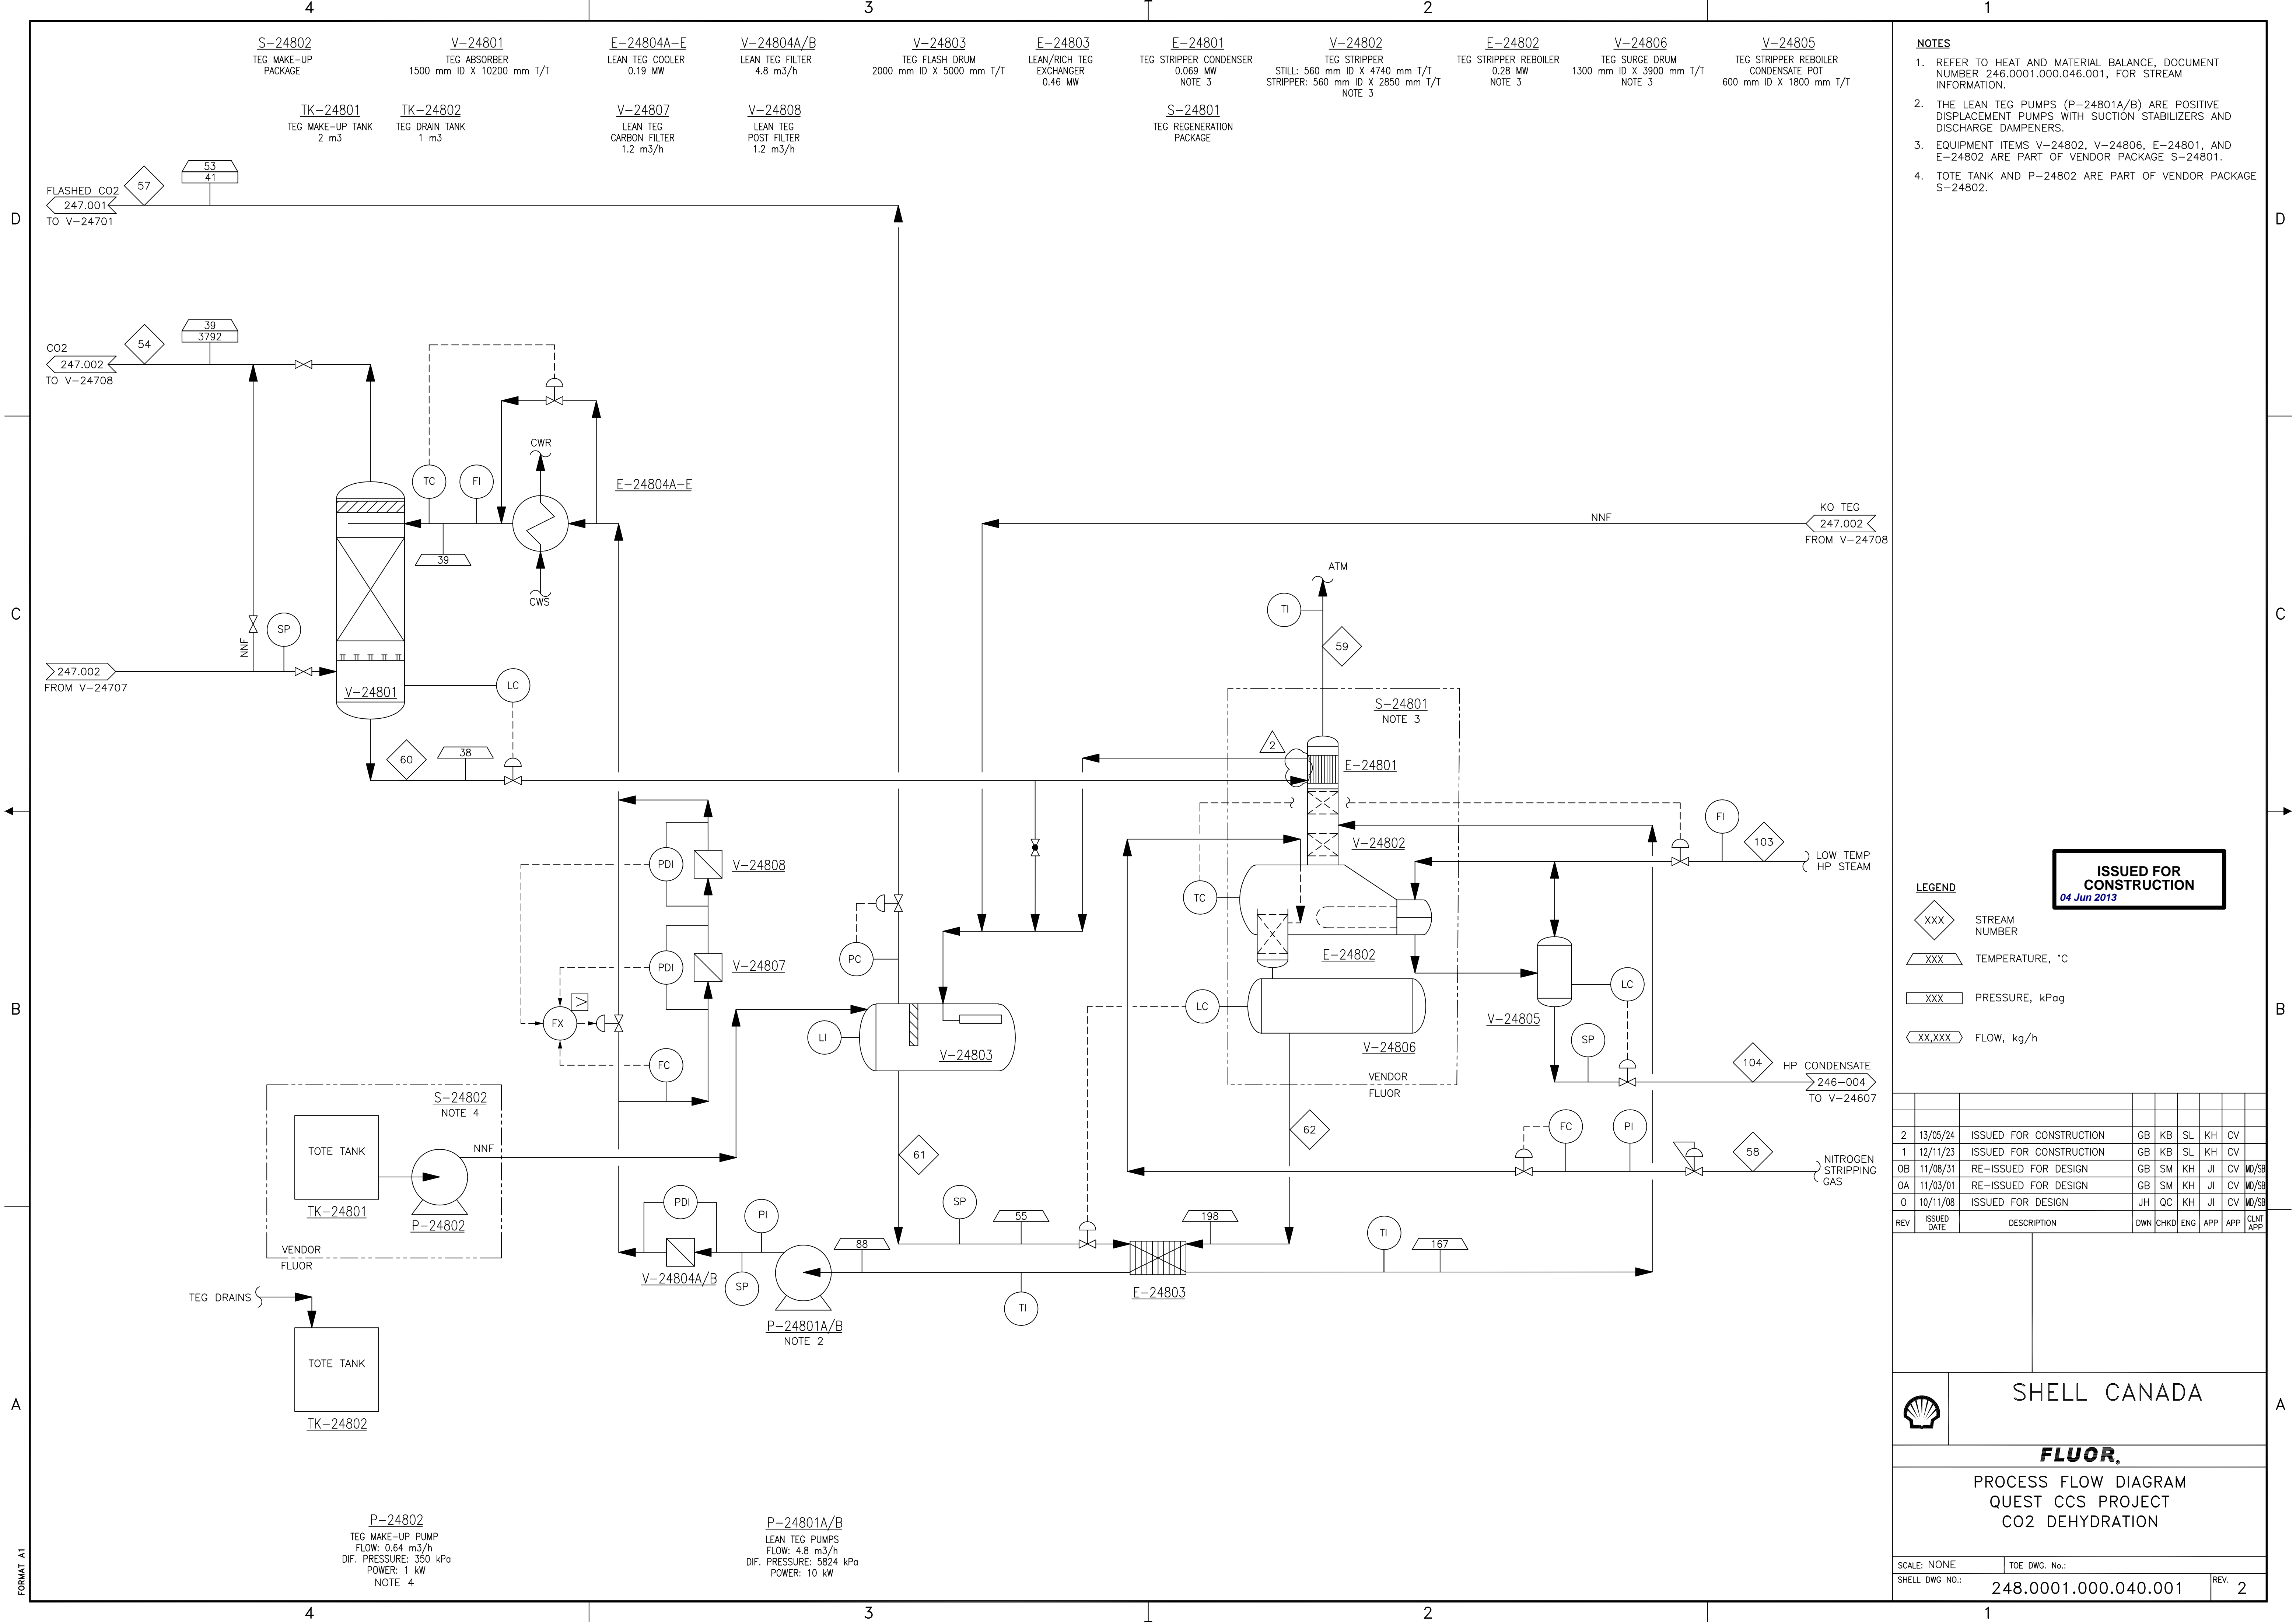

- LEGEND**
- XXX STREAM NUMBER
  - XXX TEMPERATURE, °C
  - XXX PRESSURE, kPag
  - XX,XXX FLOW, kg/h

**ISSUED FOR CONSTRUCTION**  
04 Jun 2013

REV	ISSUED DATE	DESCRIPTION	DWN	CHKD	ENG	APP	APP	CLNT	APP
2	13/05/24	ISSUED FOR CONSTRUCTION	GB	KB	SL	KH	CV		
1	12/11/23	ISSUED FOR CONSTRUCTION	GB	KB	SL	KH	CV		
0B	11/08/31	RE-ISSUED FOR DESIGN	GB	SM	KH	JL	CV	MD/58	
0A	11/03/01	RE-ISSUED FOR DESIGN	GB	SM	KH	JL	CV	MD/58	
0	10/11/08	ISSUED FOR DESIGN	JH	QC	KH	JL	CV	MD/58	

**SHELL CANADA**

**FLUOR**

PROCESS FLOW DIAGRAM  
QUEST CCS PROJECT  
CO2 DEHYDRATION

SCALE: NONE TOE DWG. No.: SHELL DWG NO.: 248.0001.000.040.001 REV. 2

FORMAT A1

SP-24901  
 PIG LAUNCHER  
 SIZE: 16" OD X 21'-6" (MAJOR BARREL)  
 SIZE: 12" OD X 40" (MINOR BARREL)

- NOTES**
1. PV REGULATES CO<sub>2</sub> FOR P/L FILL AND BLOW-DOWN THROUGH VENT STACKS.
  2. PRIMARY INSTRUMENTATION AS SHOWN IS REMOTELY TIED TO SCOTFORD VIA SCADA.
  3. ALL LINE BREAK VALVE INSTRUMENTATION NUMBERS ARE PREFIXED WITH UNIT #249.
  4. ALL VENTS TO SAFE LOCATION.
  5. ISBL CONSTRUCTION TO OCCUR BEFORE PIPELINE CONSTRUCTION. PIPE TO BE CAPPED AND MARKED FOR PIPELINE TIE-IN.
  6. DATA PROVIDED IS AFTER DEPRESSURIZING PIG LAUNCHER TO 2000 kPag.


**KEY PLAN**

**REFERENCE DRAWINGS**

1. HEAT AND MATERIAL BALANCE TABLE (249.0000.000.046.001)

**LEGEND**

◇ XX STREAM NUMBER

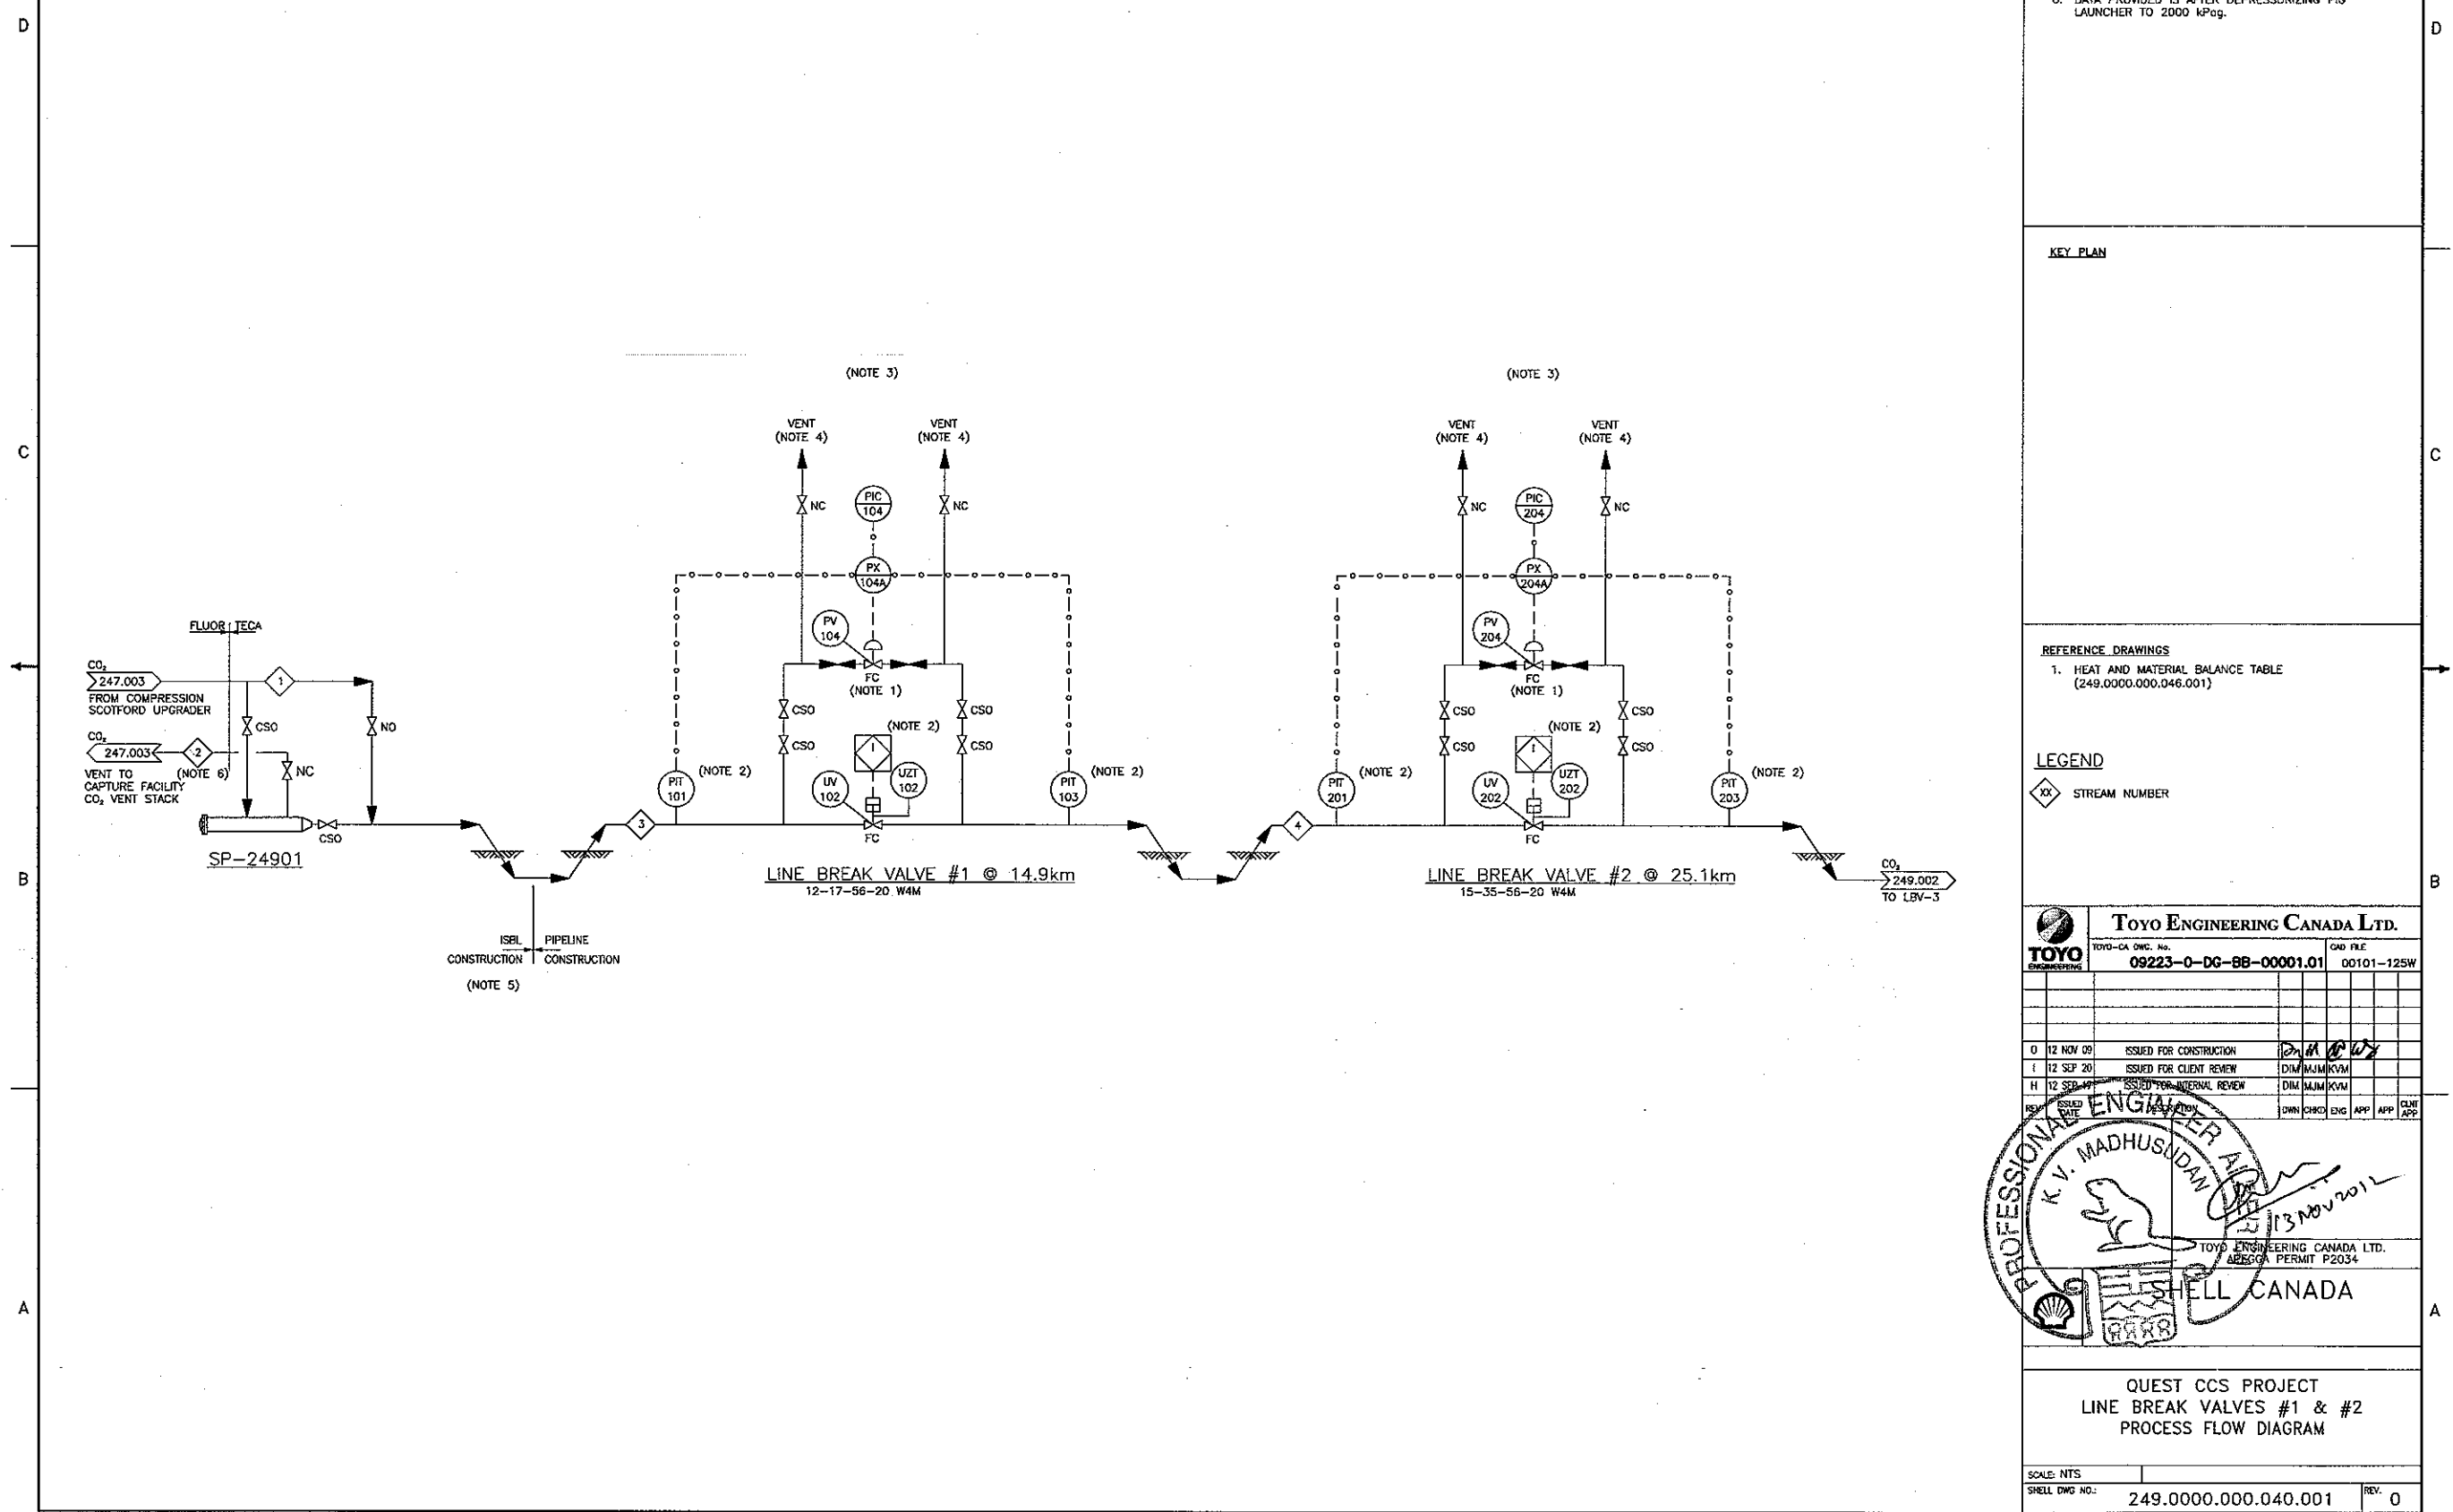

**TOYO ENGINEERING CANADA LTD.**  
 TOYO-CA INC. NO. 09223-0-DC-BB-00001.01 CAD FILE 00101-125W

0	12 NOV 09	ISSUED FOR CONSTRUCTION	DM	DM
1	12 SEP 20	ISSUED FOR CLIENT REVIEW	DIM	MAJ/KVM
H	12 SEP 11	ISSUED FOR INTERNAL REVIEW	DIM	MAJ/KVM
REV	ISSUED DATE	REVISION	DWN	CHKD ENG APP CLNT APP


**PROFESSIONAL ENGINEER**  
 K. V. MADHUSUDAN  
 13 NOV 2011  
 TOYO ENGINEERING CANADA LTD.  
 ARECA PERMIT P2034  
**SHELL CANADA**

QUEST CCS PROJECT  
 LINE BREAK VALVES #1 & #2  
 PROCESS FLOW DIAGRAM

SCALE: NTS  
 SHELL DWG NO.: 249.0000.000.040.001 REV: 0



SP-24901  
 PIG LAUNCHER  
 SIZE: 16" OD X 21'-6" (MAJOR BARREL)  
 SIZE: 12" OD X 40" (MINOR BARREL)

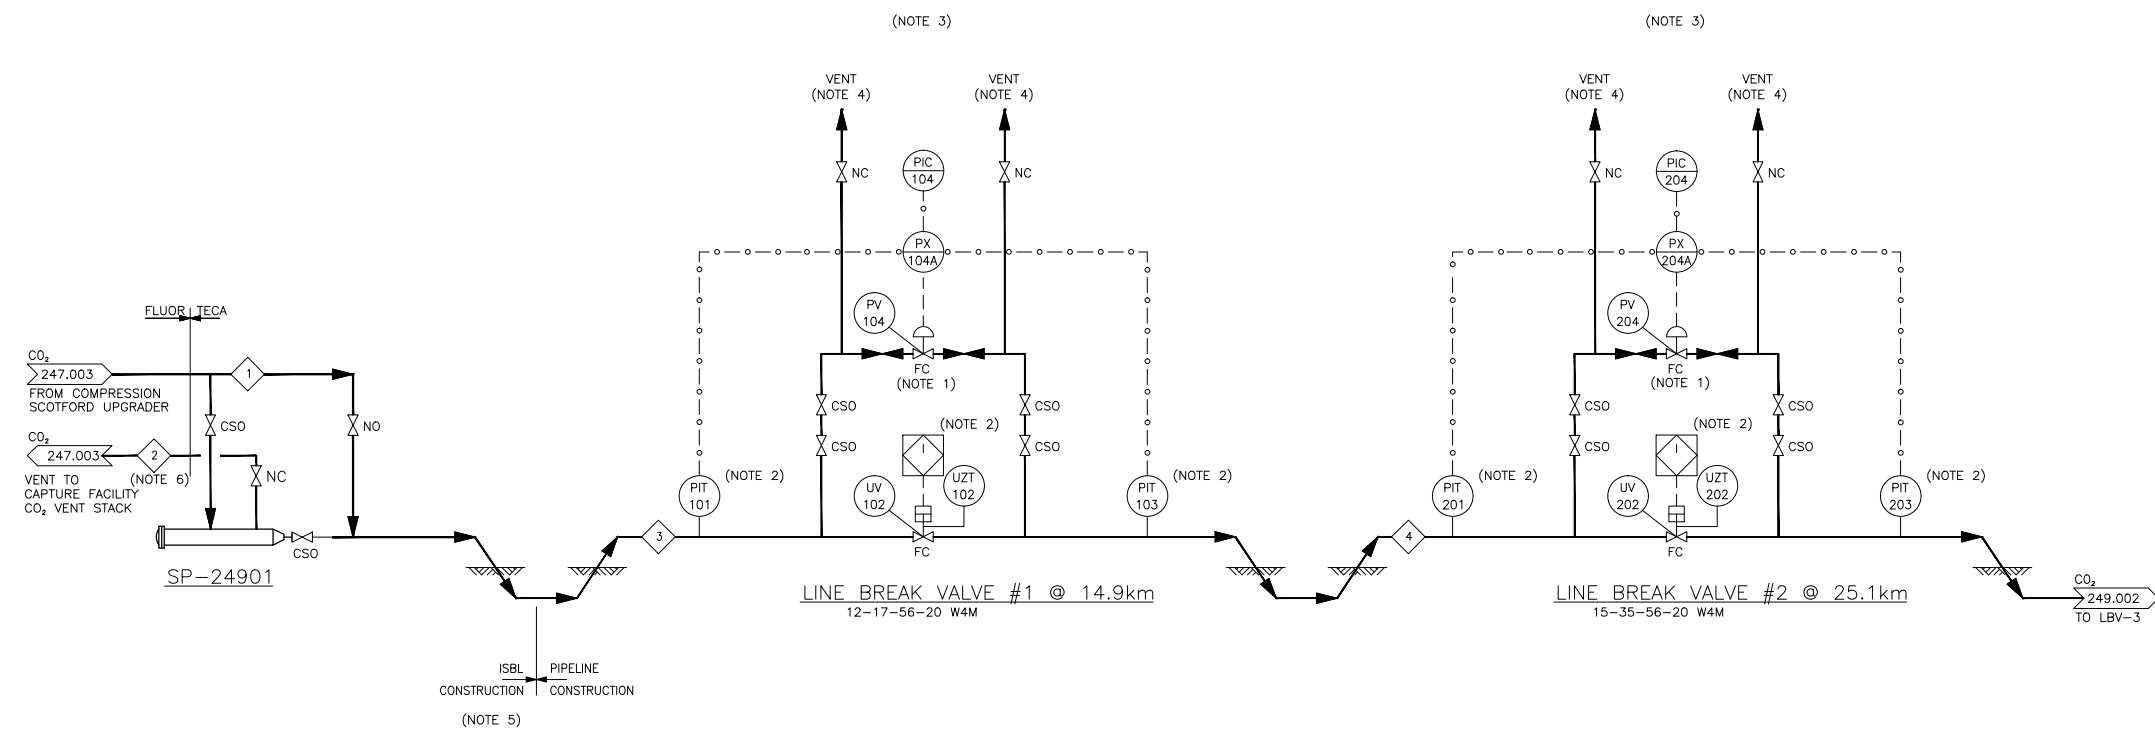

- NOTES**
1. PV REGULATES CO<sub>2</sub> FOR P/L FILL AND BLOW-DOWN THROUGH VENT STACKS.
  2. PRIMARY INSTRUMENTATION AS SHOWN IS REMOTELY TIED TO SCOTFORD VIA SCADA.
  3. ALL LINE BREAK VALVE INSTRUMENTATION NUMBERS ARE PREFIXED WITH UNIT #249.
  4. ALL VENTS TO SAFE LOCATION.
  5. ISBL CONSTRUCTION TO OCCUR BEFORE PIPELINE CONSTRUCTION. PIPE TO BE CAPPED AND MARKED FOR PIPELINE TIE-IN.
  6. DATA PROVIDED IS AFTER DEPRESSURIZING PIG LAUNCHER TO 2000 kPag.

**KEY PLAN**

- REFERENCE DRAWINGS**
1. HEAT AND MATERIAL BALANCE TABLE (249.0000.000.046.001)


**LEGEND**

◇ XX STREAM NUMBER

**TOYO ENGINEERING CANADA LTD.**  
 TOYO-CA DWG. No. **09223-0-DG-BB-00001.01** CAD FILE 00101-125W


0	12 NOV 09	ISSUED FOR CONSTRUCTION	DIM	MJM	KVM	GJJ
1	12 SEP 20	ISSUED FOR CLIENT REVIEW	DIM	MJM	KVM	
H	12 SEP 17	ISSUED FOR INTERNAL REVIEW	DIM	MJM	KVM	
REV	ISSUED DATE	DESCRIPTION	DWN	CHKD	ENG	APP

TOYO ENGINEERING CANADA LTD.  
 APEGGA PERMIT P2034

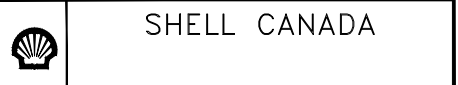

QUEST CCS PROJECT  
 LINE BREAK VALVES #1 & #2  
 PROCESS FLOW DIAGRAM

SCALE: NTS  
 SHELL DWG NO.: 249.0000.000.040.001 REV. 0

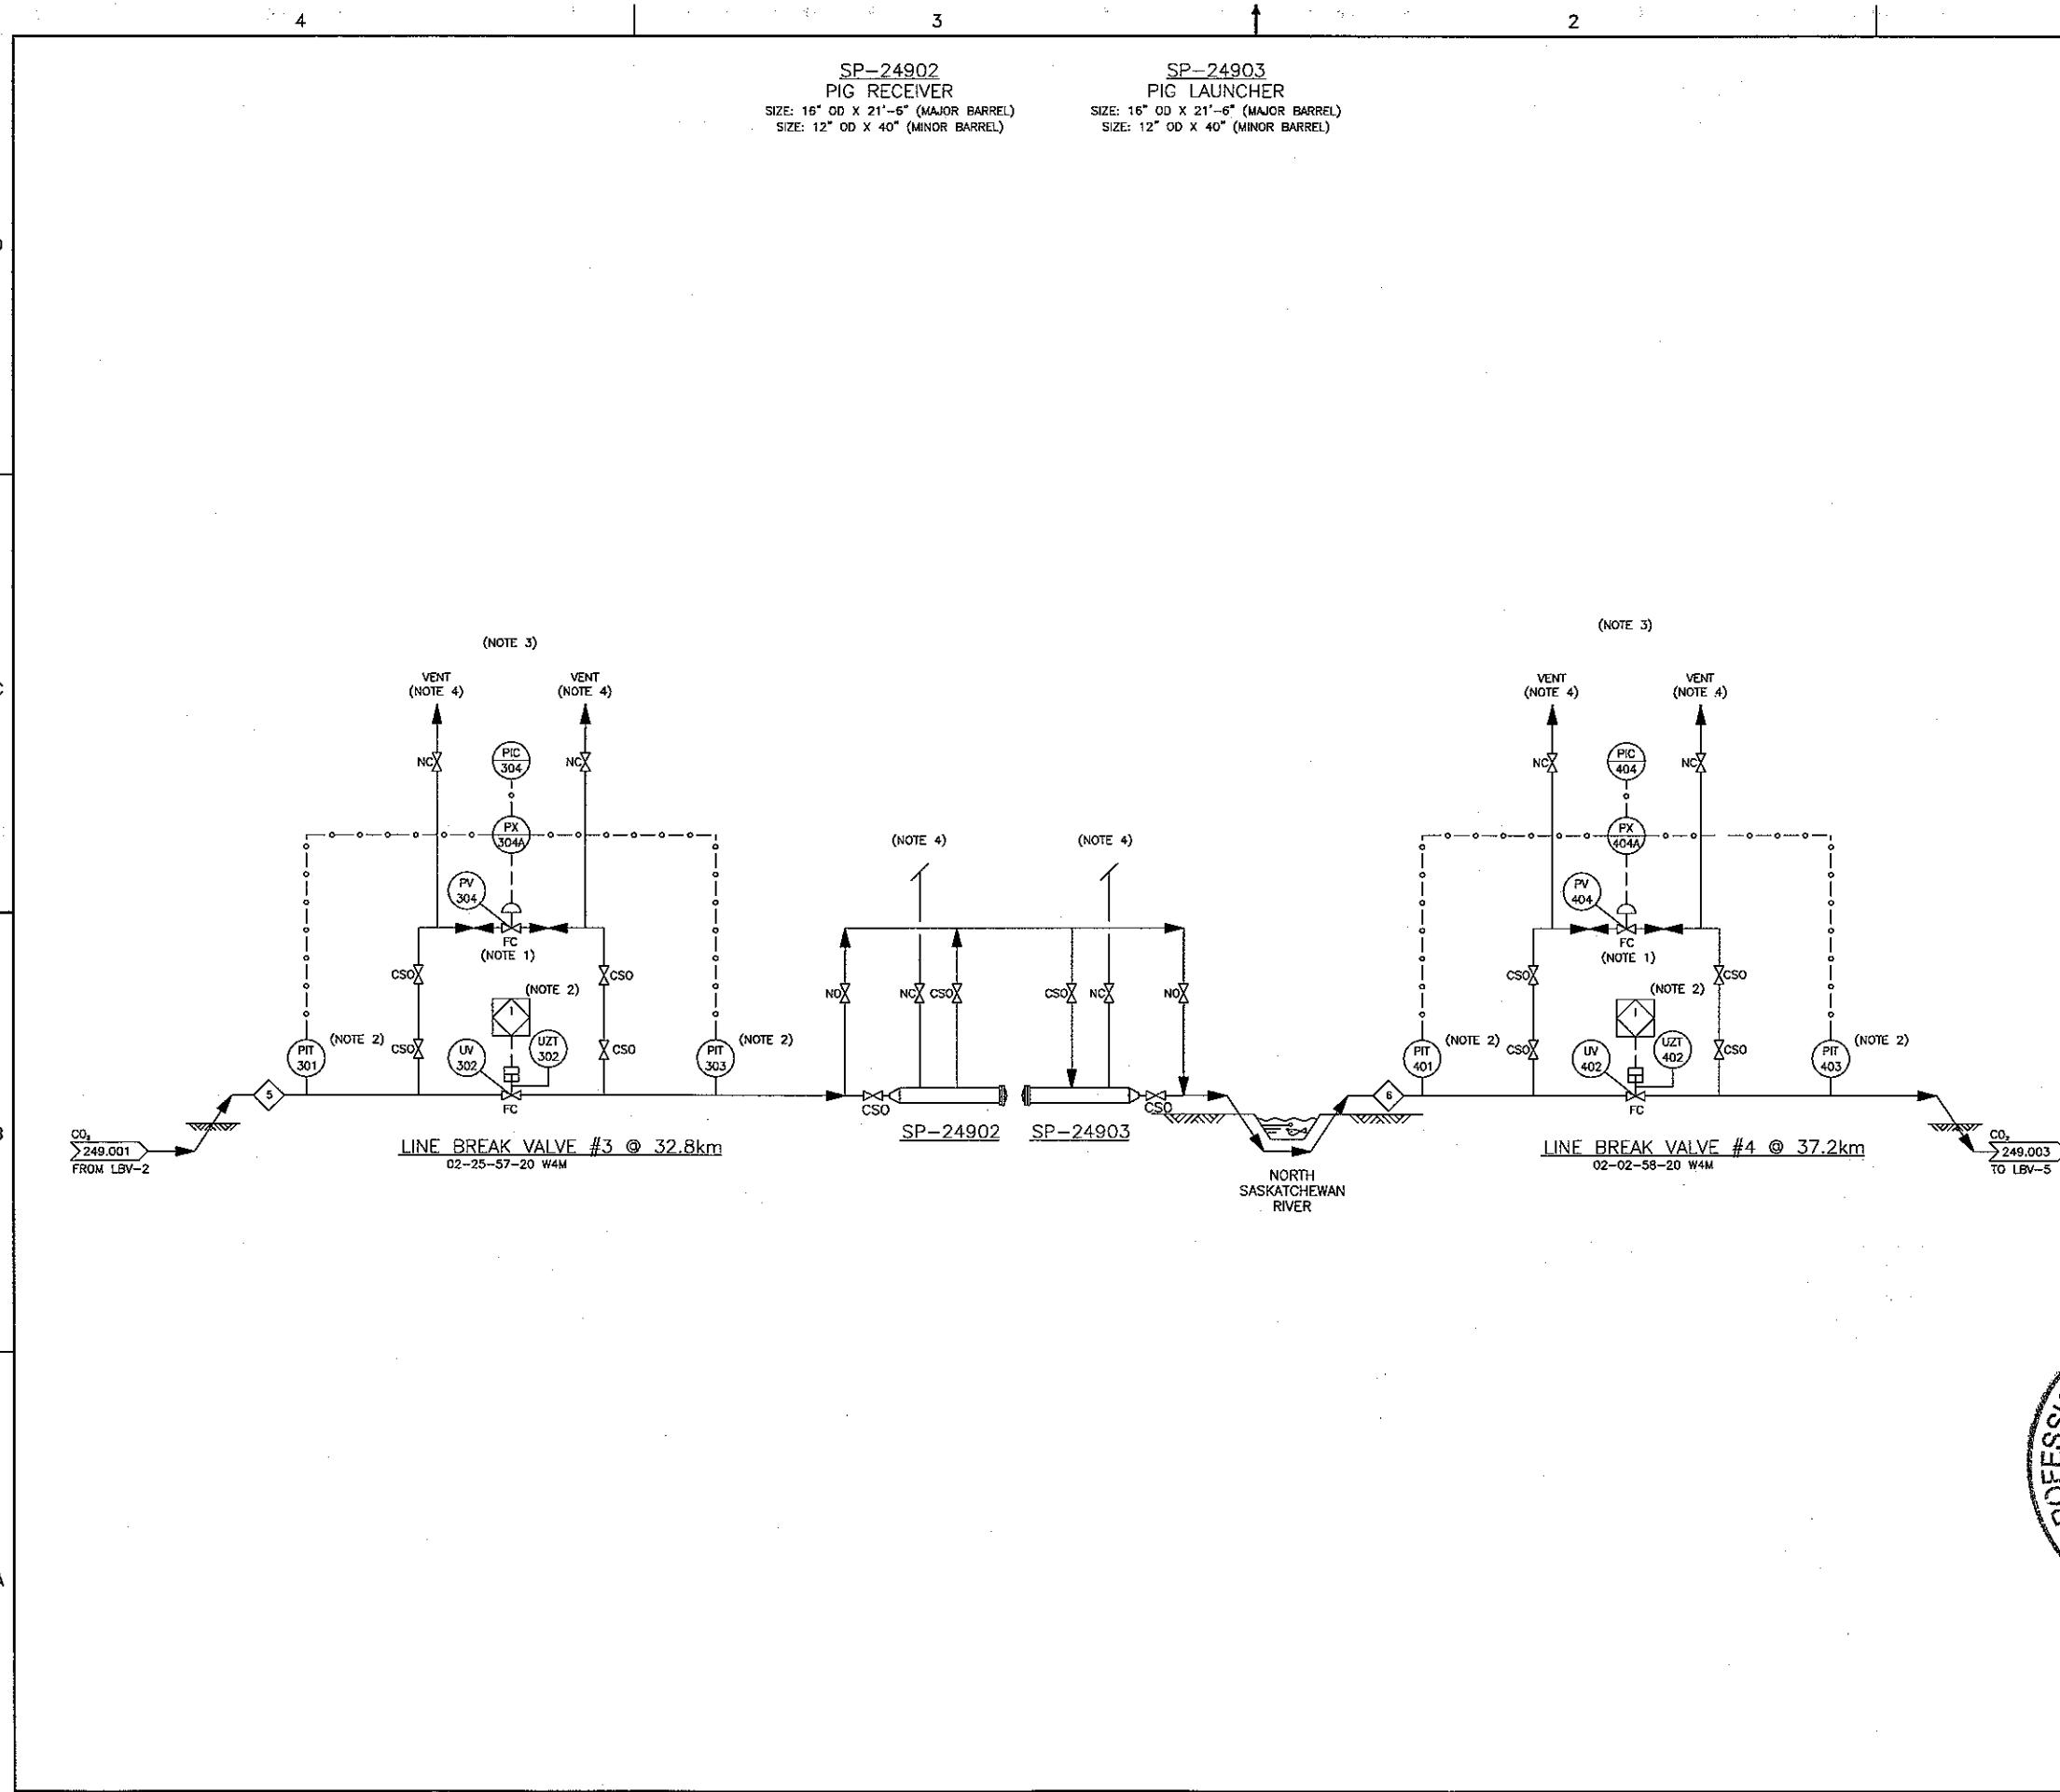

- NOTES**
1. PV REGULATES CO<sub>2</sub> FOR P/L FILL AND BLOW-DOWN THROUGH VENT STACKS.
  2. PRIMARY INSTRUMENTATION AS SHOWN IS REMOTELY TIED TO SCOTFORD VIA SCADA.
  3. ALL LINE BREAK VALVE INSTRUMENTATION NUMBERS ARE PREFIXED WITH UNIT #249.
  4. ALL VENTS TO SAFE LOCATION.

**KEY PLAN**

- REFERENCE DRAWINGS**
1. HEAT AND MATERIAL BALANCE TABLE (249.0000.000.046.001)

**LEGEND**

◇ XX STREAM NUMBER


**TOYO ENGINEERING CANADA LTD.**  
 TOYO-CA DWG. No. **09223-0-DG-BB-00002.01** CAD FILE 00201-1252

DATE	DESCRIPTION	DESIGNER	CHECKED	APP.	APP.
0 12 NOV 09	ISSUED FOR CONSTRUCTION	DM	MJM	KVM	BY
11 28 SEP 10	ISSUED FOR CLIENT REVIEW	DIM	MJM	KVM	
12 01 SEP 11	ISSUED FOR INTERNAL REVIEW	DIM	MJM	KVM	
	ISSUED FOR CLIENT REVIEW	DIM	MJM	KVM	
	ISSUED FOR CONSTRUCTION	DIM	MJM	KVM	

**PROFESSIONAL ENGINEER**  
**K.V. MADHUSUDAN**  
 TOYO ENGINEERING CANADA LTD.  
 AREGG PERMIT P2034  
**SHELL CANADA**

ALBERTA  
 QUEST CCS PROJECT  
 LINE BREAK VALVES #3 & #4  
 PROCESS FLOW DIAGRAM

SCALE: NTS  
 SHEET Dwg NO: **249.0000.000.040.002** REV. 0

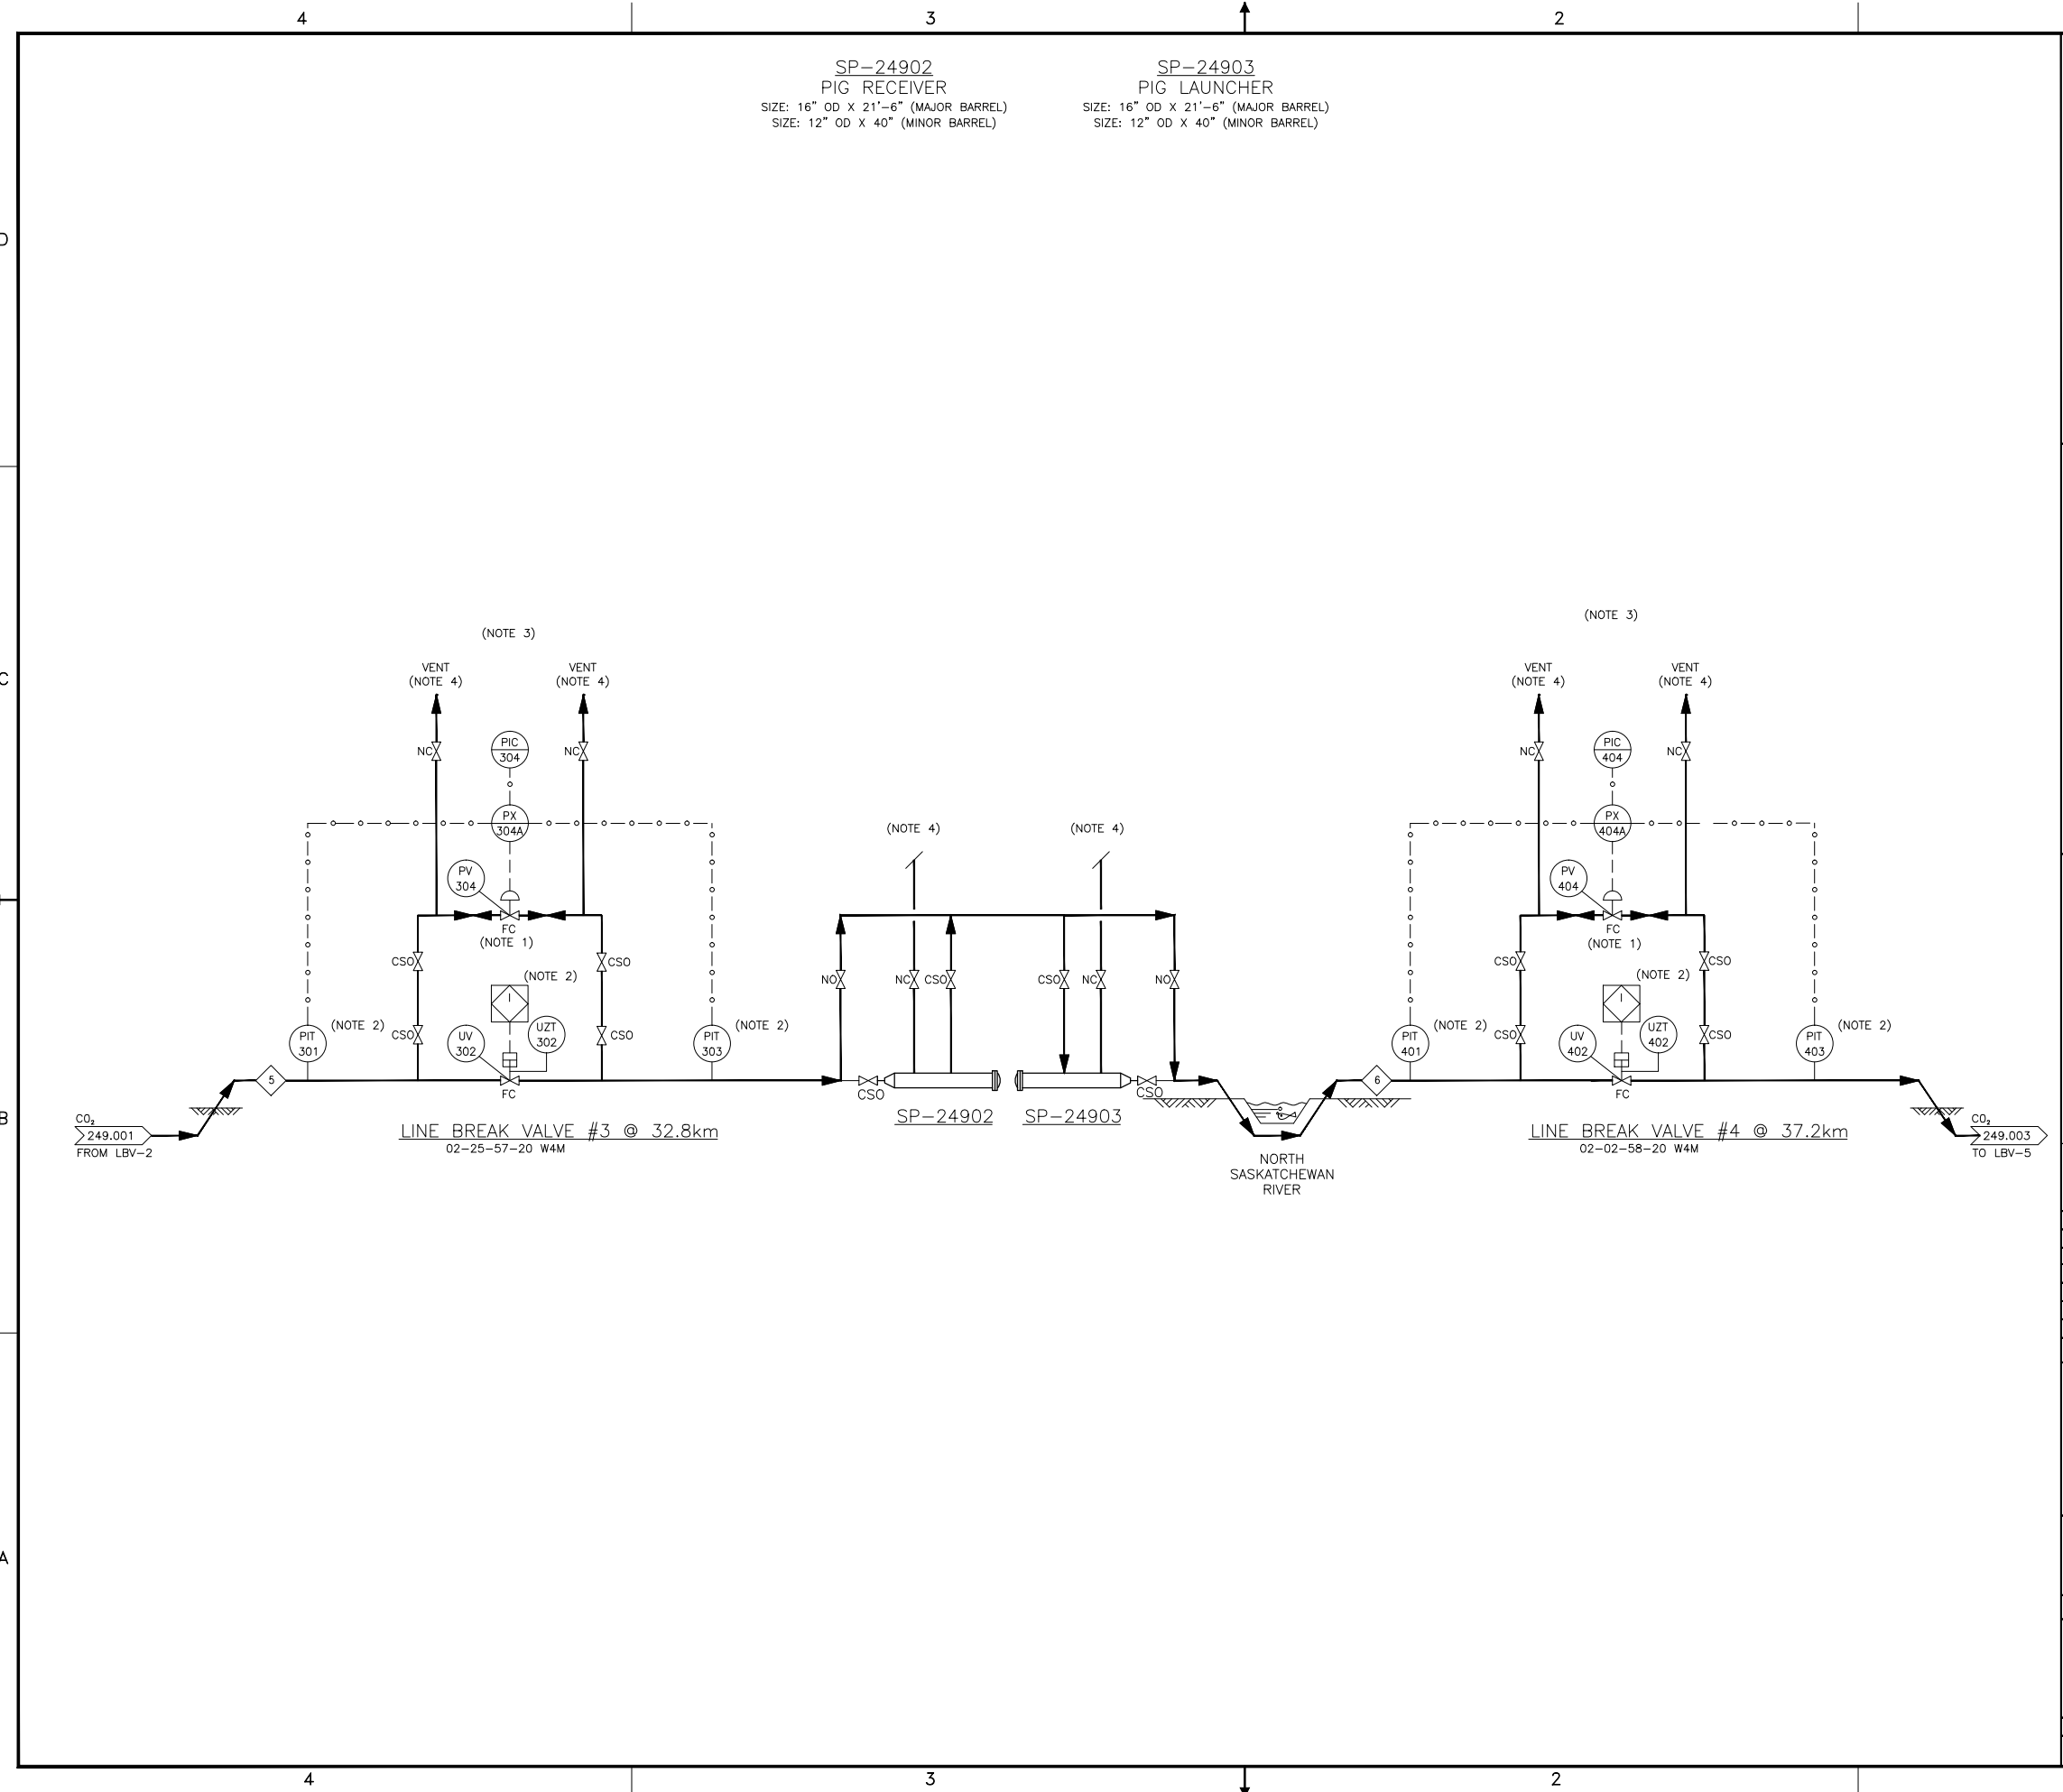

SP-24902  
PIG RECEIVER  
SIZE: 16" OD X 21'-6" (MAJOR BARREL)  
SIZE: 12" OD X 40" (MINOR BARREL)

SP-24903  
PIG LAUNCHER  
SIZE: 16" OD X 21'-6" (MAJOR BARREL)  
SIZE: 12" OD X 40" (MINOR BARREL)

- NOTES**
1. PV REGULATES CO<sub>2</sub> FOR P/L FILL AND BLOW-DOWN THROUGH VENT STACKS.
  2. PRIMARY INSTRUMENTATION AS SHOWN IS REMOTELY TIED TO SCOTFORD VIA SCADA.
  3. ALL LINE BREAK VALVE INSTRUMENTATION NUMBERS ARE PREFIXED WITH UNIT #249.
  4. ALL VENTS TO SAFE LOCATION.

**KEY PLAN**

- REFERENCE DRAWINGS**
1. HEAT AND MATERIAL BALANCE TABLE (249.0000.000.046.001)

**LEGEND**

◇ XX STREAM NUMBER

**TOYO ENGINEERING CANADA LTD.**  
TOYO-CA DWG. No. **09223-0-DG-BB-00002.01** CAD FILE 00201-125Z

REV	ISSUED DATE	DESCRIPTION	DWN	CHKD	ENG	APP	APP	CLNT APP
O	12 NOV 09	ISSUED FOR CONSTRUCTION						
H	12 SEP 20	ISSUED FOR CLIENT REVIEW						
G	12 SEP 17	ISSUED FOR INTERNAL REVIEW						


TOYO ENGINEERING CANADA LTD.  
APEGGA PERMIT P2034



ALBERTA  
QUEST CCS PROJECT  
LINE BREAK VALVES #3 & #4  
PROCESS FLOW DIAGRAM

SCALE: NTS  
SHELL DWG NO.: 249.0000.000.040.002 REV: 0



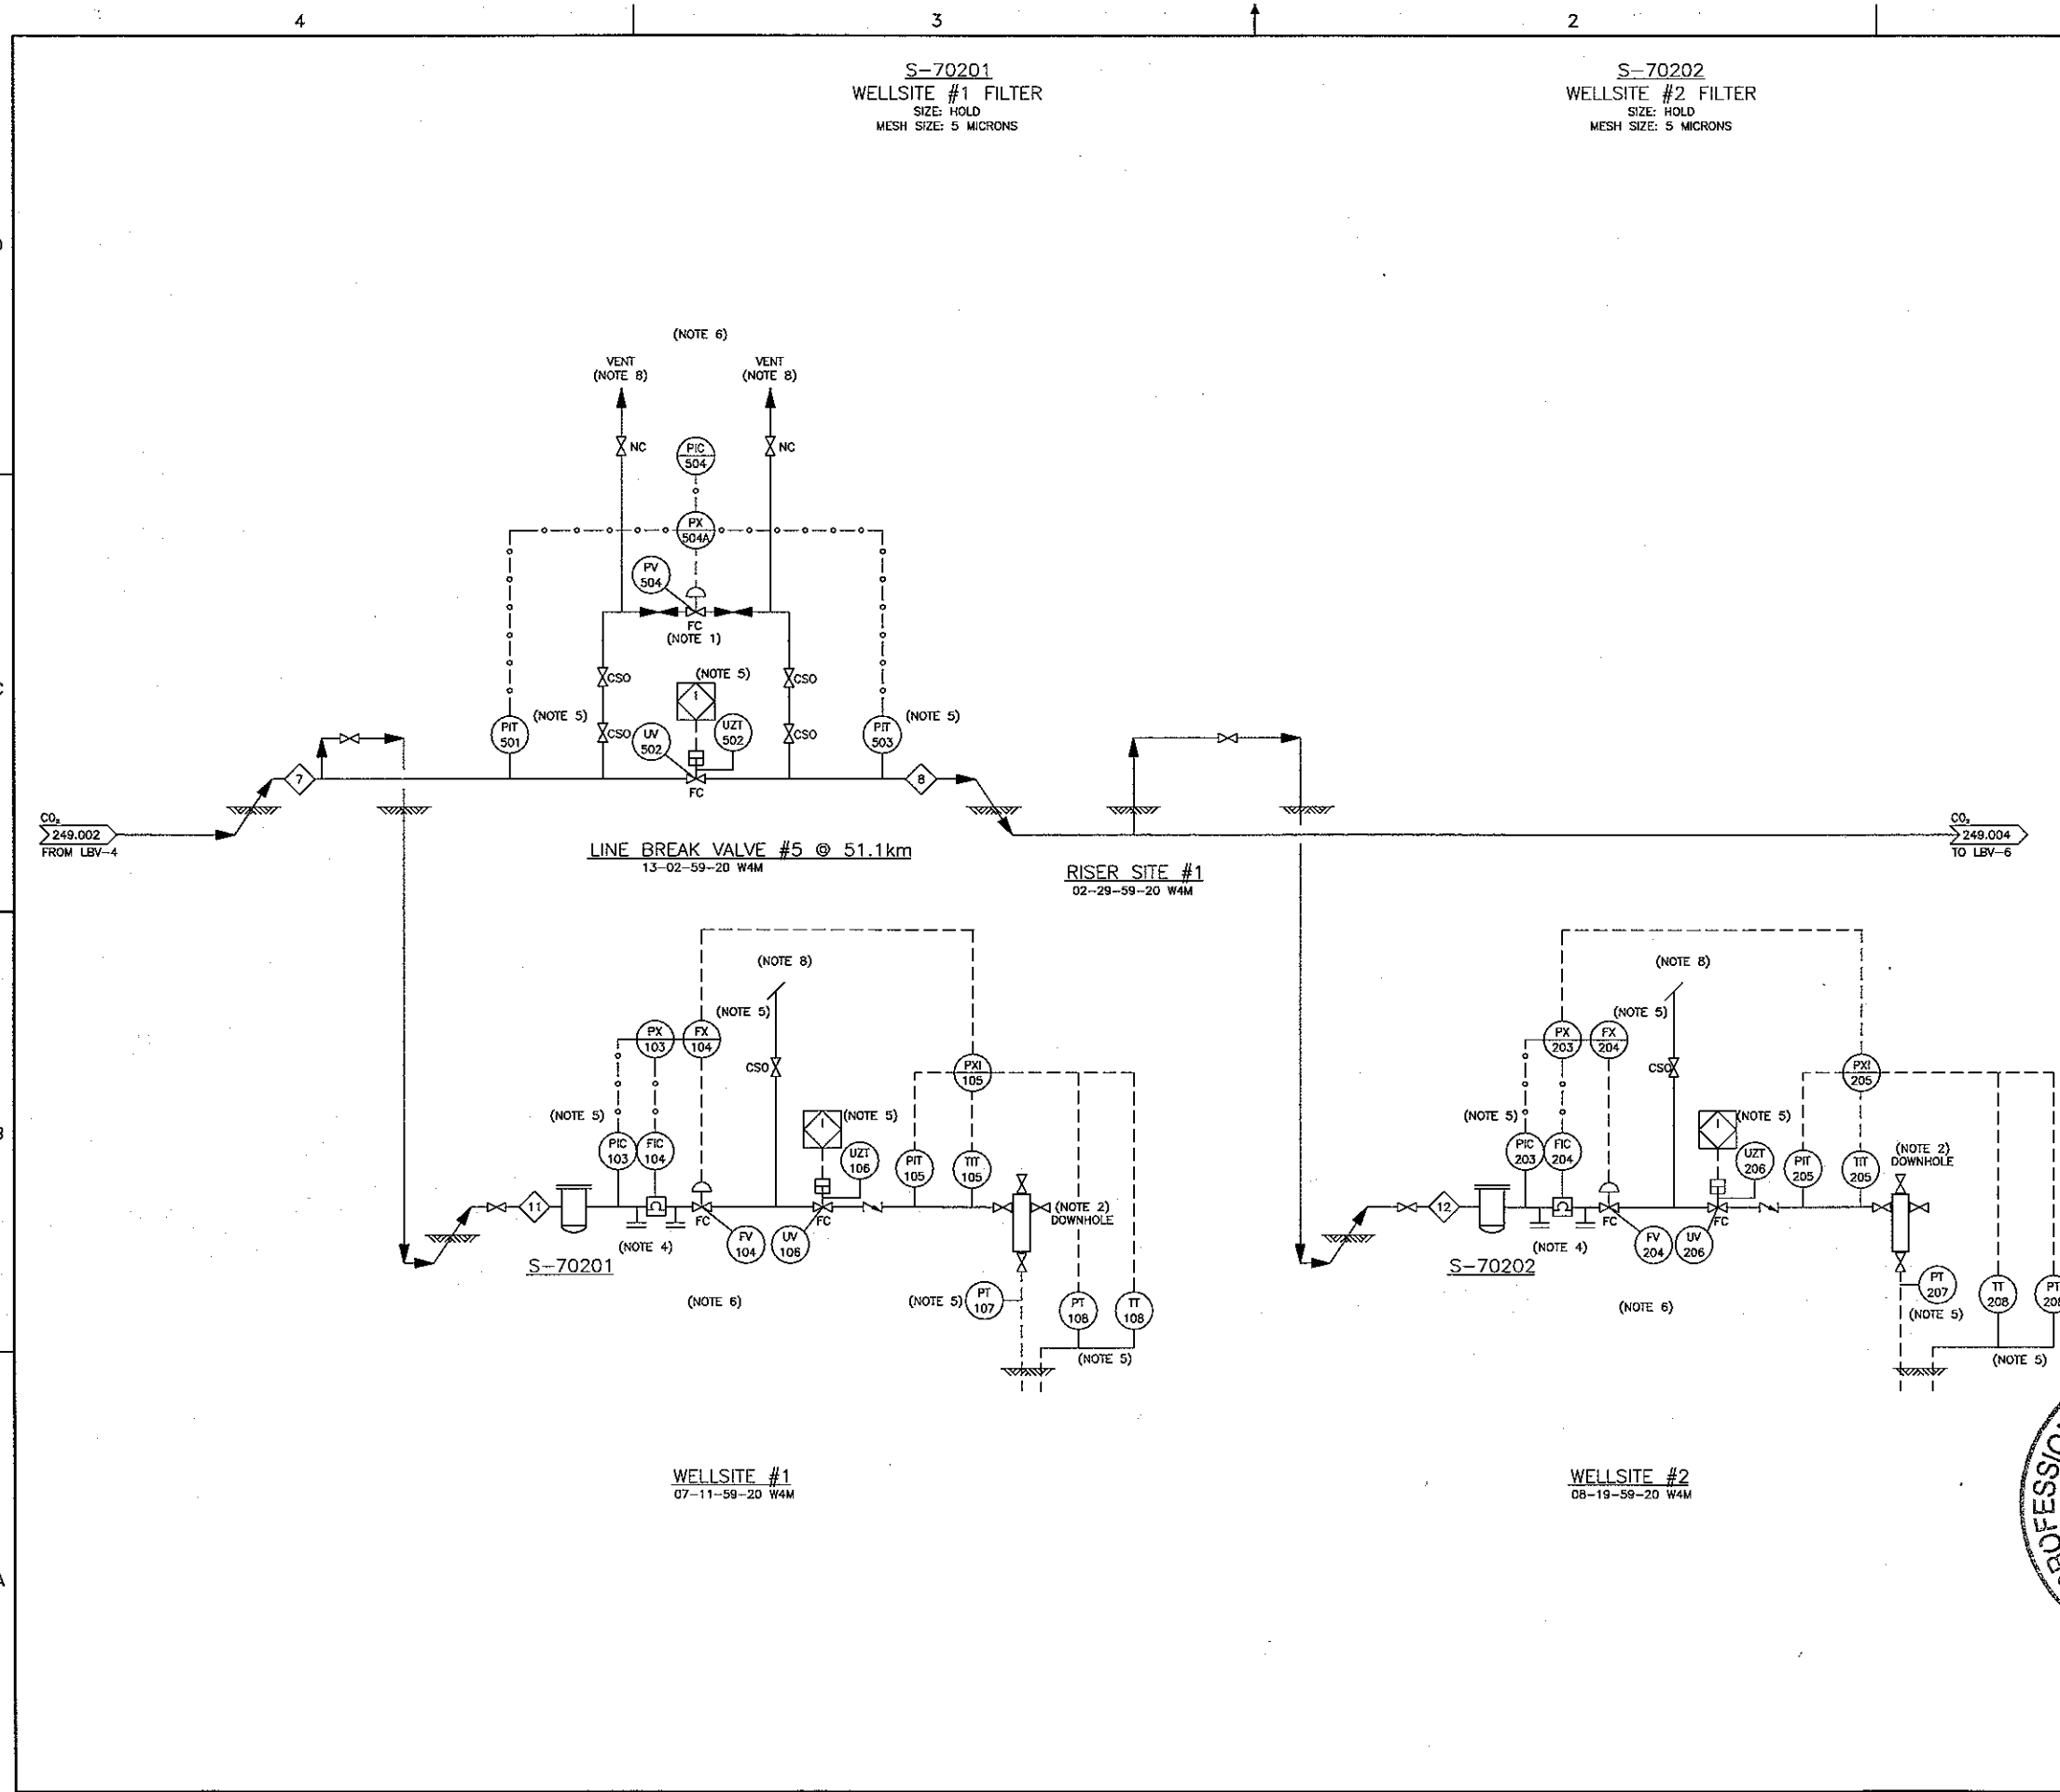

- NOTES**
1. PV REGULATES CO<sub>2</sub> FOR P/L FILL AND BLOW-DOWN THROUGH VENT STACKS.
  2. MULTI-SENSOR.
  3. DELETED.
  4. METER PROVER TAPS.
  5. PRIMARY INSTRUMENTATION AS SHOWN IS REMOTELY TIED TO SCOTTFORD VIA SCADA.
  6. ALL WELLSITE INSTRUMENTATION NUMBERS ARE PREFIXED WITH UNIT #702 AND ALL LINE BREAK VALVE INSTRUMENTATION NUMBERS ARE PREFIXED WITH UNIT #249.
  7. DELETED.
  8. ALL VENTS TO SAFE LOCATION.


**KEY PLAN**

- REFERENCE DRAWINGS**
1. HEAT AND MATERIAL BALANCE TABLE (249.0000.000.046.001)

**LEGEND**

◇X STREAM NUMBER

<b>TOYO ENGINEERING CANADA LTD.</b>							
TOYO-CA DWG. No. <b>09223-0-DG-BB-00003.01</b>	CAD FILE 00301-1261						
REV. NO.	DATE						
0	12 NOV 09						
H	12 SEP 20						
G	12 SEP 17						
REV. NO.	DATE	DESCRIPTION	DRN	CHKD	ENG	APP	APP
		ISSUED FOR CONSTRUCTION					
		ISSUED FOR CLIENT REVIEW					
		ISSUED FOR INTERNAL REVIEW					

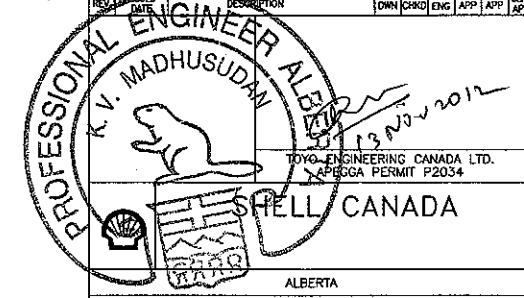


TOYO ENGINEERING CANADA LTD.  
ALBERTA PERMIT P2034

**SHELL CANADA**

ALBERTA

QUEST CCS PROJECT  
LINE BREAK VALVE #5, RISER SITE #1  
WELLSITES #1 & #2  
PROCESS FLOW DIAGRAM

SCALE: NTS  
SHELL DWG NO.: 249.0000.000.040.003 REV. 0

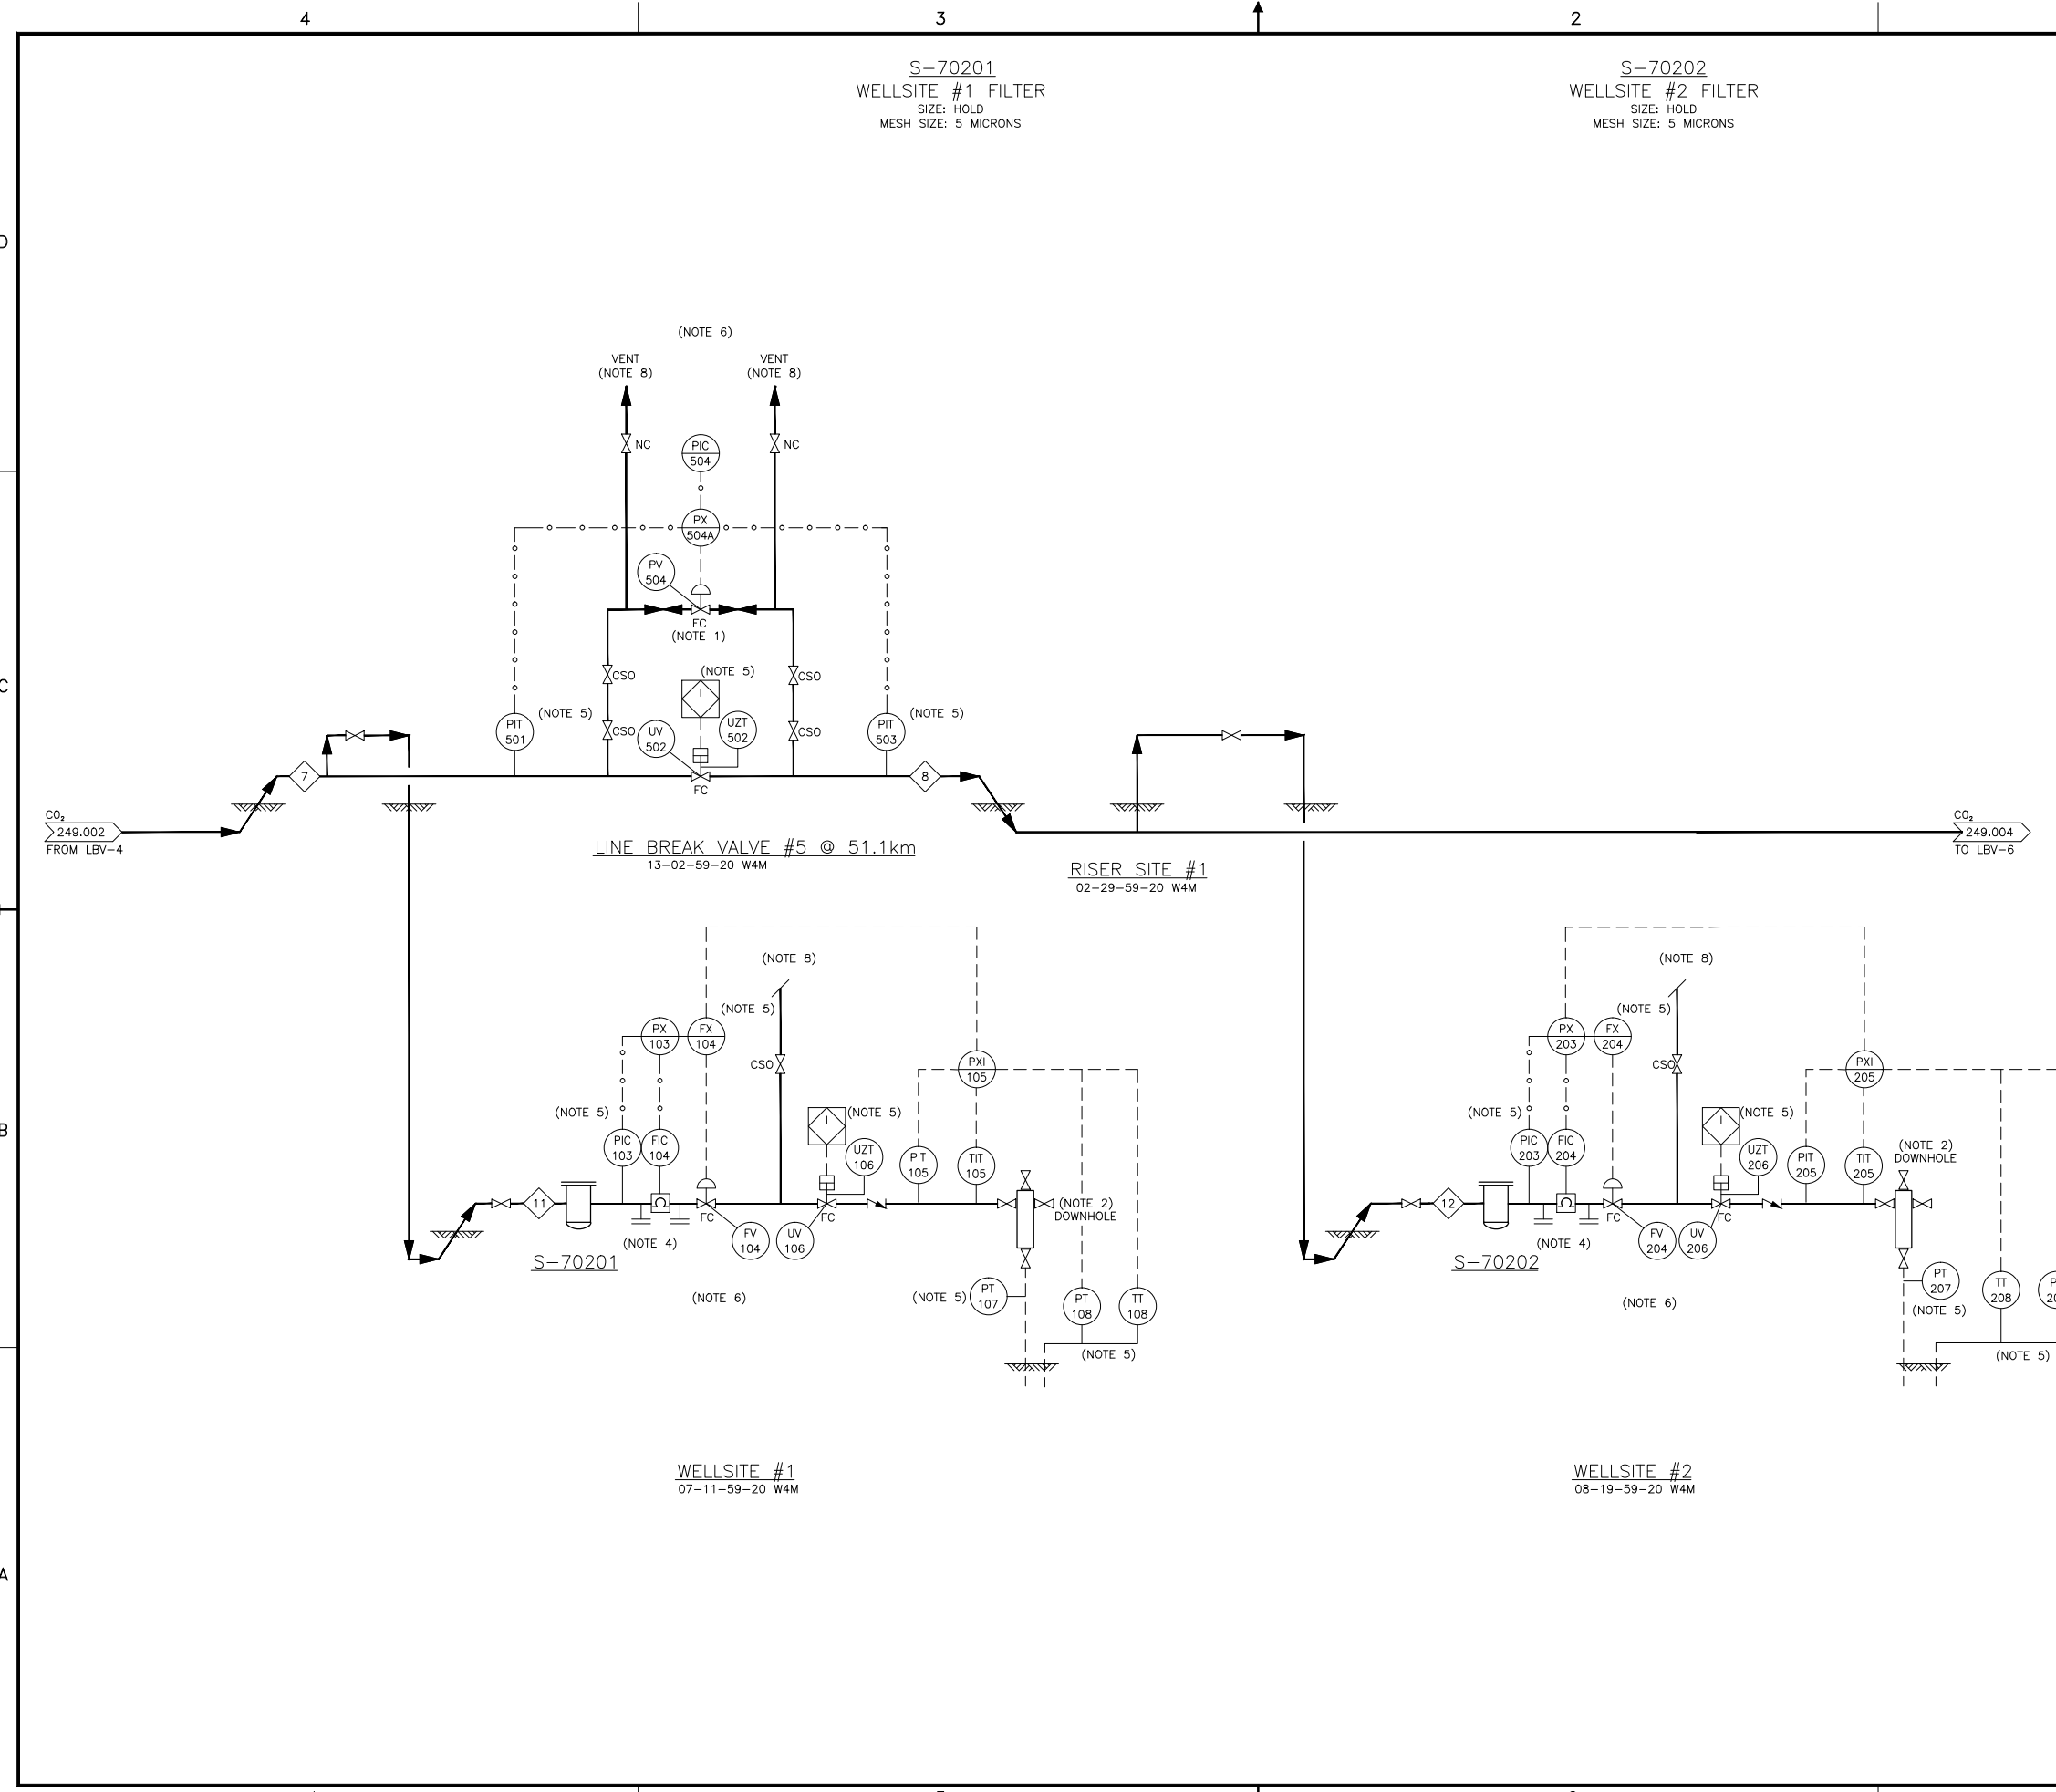

- NOTES**
1. PV REGULATES CO<sub>2</sub> FOR P/L FILL AND BLOW-DOWN THROUGH VENT STACKS.
  2. MULTI-SENSOR.
  3. DELETED.
  4. METER PROVER TAPS.
  5. PRIMARY INSTRUMENTATION AS SHOWN IS REMOTELY TIED TO SCOTFORD VIA SCADA.
  6. ALL WELLSITE INSTRUMENTATION NUMBERS ARE PREFIXED WITH UNIT #702 AND ALL LINE BREAK VALVE INSTRUMENTATION NUMBERS ARE PREFIXED WITH UNIT #249.
  7. DELETED.
  8. ALL VENTS TO SAFE LOCATION.

**KEY PLAN**

- REFERENCE DRAWINGS**
1. HEAT AND MATERIAL BALANCE TABLE (249.0000.000.046.001)


**LEGEND**

◇ XX STREAM NUMBER

**TOYO ENGINEERING CANADA LTD.**  
 TOYO-CA DWG. No. **09223-0-DG-BB-00003.01** CAD FILE 00301-1261


REV	ISSUED DATE	DESCRIPTION	DWN	CHKD	ENG	APP	APP	CLNT APP
0	12 NOV 09	ISSUED FOR CONSTRUCTION						
H	12 SEP 20	ISSUED FOR CLIENT REVIEW						
G	12 SEP 17	ISSUED FOR INTERNAL REVIEW						

TOYO ENGINEERING CANADA LTD.  
 APEGGA PERMIT P2034

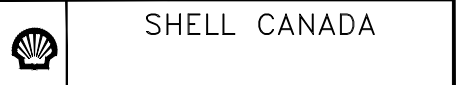

ALBERTA  
 QUEST CCS PROJECT  
 LINE BREAK VALVE #5, RISER SITE #1  
 WELLSITES #1 & #2  
 PROCESS FLOW DIAGRAM

SCALE: NTS  
 SHELL DWG NO.: 249.0000.000.040.003 REV. 0

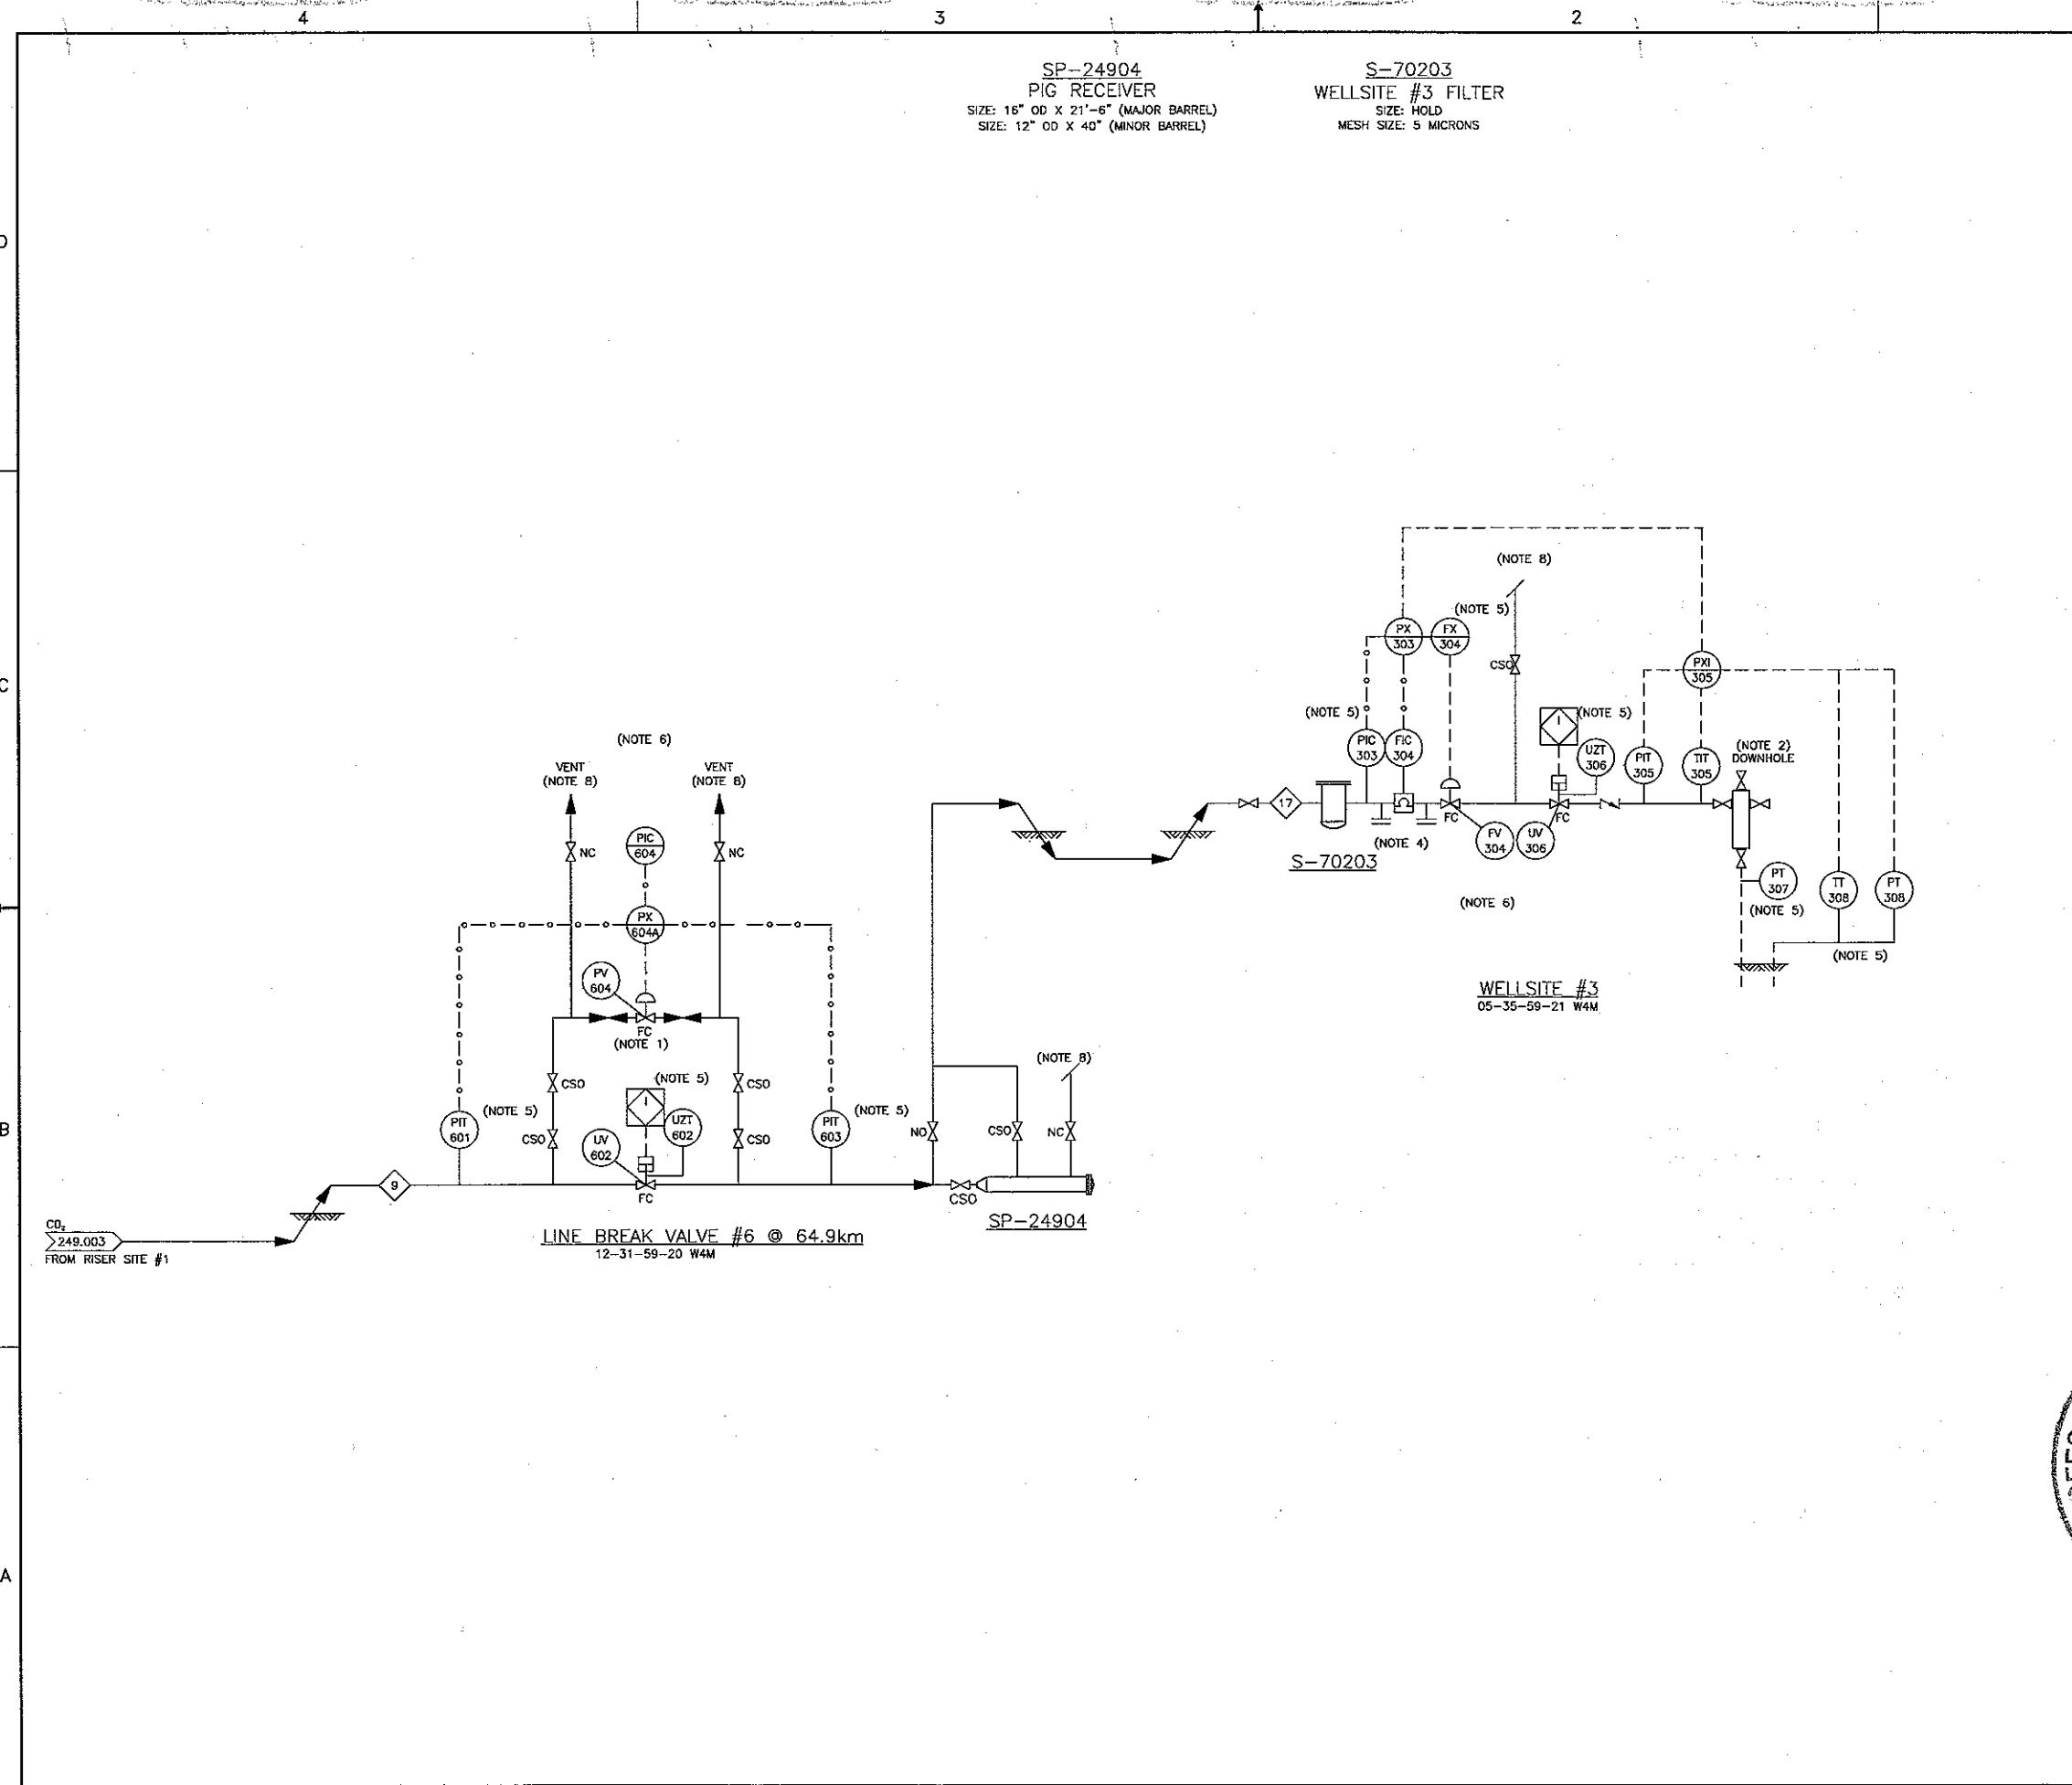

SP-24904  
 PIG RECEIVER  
 SIZE: 18" OD X 21'-6" (MAJOR BARREL)  
 SIZE: 12" OD X 40" (MINOR BARREL)

S-70203  
 WELLSITE #3 FILTER  
 SIZE: HOLD  
 MESH SIZE: 5 MICRONS

- NOTES**
1. PV REGULATES CO<sub>2</sub> FOR P/L FILL AND BLOW-DOWN THROUGH VENT STACKS.
  2. MULTI-SENSOR.
  3. DELETED.
  4. METER PROVER TAPS.
  5. PRIMARY INSTRUMENTATION AS SHOWN IS REMOTELY TIED TO SCOTTFORD VIA SCADA.
  6. ALL WELLSITE INSTRUMENTATION NUMBERS ARE PREFIXED WITH UNIT #702 AND ALL LINE BREAK VALVE INSTRUMENTATION NUMBERS ARE PREFIXED WITH UNIT #249.
  7. DELETED.
  8. ALL VENTS TO SAFE LOCATION.

**KEY PLAN**


- REFERENCE DRAWINGS**
1. HEAT AND MATERIAL BALANCE TABLE (249.0000.000.046.001)

**LEGEND**

◇ STREAM NUMBER

**TOYO ENGINEERING CANADA LTD.**  
 TOYO-CA DWG. No. 09223-0-DG-BB-00004.01 CAD FILE 00401-1265


D	12 NOV 09	ISSUED FOR CONSTRUCTION			
H	12 SEP 20	ISSUED FOR CLIENT REVIEW	DIM/ALM/KVM		
G	12 SEP 17	ISSUED FOR INTERNAL REVIEW	DIM/ALM/KVM		
			DWN (CHD)	ENG	APP

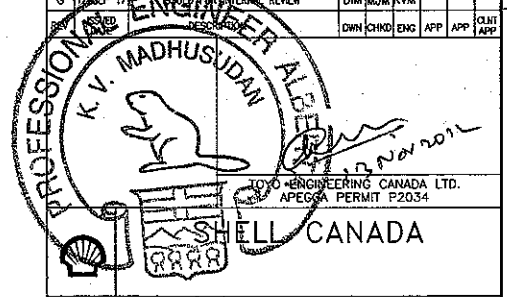

ALBERTA  
 QUEST CCS PROJECT  
 LINE BREAK VALVE #6  
 WELLSITE #3  
 PROCESS FLOW DIAGRAM

SCALE: NTS  
 SHELL DWG NO.: 249.0000.000.040.004 REV: 0



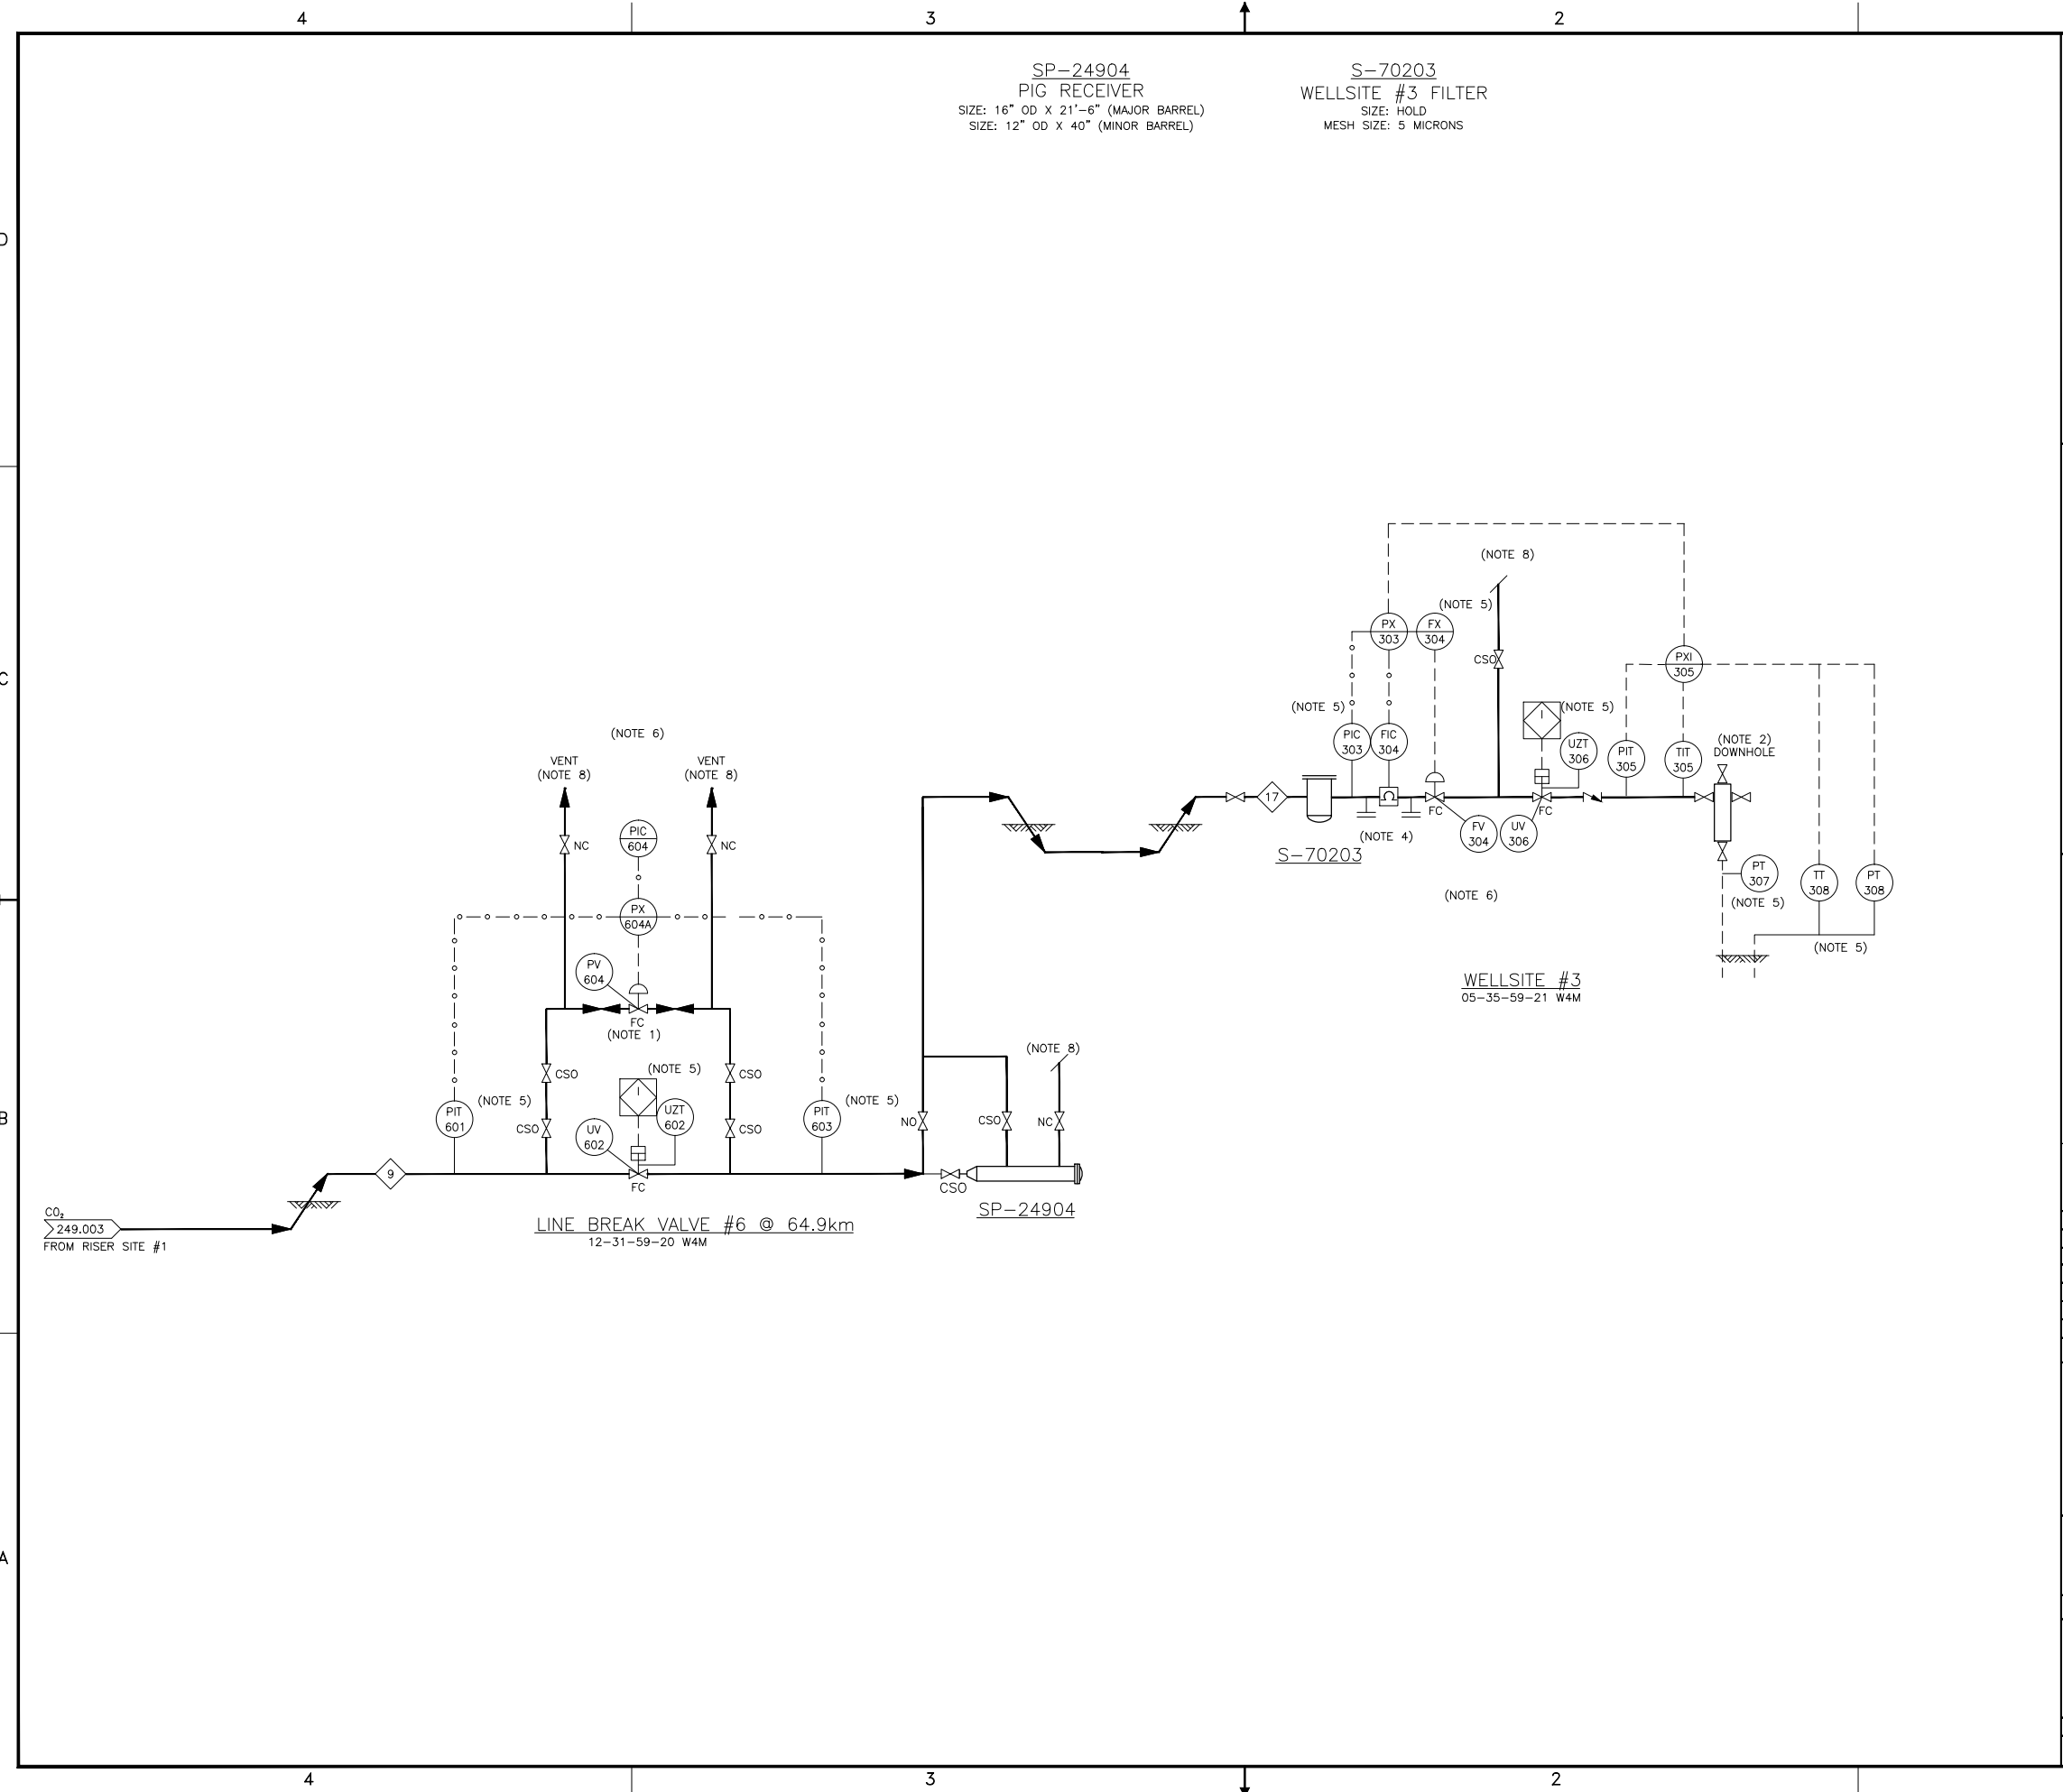

**NOTES**

1. PV REGULATES CO<sub>2</sub> FOR P/L FILL AND BLOW-DOWN THROUGH VENT STACKS.
2. MULTI-SENSOR.
3. DELETED.
4. METER PROVER TAPS.
5. PRIMARY INSTRUMENTATION AS SHOWN IS REMOTELY TIED TO SCOTFORD VIA SCADA.
6. ALL WELLSITE INSTRUMENTATION NUMBERS ARE PREFIXED WITH UNIT #702 AND ALL LINE BREAK VALVE INSTRUMENTATION NUMBERS ARE PREFIXED WITH UNIT #249.
7. DELETED.
8. ALL VENTS TO SAFE LOCATION.

**KEY PLAN**

**REFERENCE DRAWINGS**

1. HEAT AND MATERIAL BALANCE TABLE (249.0000.000.046.001)


**LEGEND**

◇ XX STREAM NUMBER

**TOYO ENGINEERING CANADA LTD.**  
 TOYO-CA DWG. No. **09223-0-DG-BB-00004.01** CAD FILE 00401-1265

REV	ISSUED DATE	DESCRIPTION	DWN	CHKD	ENG	APP	APP	CLNT APP
O	12 NOV 09	ISSUED FOR CONSTRUCTION						
H	12 SEP 20	ISSUED FOR CLIENT REVIEW						
G	12 SEP 17	ISSUED FOR INTERNAL REVIEW						


TOYO ENGINEERING CANADA LTD.  
 APEGGA PERMIT P2034

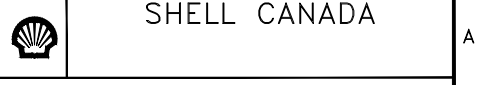

ALBERTA  
**QUEST CCS PROJECT**  
**LINE BREAK VALVE #6**  
**WELLSITE #3**  
**PROCESS FLOW DIAGRAM**

SCALE: NTS  
 SHELL DWG NO.: **249.0000.000.040.004** REV. **0**



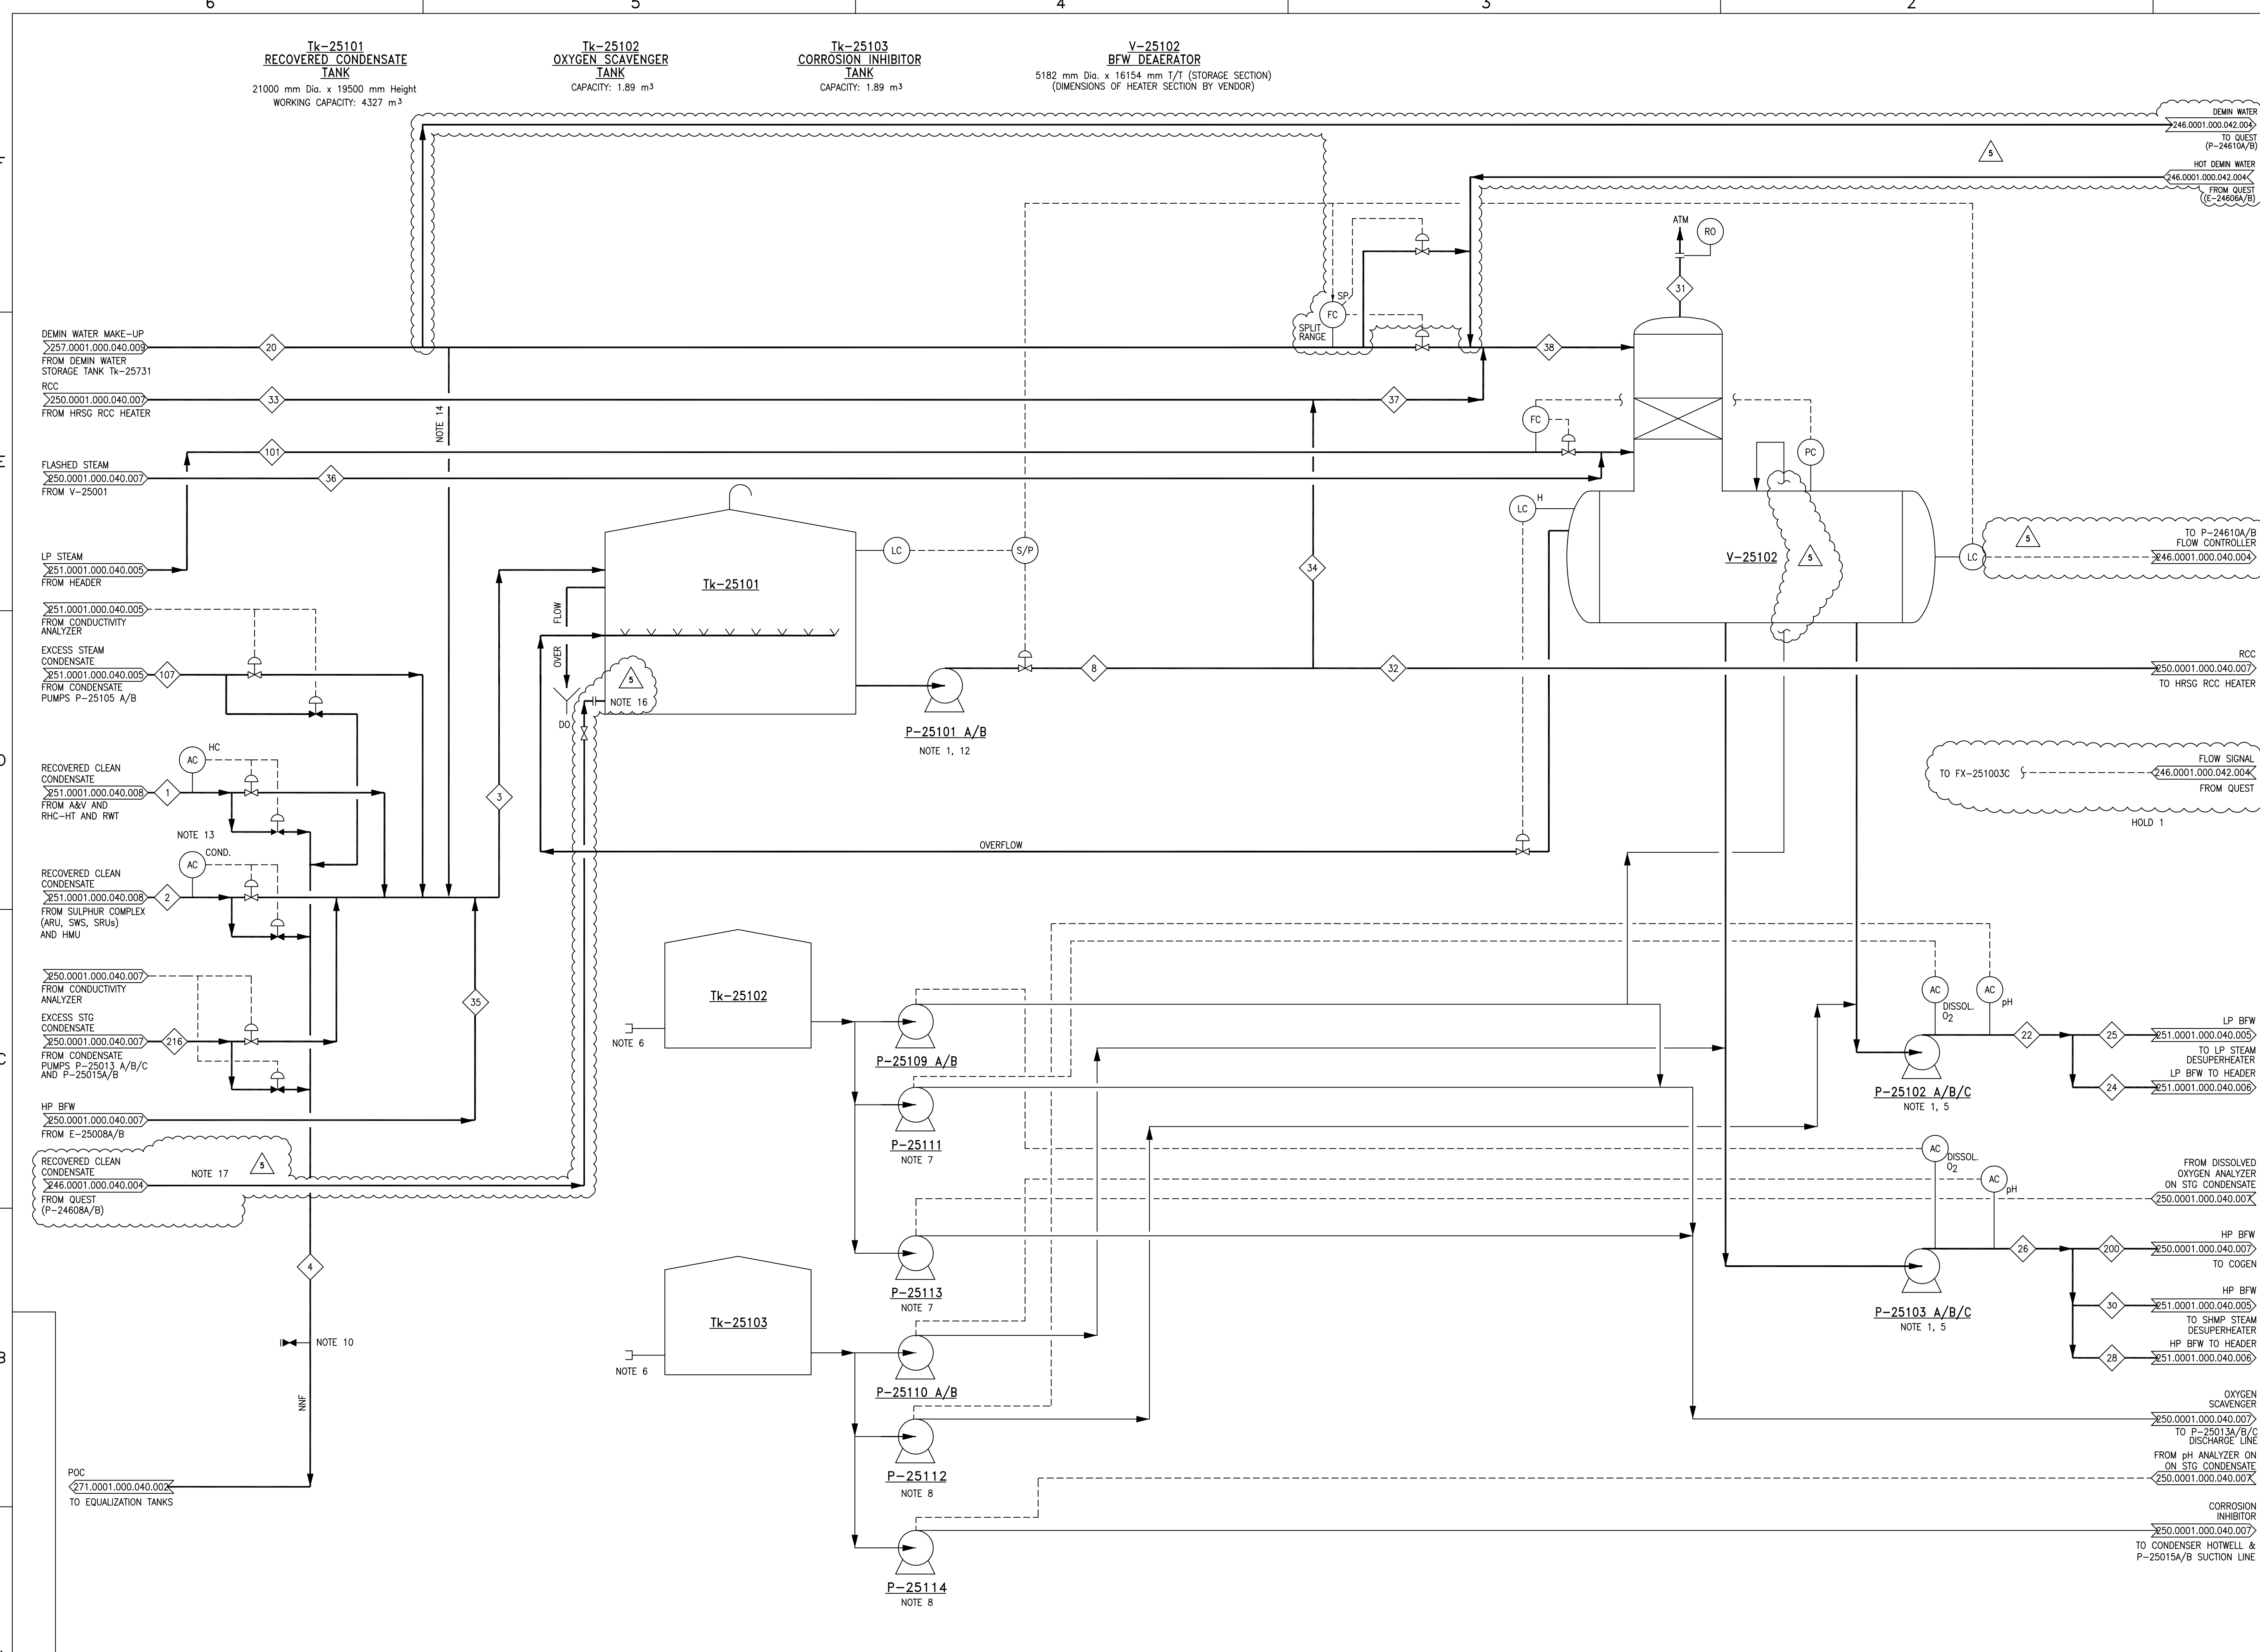

- NOTES**
- PUMPS HAVE LOW PRESSURE AUTO-START PROVISION.
  - FOR CORRESPONDING MATERIAL BALANCE, SEE DS-251-B-0101.
  - DELETED.
  - POC IS ROUTED TO EQUALIZATION TANKS.
  - THE HP BFW PUMPS AND LP BFW PUMPS EACH OPERATE NORMALLY ON ONE MOTOR AND ONE TURBINE WITH ONE MOTOR DRIVEN SPARE.
  - PROVIDE AN AIR-DRIVEN PUMP FOR CHEMICAL LOADING. (ONE PUMP TO BE SHARED BETWEEN CHEMICAL SERVICES).
  - USE P-25109B AS A COMMON SPARE FOR P-25111 AND P-25113.
  - USE P-25110B AS A COMMON SPARE FOR P-25112 AND P-25114.
  - AS STG CONDENSER IS NOT PROVIDED WITH DEAERATING CONDENSER, STG CONDENSATE TO HMU WILL SEE A SWING IN OXYGEN CONTENT. PROVISION TO ROUTE 100,000 kg/h STG CONDENSATE TO RCC TANK IS MADE TO TAKE CARE OF HIGH OXYGEN CONTENT OF STG CONDENSATE AT MODERATE LOAD (I.E. NORMAL SUMMER). DESIGN IS BASED ON THE ASSUMPTION THAT OPERATOR ACTION WILL TAKE CARE OF INCREASED OXYGEN CONTENT IN STG CONDENSATE BY INCREASING OXYGEN SCAVENGER DOSING.
  - PROVIDE A CONNECTION FOR UTILITY WATER TO QUENCH POC IF REQUIRED BY WWTU.
  - DELETED.
  - PUMPS ARE SIZED AT 2 x 50% OF THE PEAK FLOW. POSSIBLE SHORTFALLS IN PUMPING CAPABILITY WILL BE MET BY DEMIN M/U PUMPS THAT SHALL BE RATED AT 3 x 33% OF THE PEAK FLOW OF 1560 m³/h.
  - CONDUCTIVITY IS MEASURED AS A MEANS OF DETECTING AMINE CARRY OVERS.
  - A 4" FILL LINE IS PROVIDED FROM DEMIN WATER HEADER FOR START-UP.
  - THIS DRAWING IS UPDATED BASED ON UNITS 251/250 ISSUED (FD) P&IDs AND UNIT 285 ISSUED (FC) INTERCONNECTING P&IDs.
  - USE 6 INCH DRAIN NOZZLE ON SOUTH SIDE OF TANK FOR RCC TIE-IN TO RCC TANK TK-25101 FROM QUEST.
  - UNIT 246 PROVIDES ANALYSER OF RECOVERED CONDENSATE (PH & COND.) AND CONTROL OF SWITCHING VALVES, LOCATED SOUTHWEST OF RCC TANK TK-25101, THAT CAN DIVERT CONDENSATE TO POC. SWITCHING VALVES SHOWN ON PFD 246.004.

**HOLD**

1. FX-251003C IS A SUMMING BLOCK SHOWN ON P&ID 251.0000.000.041.103. PFD TO BE AS-BUILT WITH FLOW SIGNAL FROM QUEST.

**ISSUED FOR CONSTRUCTION**  
21 Oct 2013

**FLUOR.** FLUOR'S RESPONSIBILITY IS LIMITED TO THE REVISION CONTENT SHOWN IN THIS DOCUMENT.

NO.	DATE	ISSUED FOR	BY	CHKD	APP	APP
5	2013-09-24	RE-ISSUED IFC ON NEXT HARD REV	GB	CC	LMF	KH CV
AC	2013-01-08	ISSUED FOR CONSTRUCTION	GB	KB	SL	KH CV
4B	2011-08-24	RE-ISSUED FOR QUEST DESIGN	GB	SM	MB	JL CV M/28
4A	2011-03-01	RE-ISSUED FOR QUEST DESIGN	GB	SM	MB	JL CV M/28
4	2010-11-04	ISSUED FOR QUEST DESIGN	JH	SM	MB	JL CV M/28
3A	2010-08-10	ISSUED FOR QUEST CONSOLE HAZOP				
3	2010-11-29	ISSUED FOR AS-BUILT	AC	BY		SB
2	2010-06-11	ISSUED FOR CONSTRUCTION	DO	JM	MMR	JM BLK
1	2007-01-11	RE-ISSUED FOR DESIGN	ADR	SL	ADR	JM BLK HB
0	2000-05-17	ISSUED FOR DESIGN	ADR	SL	AKG	BLK
D	1999-12-23	RE-ISSUED FOR APPROVAL	ADR	SL	AKG	BLK
C	1999-10-25	RE-ISSUED FOR APPROVAL	ADR	SL	AKG	BLK
B	1999-06-07	ISSUED FOR APPROVAL	HEM	AKG	AKG	BLK
A	1999-03-29	ISSUED FOR REVIEW	HEM	AKG	AKG	BLK

THE SIGNED APEGA STAMP RESIDES ON THE ORIGINAL IFC DOCUMENT HELD IN DOCUMENT CONTROL. NO DESIGN CHANGES WILL BE MADE TO THIS DRAWING WITHOUT THE APPROVAL OF A REGISTERED ENGINEER.

**BANTREL inc.**  
PERMIT NUMBER: P 3913  
The Association of Professional Engineers, Geologists and Geophysicists of Alberta

**SHELL CANADA LTD.**  
ATHABASCA OIL SANDS  
DOWNSTREAM PROJECT


**BANTREL inc.** CALGARY, ALBERTA Job No. 757

**PROCESS FLOW DIAGRAM**  
RECOVERED CONDENSATE TREATMENT/  
BFW TREATMENT SYSTEM

SCALE	DATE	REV.
NONE		5

- P-25101 A/B RECOVERED CONDENSATE PUMPS**  
DESIGN FLOW RATE: 780 m³/h  
DIFF. PRESSURE: 586 kPa  
NOTE 12
- P-25109 A/B OXYGEN SCAVENGER INJECTION PUMP # 1**  
DESIGN FLOW RATE: 0.003 m³/h  
DIFF. PRESSURE: 239 kPa
- P-25111 OXYGEN SCAVENGER INJECTION PUMP # 2**  
DESIGN FLOW RATE: 0.0008 m³/h  
DIFF. PRESSURE: 237 kPa
- P-25113 OXYGEN SCAVENGER INJECTION PUMP # 3**  
DESIGN FLOW RATE: 0.0009 m³/h  
DIFF. PRESSURE: 1 kPa
- P-25110 A/B CORROSION INHIBITOR INJECTION PUMP # 1**  
DESIGN FLOW RATE: 0.01 m³/h  
DIFF. PRESSURE: 239 kPa
- P-25112 CORROSION INHIBITOR INJECTION PUMP # 2**  
DESIGN FLOW RATE: 0.0005 m³/h  
DIFF. PRESSURE: 328 kPa
- P-25114 CORROSION INHIBITOR INJECTION PUMP # 3**  
DESIGN FLOW RATE: 0.0026 m³/h  
DIFF. PRESSURE: 1 kPa
- P-25102 A/B/C LP BFW PUMPS**  
DESIGN FLOW RATE: 161 m³/h  
DIFF. PRESSURE: 914 kPa
- P-25103 A/B/C HP BFW PUMPS**  
DESIGN FLOW RATE: 644 m³/h  
DIFF. PRESSURE: 7492 kPa



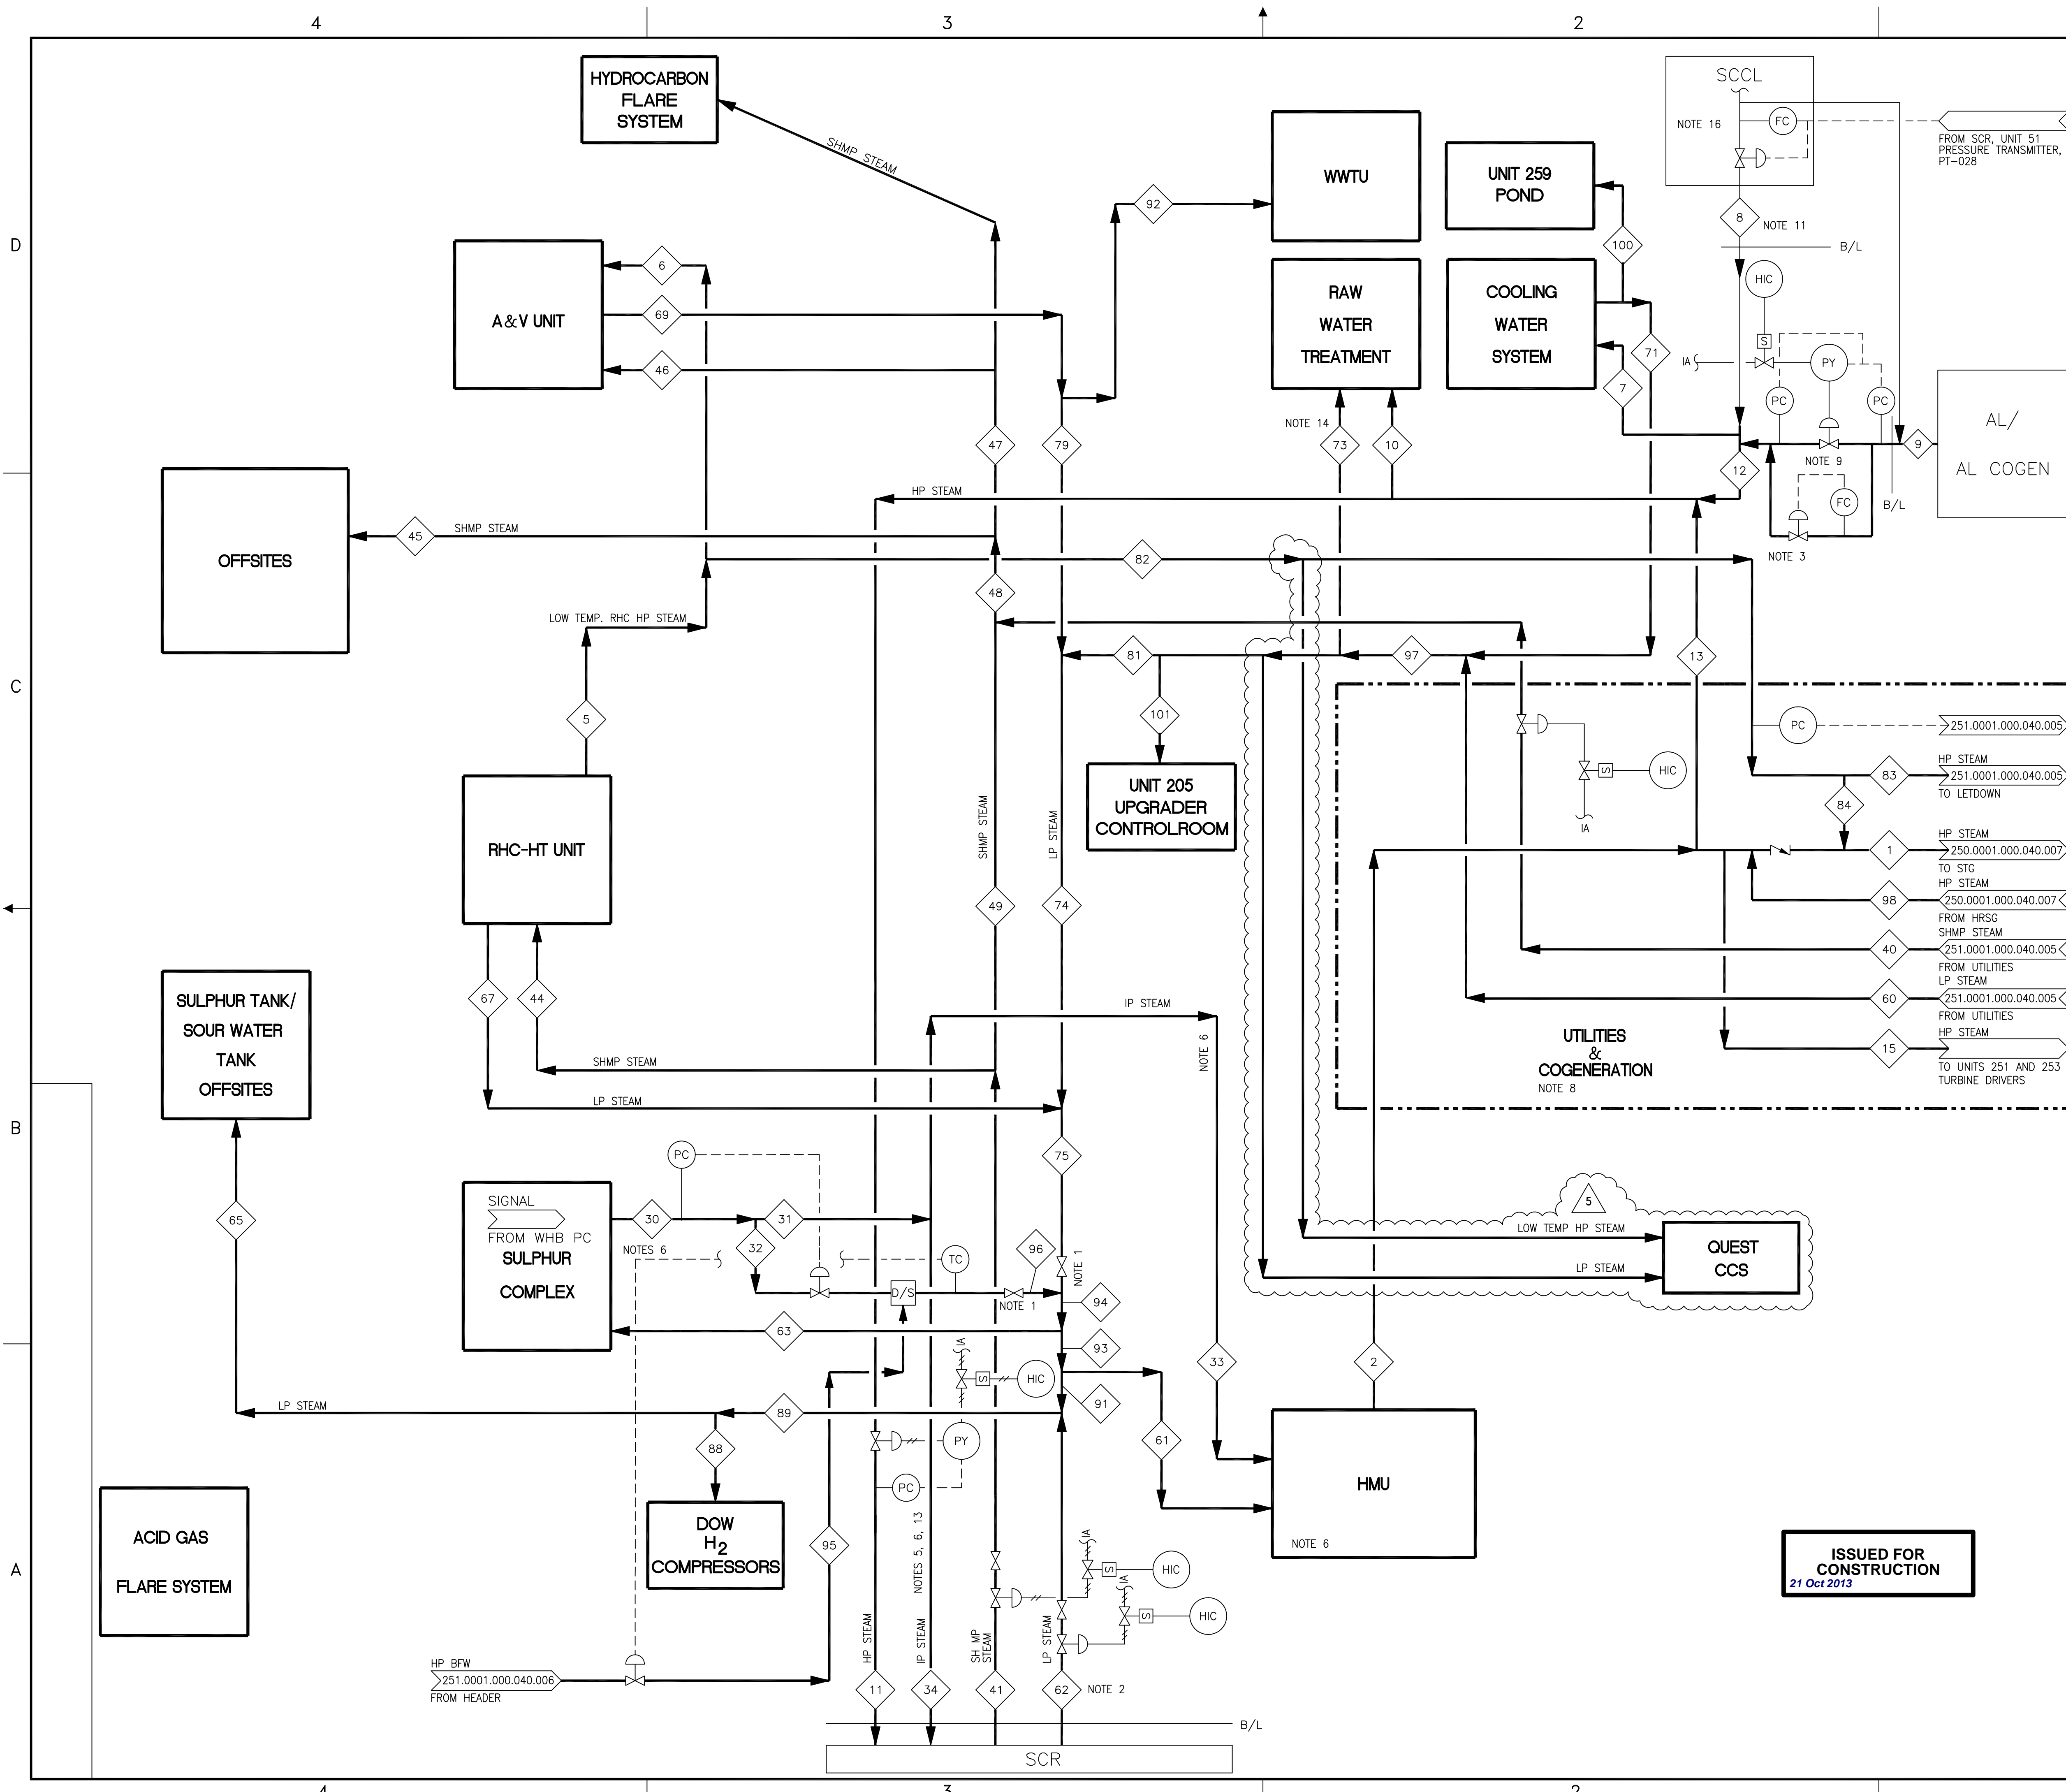

- NOTES**
- VALVES ARE CLOSED FOR EARLY SCOTFORD MODS.
  - DURING EARLY SCOTFORD MODS THE PRESSURE IN THE LP HDR IS CONTROLLED BY PCV-85006 LOCATED OUTSIDE THE HCU BATTERY LIMIT.
  - A MINIMUM FLOW IS MAINTAINED TO KEEP THE LINE WARM.
  - SCR DESUPERHEATING WATER (FLASHED RCC FROM THE CLEAN CONDENSATE FLASH DRUM V-2120) IS SUPPLIED TO DESUPERHEATER FOR EARLY SCOTFORD MODS AND FOR WHEN THE UPGRADER IS DOWN. THIS DESUPERHEATING FACILITY IS NOW LOCATED IN THE HCU AND ON THE 85 PIPERACK.
  - DURING EARLY SCOTFORD MODS, ALL IP STEAM FROM THE SULPHUR COMPLEX SRUs IS EXPORTED TO THE REFINERY 2500 kPa(g) STEAM SYSTEM WHICH FEEDS THE SMR. DURING UPGRADER OPERATION, THE BALANCE OF THE IP STEAM NOT USED IN THE HMU AS FEED STEAM IS EXPORTED TO THE REFINERY SMR.
  - IN THE EVENT THE PRESSURE IN THE IP STEAM HEADER DROPS BELOW 4200 kPa(g) DURING UPGRADER OPERATION, THE SHORTFALL IN IP STEAM TO THE HMUs WILL BE MADE UP THROUGH LETDOWN FROM THE HP STEAM SYSTEM LOCATED INSIDE HMU B/L. ANY EXCESS IN THE IP STEAM SYSTEM WILL BE REMOVED VIA EITHER IP/UPGRADER-TO IP/REFINERY OR THE IP-TO-LP LETDOWN ADJACENT TO THE SULPHUR COMPLEX.
  - FOR CORRESPONDING MATERIAL BALANCE REFER TO DS-251-B-0107.
  - THE HP-TO-SHMP AND SHMP-TO-LP LETDOWN FACILITIES ARE LOCATED IN THE UTILITIES (PLANT 251) AREA.
  - BOTTLING VALVES ARE PROVIDED TO ENABLE ISOLATION OF THE UPGRADER FROM SCR/SCCL/AL AND PROCESS UNIT WITH HIGH LOADS.
  - DELETED.
  - LINE ISOLATED DURING NORMAL OPERATION.
  - MOST LINES ARE BIDIRECTIONAL; PREDOMINANT FLOW DIRECTIONS ARE INDICATED ON THIS DRAWING.
  - THE IP/UPGRADER - IP/REFINERY LETDOWN CONTROL VALVE, PV-85009 IS LOCATED ON 85 PIPERACK NEAR SMR BATTERY LIMIT.
  - LP STEAM FROM DEAERATOR MAKE-UP WATER PUMP TURBINE EXHAUST JOINS INSIDE RAW WATER TREATMENT PLANT.
  - THIS DRAWING IS UPDATED BASED ON UNITS 251/250 ISSUED (IFD) P&IDs AND UNIT 285 ISSUED (IFC) INTERCONNECTING P&IDs.
  - CURRENTLY THE FLOW OF STEAM FROM SCCL TO SCR IS CONTROLLED BY FLOW AND IS RESET BY PRESSURE FLUCTUATIONS AT SCR, UNIT 51. DURING UPGRADER OPERATION, UPGRADER PRIMARY CONTROL/ADVANT CONTROL WILL RECEIVE A REMOTE SIGNAL FROM SCR, UNIT 51 AND RESPONDS ACCORDINGLY.

**LEGEND:**

— NEW FACILITY

— EXISTING FACILITY

**FLUOR.** FLUOR'S RESPONSIBILITY IS LIMITED TO THE REVISION CONTENT SHOWN IN THIS DOCUMENT.

REV	ISSUED DATE	DESCRIPTION	DWN	CHKD	ENG	APP	APP	CLNT APP
5	2013-09-30	RE-ISSUED IFC ON NEXT HARD REV	GB	CC	LMF	KH	CV	
4B	2013-01-10	ISSUED FOR CONSTRUCTION	GB	KB	KH	CV		
4A	2011-03-01	RE-ISSUED FOR QUEST DESIGN	GB	SM	MB	JJ	CV	WJ/SB
4	2010-11-03	ISSUED FOR QUEST DESIGN	JH	SM	MB	JJ	CV	WJ/SB
3A	2010-08-10	ISSUED FOR QUEST COARSE HAZOP						
3	2001-11-29	ISSUED FOR AS-BUILT	HC	BY	-	SB	-	
2	2001-06-11	ISSUED FOR CONSTRUCTION	DC	JM	MRAB	JM	BJK	
1	2001-02-05	RE-ISSUED FOR DESIGN	DC	SL	ADR	JM	BJK	JS
0	2000-04-19	ISSUED FOR DESIGN	ADR	SL		AKG	BJK	
D	2000-02-03	RE-ISSUED FOR APPROVAL	ADR	SL		AKG	BJK	
C	2000-01-05	RE-ISSUED FOR APPROVAL	ADR	SL		AKG	BJK	
B	1999-05-31	ISSUED FOR APPROVAL	HEM	AKG	AKG	BJK		
A	1999-03-29	ISSUED FOR REVIEW	HEM	AKG	AKG	BJK		

"THE SIGNED APEGGA STAMP RESIDES ON THE ORIGINAL IFC DOCUMENT HELD IN DOCUMENT CONTROL. NO DESIGN CHANGES WILL BE MADE TO THIS DRAWING WITHOUT THE APPROVAL OF A REGISTERED ENGINEER."

**BANTREL Inc.**  
 PERMIT NUMBER: P 3913  
 The Association of Professional Engineers,  
 Geologists and Geophysicists of Alberta

**SHELL CANADA LTD.**  
 ATHABASCA OIL SANDS  
 DOWNSTREAM PROJECT


BANTREL Inc. CALGARY, ALBERTA Job No. 757

UTILITY FLOW DIAGRAM  
 UPGRADER OPERATION  
 HP, IP, SHMP AND LP  
 STEAM DISTRIBUTION

SCALE: NONE  
 SHELL DWG NO.: 251.0001.000.040.007 REV. 5

**ISSUED FOR CONSTRUCTION**  
 21 Oct 2013

CAD FILE: 251.0001.000.040.007.REV.DWG - BANTREL 757

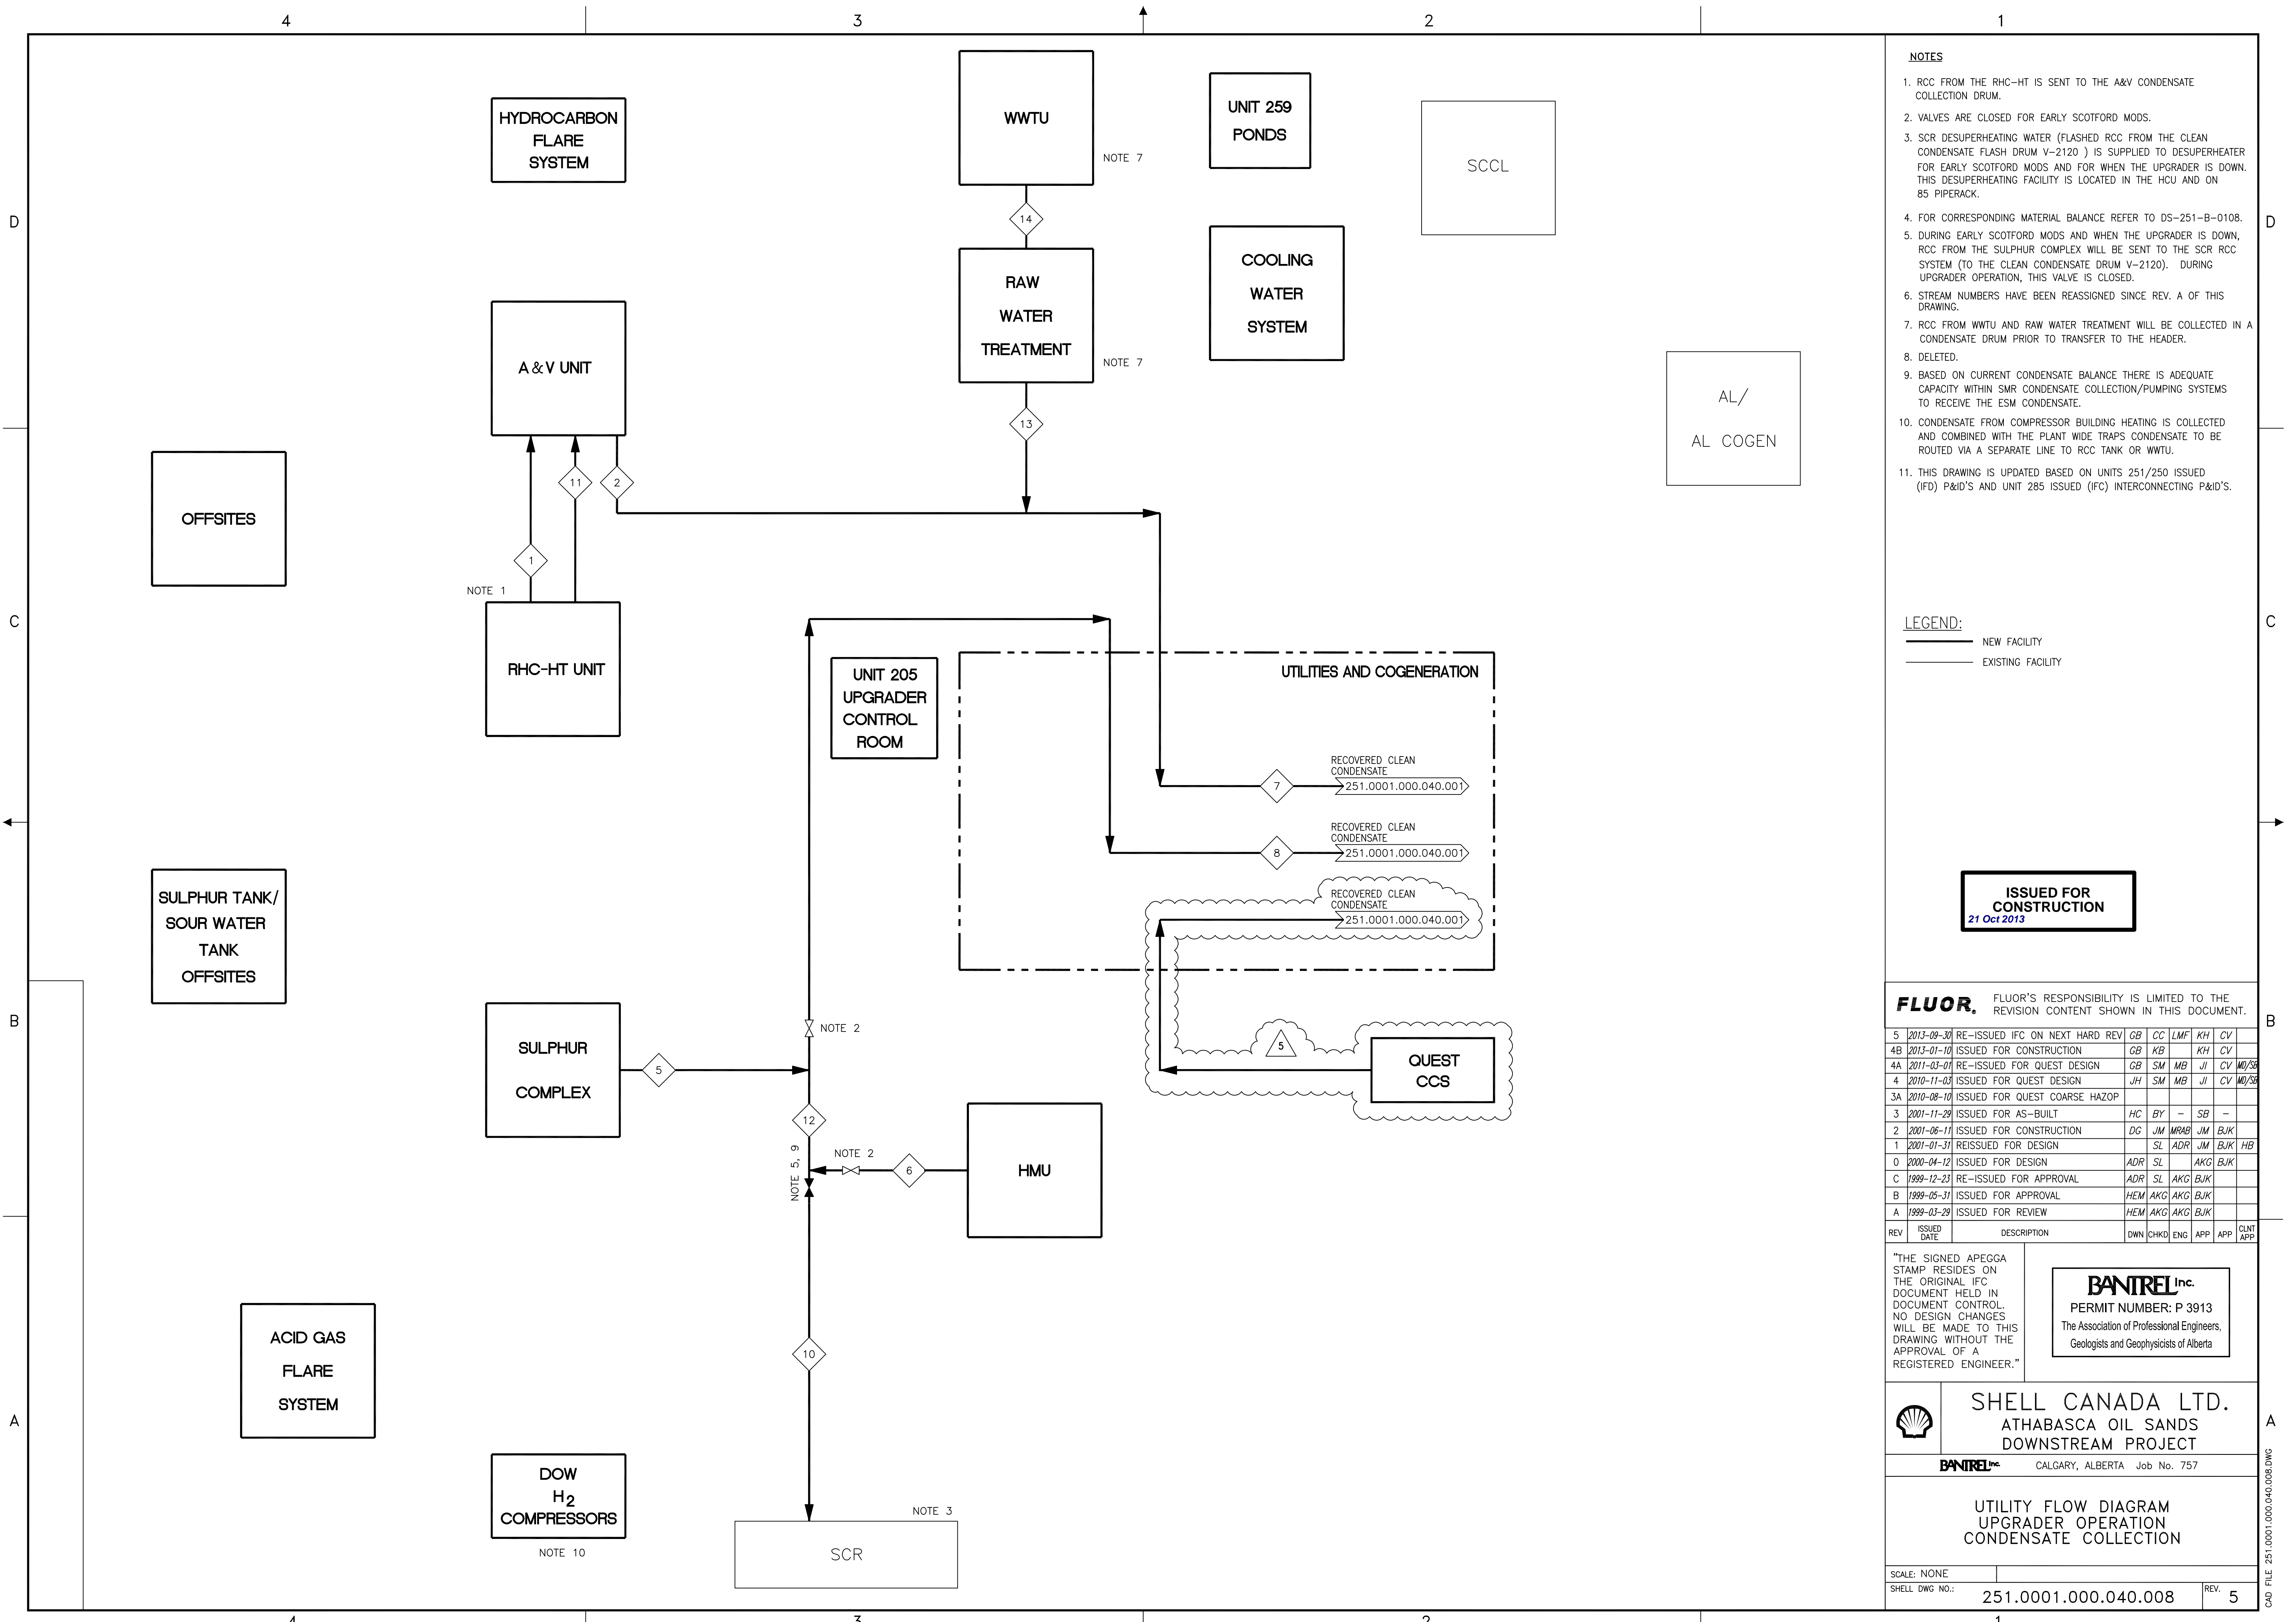

- NOTES**
- RCC FROM THE RHC-HT IS SENT TO THE A&V CONDENSATE COLLECTION DRUM.
  - VALVES ARE CLOSED FOR EARLY SCOTFORD MODS.
  - SCR DESUPERHEATING WATER (FLASHED RCC FROM THE CLEAN CONDENSATE FLASH DRUM V-2120 ) IS SUPPLIED TO DESUPERHEATER FOR EARLY SCOTFORD MODS AND FOR WHEN THE UPGRADER IS DOWN. THIS DESUPERHEATING FACILITY IS LOCATED IN THE HCU AND ON 85 PIPERACK.
  - FOR CORRESPONDING MATERIAL BALANCE REFER TO DS-251-B-0108.
  - DURING EARLY SCOTFORD MODS AND WHEN THE UPGRADER IS DOWN, RCC FROM THE SULPHUR COMPLEX WILL BE SENT TO THE SCR RCC SYSTEM (TO THE CLEAN CONDENSATE DRUM V-2120). DURING UPGRADER OPERATION, THIS VALVE IS CLOSED.
  - STREAM NUMBERS HAVE BEEN REASSIGNED SINCE REV. A OF THIS DRAWING.
  - RCC FROM WWTU AND RAW WATER TREATMENT WILL BE COLLECTED IN A CONDENSATE DRUM PRIOR TO TRANSFER TO THE HEADER.
  - DELETED.
  - BASED ON CURRENT CONDENSATE BALANCE THERE IS ADEQUATE CAPACITY WITHIN SMR CONDENSATE COLLECTION/PUMPING SYSTEMS TO RECEIVE THE ESM CONDENSATE.
  - CONDENSATE FROM COMPRESSOR BUILDING HEATING IS COLLECTED AND COMBINED WITH THE PLANT WIDE TRAPS CONDENSATE TO BE ROUTED VIA A SEPARATE LINE TO RCC TANK OR WWTU.
  - THIS DRAWING IS UPDATED BASED ON UNITS 251/250 ISSUED (IFD) P&ID'S AND UNIT 285 ISSUED (IFC) INTERCONNECTING P&ID'S.

**LEGEND:**  
 — NEW FACILITY  
 — EXISTING FACILITY

**ISSUED FOR CONSTRUCTION**  
 21 Oct 2013

**FLUOR.** FLUOR'S RESPONSIBILITY IS LIMITED TO THE REVISION CONTENT SHOWN IN THIS DOCUMENT.

REV	ISSUED DATE	DESCRIPTION	DWN	CHKD	ENG	APP	CLNT APP
5	2013-09-30	RE-ISSUED IFC ON NEXT HARD REV	GB	CC	LMF	KH	CV
4B	2013-01-10	ISSUED FOR CONSTRUCTION	GB	KB		KH	CV
4A	2011-03-01	RE-ISSUED FOR QUEST DESIGN	GB	SM	MB	JJ	CV
4	2010-11-03	ISSUED FOR QUEST DESIGN	JH	SM	MB	JJ	CV
3A	2010-08-10	ISSUED FOR QUEST COARSE HAZOP					
3	2001-11-29	ISSUED FOR AS-BUILT	HC	BY		SB	
2	2001-06-11	ISSUED FOR CONSTRUCTION	DC	JM	MRAB	JM	BJK
1	2001-01-31	REISSUED FOR DESIGN		SL	ADR	JM	BJK
0	2000-04-12	ISSUED FOR DESIGN	ADR	SL		AKG	BJK
C	1999-12-23	RE-ISSUED FOR APPROVAL	ADR	SL	AKG	BJK	
B	1999-05-31	ISSUED FOR APPROVAL	HEM	AKG	AKG	BJK	
A	1999-03-29	ISSUED FOR REVIEW	HEM	AKG	AKG	BJK	

"THE SIGNED APEGGA STAMP RESIDES ON THE ORIGINAL IFC DOCUMENT HELD IN DOCUMENT CONTROL. NO DESIGN CHANGES WILL BE MADE TO THIS DRAWING WITHOUT THE APPROVAL OF A REGISTERED ENGINEER."

**BANIREL inc.**  
 PERMIT NUMBER: P 3913  
 The Association of Professional Engineers,  
 Geologists and Geophysicists of Alberta



**SHELL CANADA LTD.**  
 ATHABASCA OIL SANDS  
 DOWNSTREAM PROJECT

BANIREL inc. CALGARY, ALBERTA Job No. 757


UTILITY FLOW DIAGRAM  
 UPGRADER OPERATION  
 CONDENSATE COLLECTION

SCALE: NONE  
 SHELL DWG NO.: 251.0001.000.040.008 REV. 5

CAD FILE: 251.0001.000.040.008.DWG





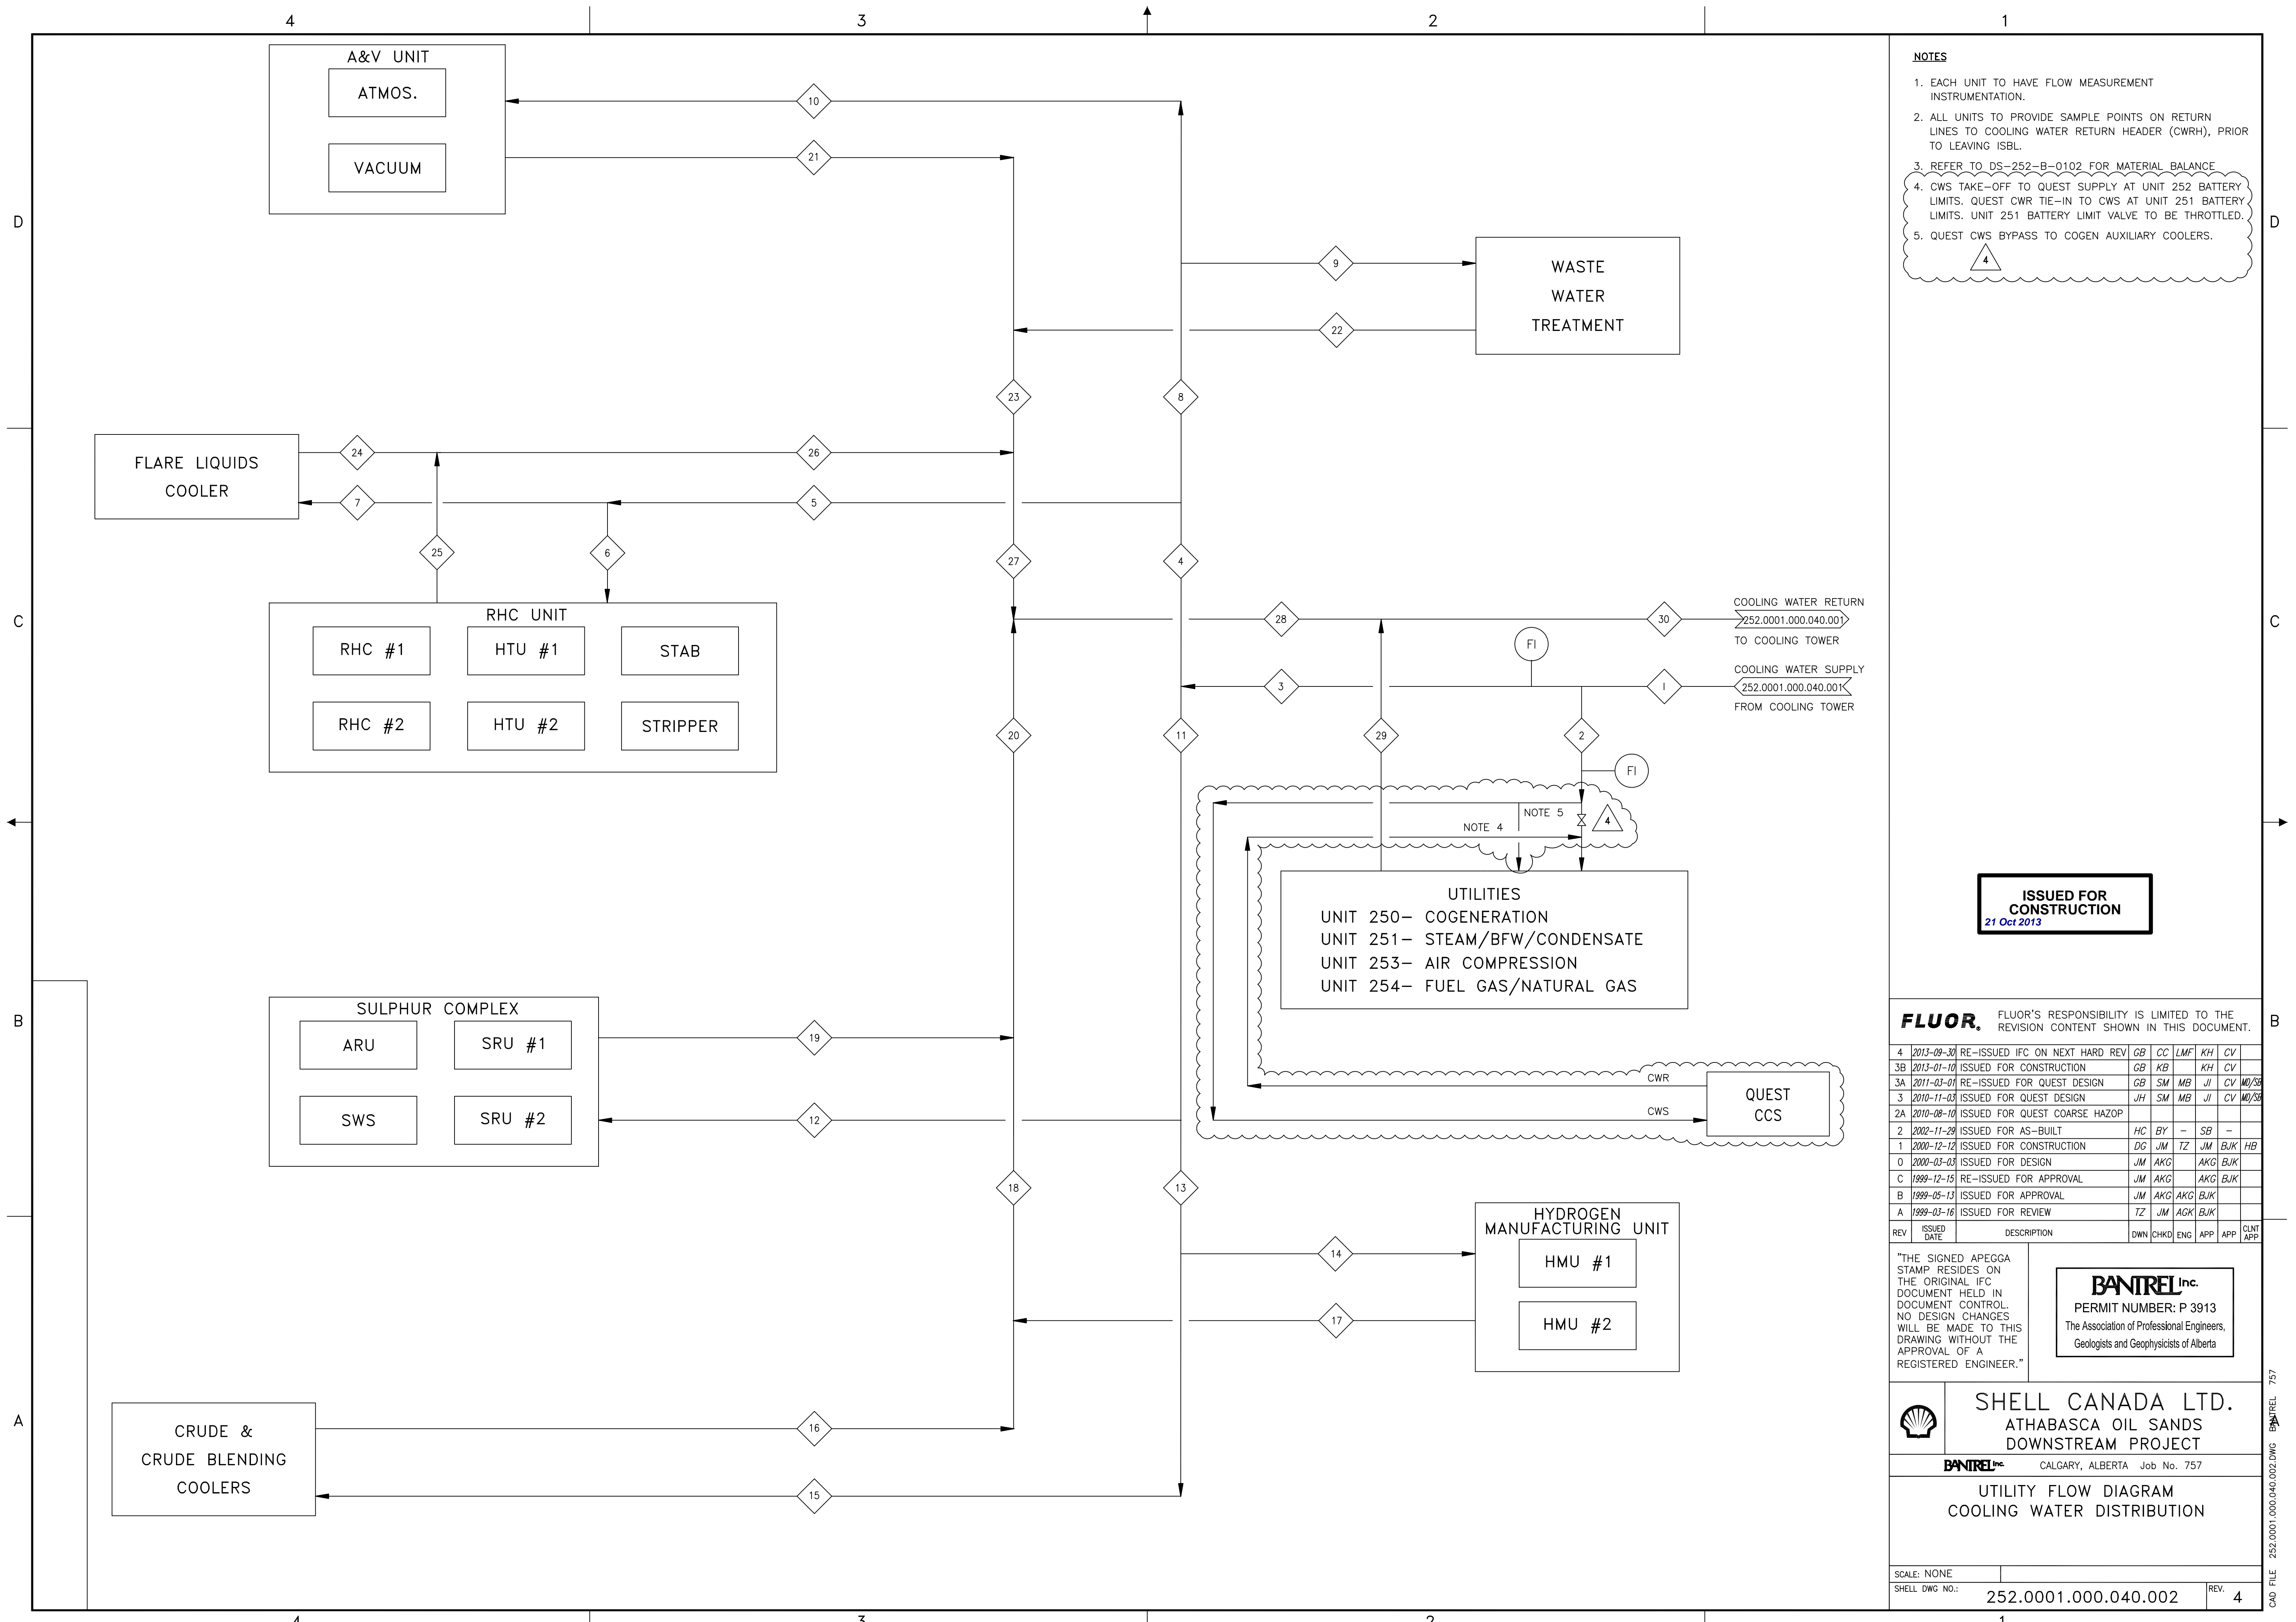

- NOTES**
1. EACH UNIT TO HAVE FLOW MEASUREMENT INSTRUMENTATION.
  2. ALL UNITS TO PROVIDE SAMPLE POINTS ON RETURN LINES TO COOLING WATER RETURN HEADER (CWRH), PRIOR TO LEAVING ISBL.
  3. REFER TO DS-252-B-0102 FOR MATERIAL BALANCE.
  4. CWS TAKE-OFF TO QUEST SUPPLY AT UNIT 252 BATTERY LIMITS. QUEST CWR TIE-IN TO CWS AT UNIT 251 BATTERY LIMITS. UNIT 251 BATTERY LIMIT VALVE TO BE THROTTLED.
  5. QUEST CWS BYPASS TO COGEN AUXILIARY COOLERS.

**ISSUED FOR CONSTRUCTION**  
21 Oct 2013

**FLUOR.** FLUOR'S RESPONSIBILITY IS LIMITED TO THE REVISION CONTENT SHOWN IN THIS DOCUMENT.

4	2013-09-30	RE-ISSUED IFC ON NEXT HARD REV	GB	CC	LMF	KH	CV
3B	2013-01-10	ISSUED FOR CONSTRUCTION	GB	KB		KH	CV
3A	2011-03-01	RE-ISSUED FOR QUEST DESIGN	GB	SM	MB	JL	CV
3	2010-11-03	ISSUED FOR QUEST DESIGN	JH	SM	MB	JL	CV
2A	2010-08-10	ISSUED FOR QUEST COARSE HAZOP					
2	2002-11-29	ISSUED FOR AS-BUILT	HC	BY		SB	
1	2000-12-12	ISSUED FOR CONSTRUCTION	DG	JM	TZ	JM	BJK
0	2000-03-03	ISSUED FOR DESIGN	JM	AKG		AKG	BJK
C	1999-12-15	RE-ISSUED FOR APPROVAL	JM	AKG		AKG	BJK
B	1999-05-13	ISSUED FOR APPROVAL	JM	AKG		AKG	BJK
A	1999-03-16	ISSUED FOR REVIEW	TZ	JM	ACK	BJK	
REV	ISSUED DATE	DESCRIPTION	DWN	CHKD	ENG	APP	CLNT APP

"THE SIGNED APEGGA STAMP RESIDES ON THE ORIGINAL IFC DOCUMENT HELD IN DOCUMENT CONTROL. NO DESIGN CHANGES WILL BE MADE TO THIS DRAWING WITHOUT THE APPROVAL OF A REGISTERED ENGINEER."

**BANTREL Inc.**  
PERMIT NUMBER: P 3913  
The Association of Professional Engineers,  
Geologists and Geophysicists of Alberta


**SHELL CANADA LTD.**  
ATHABASCA OIL SANDS  
DOWNSTREAM PROJECT

**BANTREL Inc.** CALGARY, ALBERTA Job No. 757

**UTILITY FLOW DIAGRAM**  
**COOLING WATER DISTRIBUTION**

SCALE: NONE  
SHELL DWG NO.: 252.0001.000.040.002  
REV. 4

CAD FILE 252.0001.000.040.002.DWG BANTREL 757

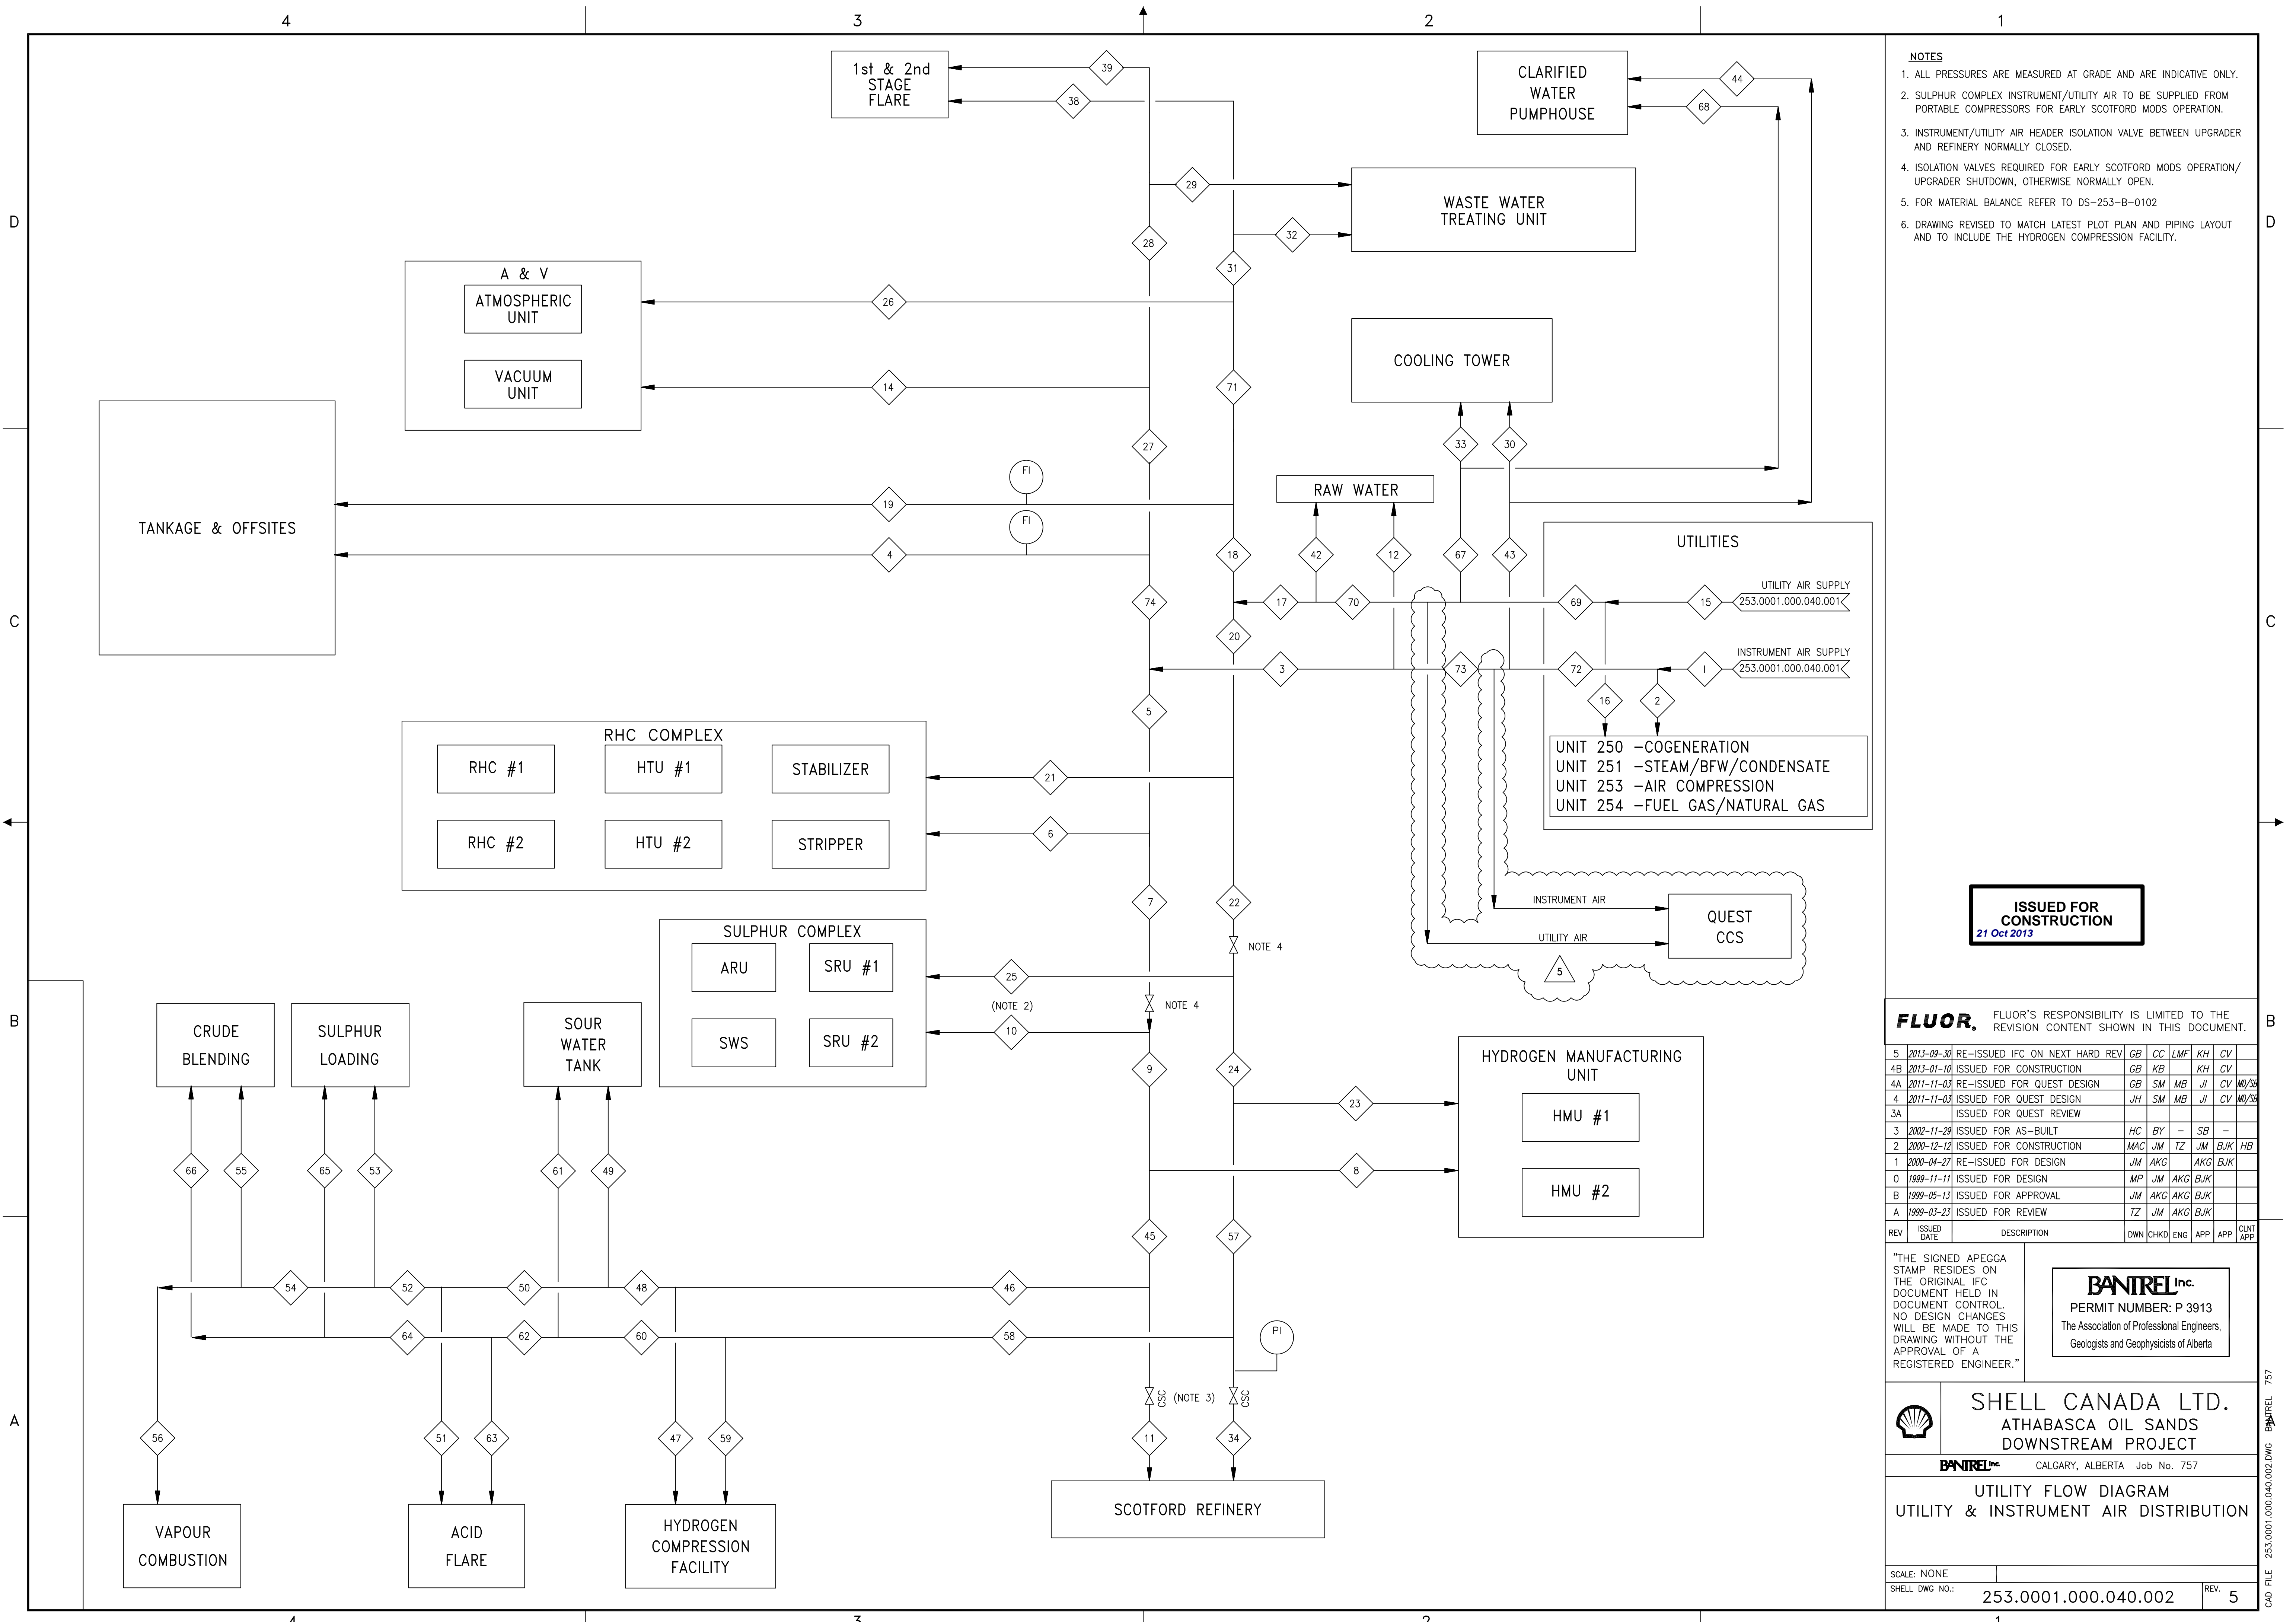

- NOTES**
1. ALL PRESSURES ARE MEASURED AT GRADE AND ARE INDICATIVE ONLY.
  2. SULPHUR COMPLEX INSTRUMENT/UTILITY AIR TO BE SUPPLIED FROM PORTABLE COMPRESSORS FOR EARLY SCOTFORD MODS OPERATION.
  3. INSTRUMENT/UTILITY AIR HEADER ISOLATION VALVE BETWEEN UPGRADER AND REFINERY NORMALLY CLOSED.
  4. ISOLATION VALVES REQUIRED FOR EARLY SCOTFORD MODS OPERATION/UPGRADER SHUTDOWN, OTHERWISE NORMALLY OPEN.
  5. FOR MATERIAL BALANCE REFER TO DS-253-B-0102
  6. DRAWING REVISED TO MATCH LATEST PLOT PLAN AND PIPING LAYOUT AND TO INCLUDE THE HYDROGEN COMPRESSION FACILITY.

**ISSUED FOR CONSTRUCTION**  
21 Oct 2013

**FLUOR.** FLUOR'S RESPONSIBILITY IS LIMITED TO THE REVISION CONTENT SHOWN IN THIS DOCUMENT.

REV	ISSUED DATE	DESCRIPTION	DWN	CHKD	ENG	APP	APP	CLNT APP
5	2013-09-30	RE-ISSUED IFC ON NEXT HARD REV	GB	CC	LMF	KH	CV	
4B	2013-01-10	ISSUED FOR CONSTRUCTION	GB	KB		KH	CV	
4A	2011-11-03	RE-ISSUED FOR QUEST DESIGN	GB	SM	MB	JJ	CV	MJ/SB
4	2011-11-03	ISSUED FOR QUEST DESIGN	JH	SM	MB	JJ	CV	MJ/SB
3A		ISSUED FOR QUEST REVIEW						
3	2002-11-29	ISSUED FOR AS-BUILT	HC	BY		SB		
2	2000-12-12	ISSUED FOR CONSTRUCTION	MAC	JM	TZ	JM	BJK	HB
1	2000-04-27	RE-ISSUED FOR DESIGN	JM	AKG		AKG	BJK	
0	1999-11-11	ISSUED FOR DESIGN	MP	JM	AKG	BJK		
B	1999-05-13	ISSUED FOR APPROVAL	JM	AKG	AKG	BJK		
A	1999-03-23	ISSUED FOR REVIEW	TZ	JM	AKG	BJK		

"THE SIGNED APEGGA STAMP RESIDES ON THE ORIGINAL IFC DOCUMENT HELD IN DOCUMENT CONTROL. NO DESIGN CHANGES WILL BE MADE TO THIS DRAWING WITHOUT THE APPROVAL OF A REGISTERED ENGINEER."

**BANTREL Inc.**  
PERMIT NUMBER: P 3913  
The Association of Professional Engineers,  
Geologists and Geophysicists of Alberta

**SHELL CANADA LTD.**  
ATHABASCA OIL SANDS  
DOWNSTREAM PROJECT

**BANTREL Inc.** CALGARY, ALBERTA Job No. 757

UTILITY FLOW DIAGRAM  
UTILITY & INSTRUMENT AIR DISTRIBUTION

SCALE: NONE  
SHELL DWG NO.: 253.0001.000.040.002 REV. 5

CAD FILE 253.0001.000.040.002.DWG BANTREL 757

4

3

2

1

**E-44005**  
NITROGEN RECYCLE COMPRESSOR COOLER  
Duty (MW) = 0.224 (UNIT S/U)

**V-44004**  
NITROGEN RECYCLE COMPRESSOR KNOCKOUT DRUM  
914 mm ID x 2300 mm T/T (UNIT S/U)

**C-44002**  
N2 RECYCLE COMPRESSOR  
Cap. 15198 m<sup>3</sup>(st)/hr  
Pss 800 kPa (ga)  
Pds 1200 kPa (ga)  
Driver 335 kW (UNIT S/U)

**E-44001**  
NATURAL GAS PREHEATER  
Duty (MW) = 2.31/1.88  
HOLD

**S-44006**  
E-44001 CONDENSATE LIFTER  
Cap. 6.5 m<sup>3</sup>/h

- NOTES:**
- COMPLETE ANALYSIS TO DETERMINE EQUIVALENT C1 BY COMMON ANALYZER.
  - FLOWS AND DUTIES: CHECK CASE V REV 2 / CASE #21.  
CHECK CASE V REV 2: CHEMICAL FEED + NG @105°C, HC PSA TAILGAS MAKE-UP FUEL, STEAM EXPORT OF ~160+/h.  
CASE #21: FLUE GAS RECYCLE ONLINE AT 100%.
  - CONDENSATE DRUM & PUMPS ARE SHOWN ON UFD, DWG. # 440.0001.000.040.011
  - HYDROGENATION GAS STREAM IS SUPPLIED FROM RECYCLE/PURGE LINE FROM BASE PLANT RHC/IHT.

- REFERENCE**
- STREAM NUMBER
  - TEMPERATURE - CHECK CASE V REV 2 (°C)  
TEMPERATURE - CASE #21 (°C)
  - PRESSURE - CHECK CASE V REV 2 (kPa-a)  
PRESSURE - CASE #21 (kPa-a)
  - FLOW - CHECK CASE V REV 2 (kg/Hr)  
FLOW - CASE #21 (kg/Hr)
  - Std. VOL. FLOW - CHECK CASE V REV 2 (m<sup>3</sup> (st)/hr)  
Std. VOL. FLOW - CASE #21 (m<sup>3</sup> (st)/hr)

**ISSUED FOR CONSTRUCTION**  
21 Oct 2013

**FLUOR.** FLUOR'S RESPONSIBILITY IS LIMITED TO THE REVISION CONTENT SHOWN IN THIS DOCUMENT.

REV	ISSUED DATE	DESCRIPTION	BY	CHKD	PL	EGA	APE	PEM	CLINT APPR
4	13.30.09	RE-ISSUED IFC ON NEXT HARD REV	GB	CC	LMF			KH	CV
3C	12.21.12	ISSUED FOR CONSTRUCTION	GB	KB				KH	CV
3B	08.31.11	RE-ISSUED FOR QUEST DESIGN	JH	SM	SM			JL	CV M/SB
3A	03.04.11	RE-ISSUED FOR QUEST DESIGN	JH	SM	BS			JL	CV M/SB
3	10.25.10	ISSUED FOR QUEST DESIGN	JH	SM	BS			JL	CV M/SB
2A	08.24.10	ISSUED FOR QUEST COARSE HAZOP	JH						
2	04.17.07	ISSUED FOR DESIGN	PD	HG	RCD	RCD	PG		PB
1	06.15.06	ISSUED FOR DESIGN	RCD	HG		CJK	JT		RN
0	10.19.05	ISSUED FOR DESIGN	RCD	GM	PAN	CJK	JT		RN
A	09.01.05	ISSUED FOR APPROVAL	RCD	GM	PAN	CJK	JT		RN

SHELL CANADA ENERGY

BECHTEL

JOB No: 25183-C10  
M5-IH-440001

**Uhde**

PROCESS FLOW DIAGRAM  
SCOTFORD UPGRADER EXPANSION 1  
HYDROGEN MANUFACTURING - UNIT 440  
FEED INTAKE

SCALE: NONE  
SHELL DWG NO.: 440.0001.000.040.001 REV. 4

D


C

B


A

BORDER NAME: HM\_AIPDF\_Shell.DWG  
440.0001.000.040.001.DWG

FILE: T:\1010\PIPING\HMU\_PFD5\440-REV-2\440.0001.000.040.001.DWG:MODEL DATE: 04-23-2007, 8:35am BAOF

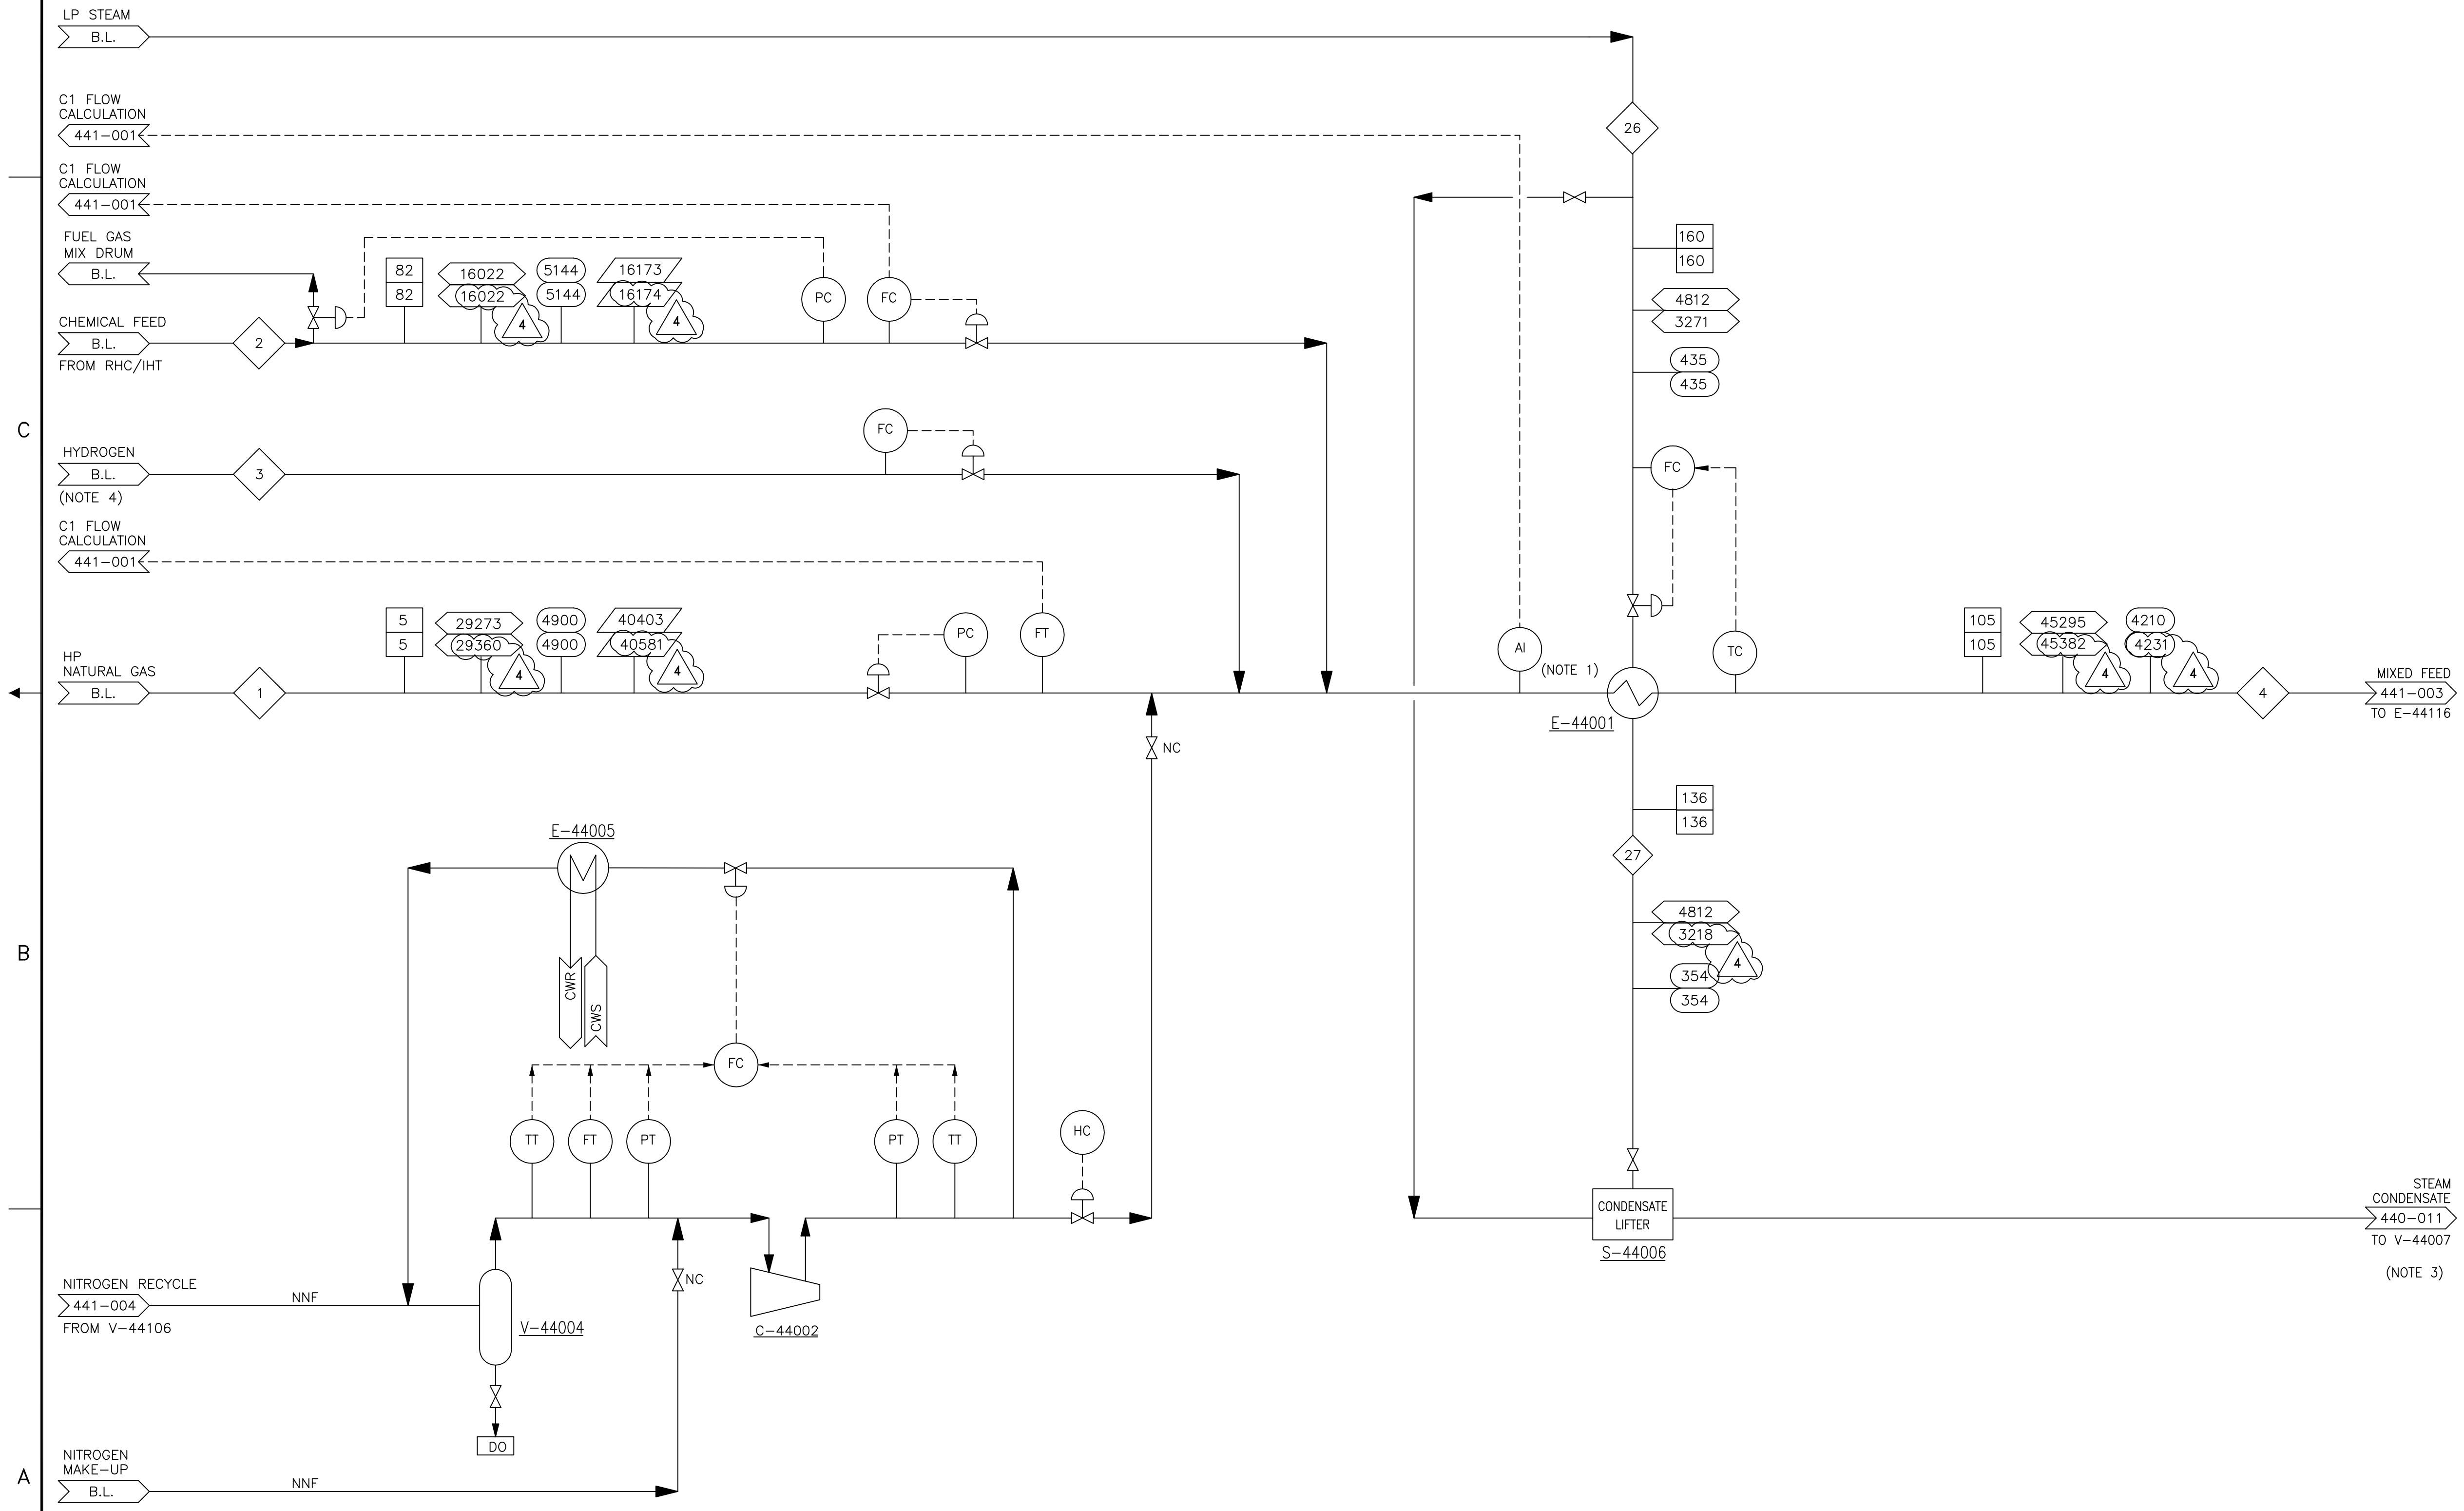



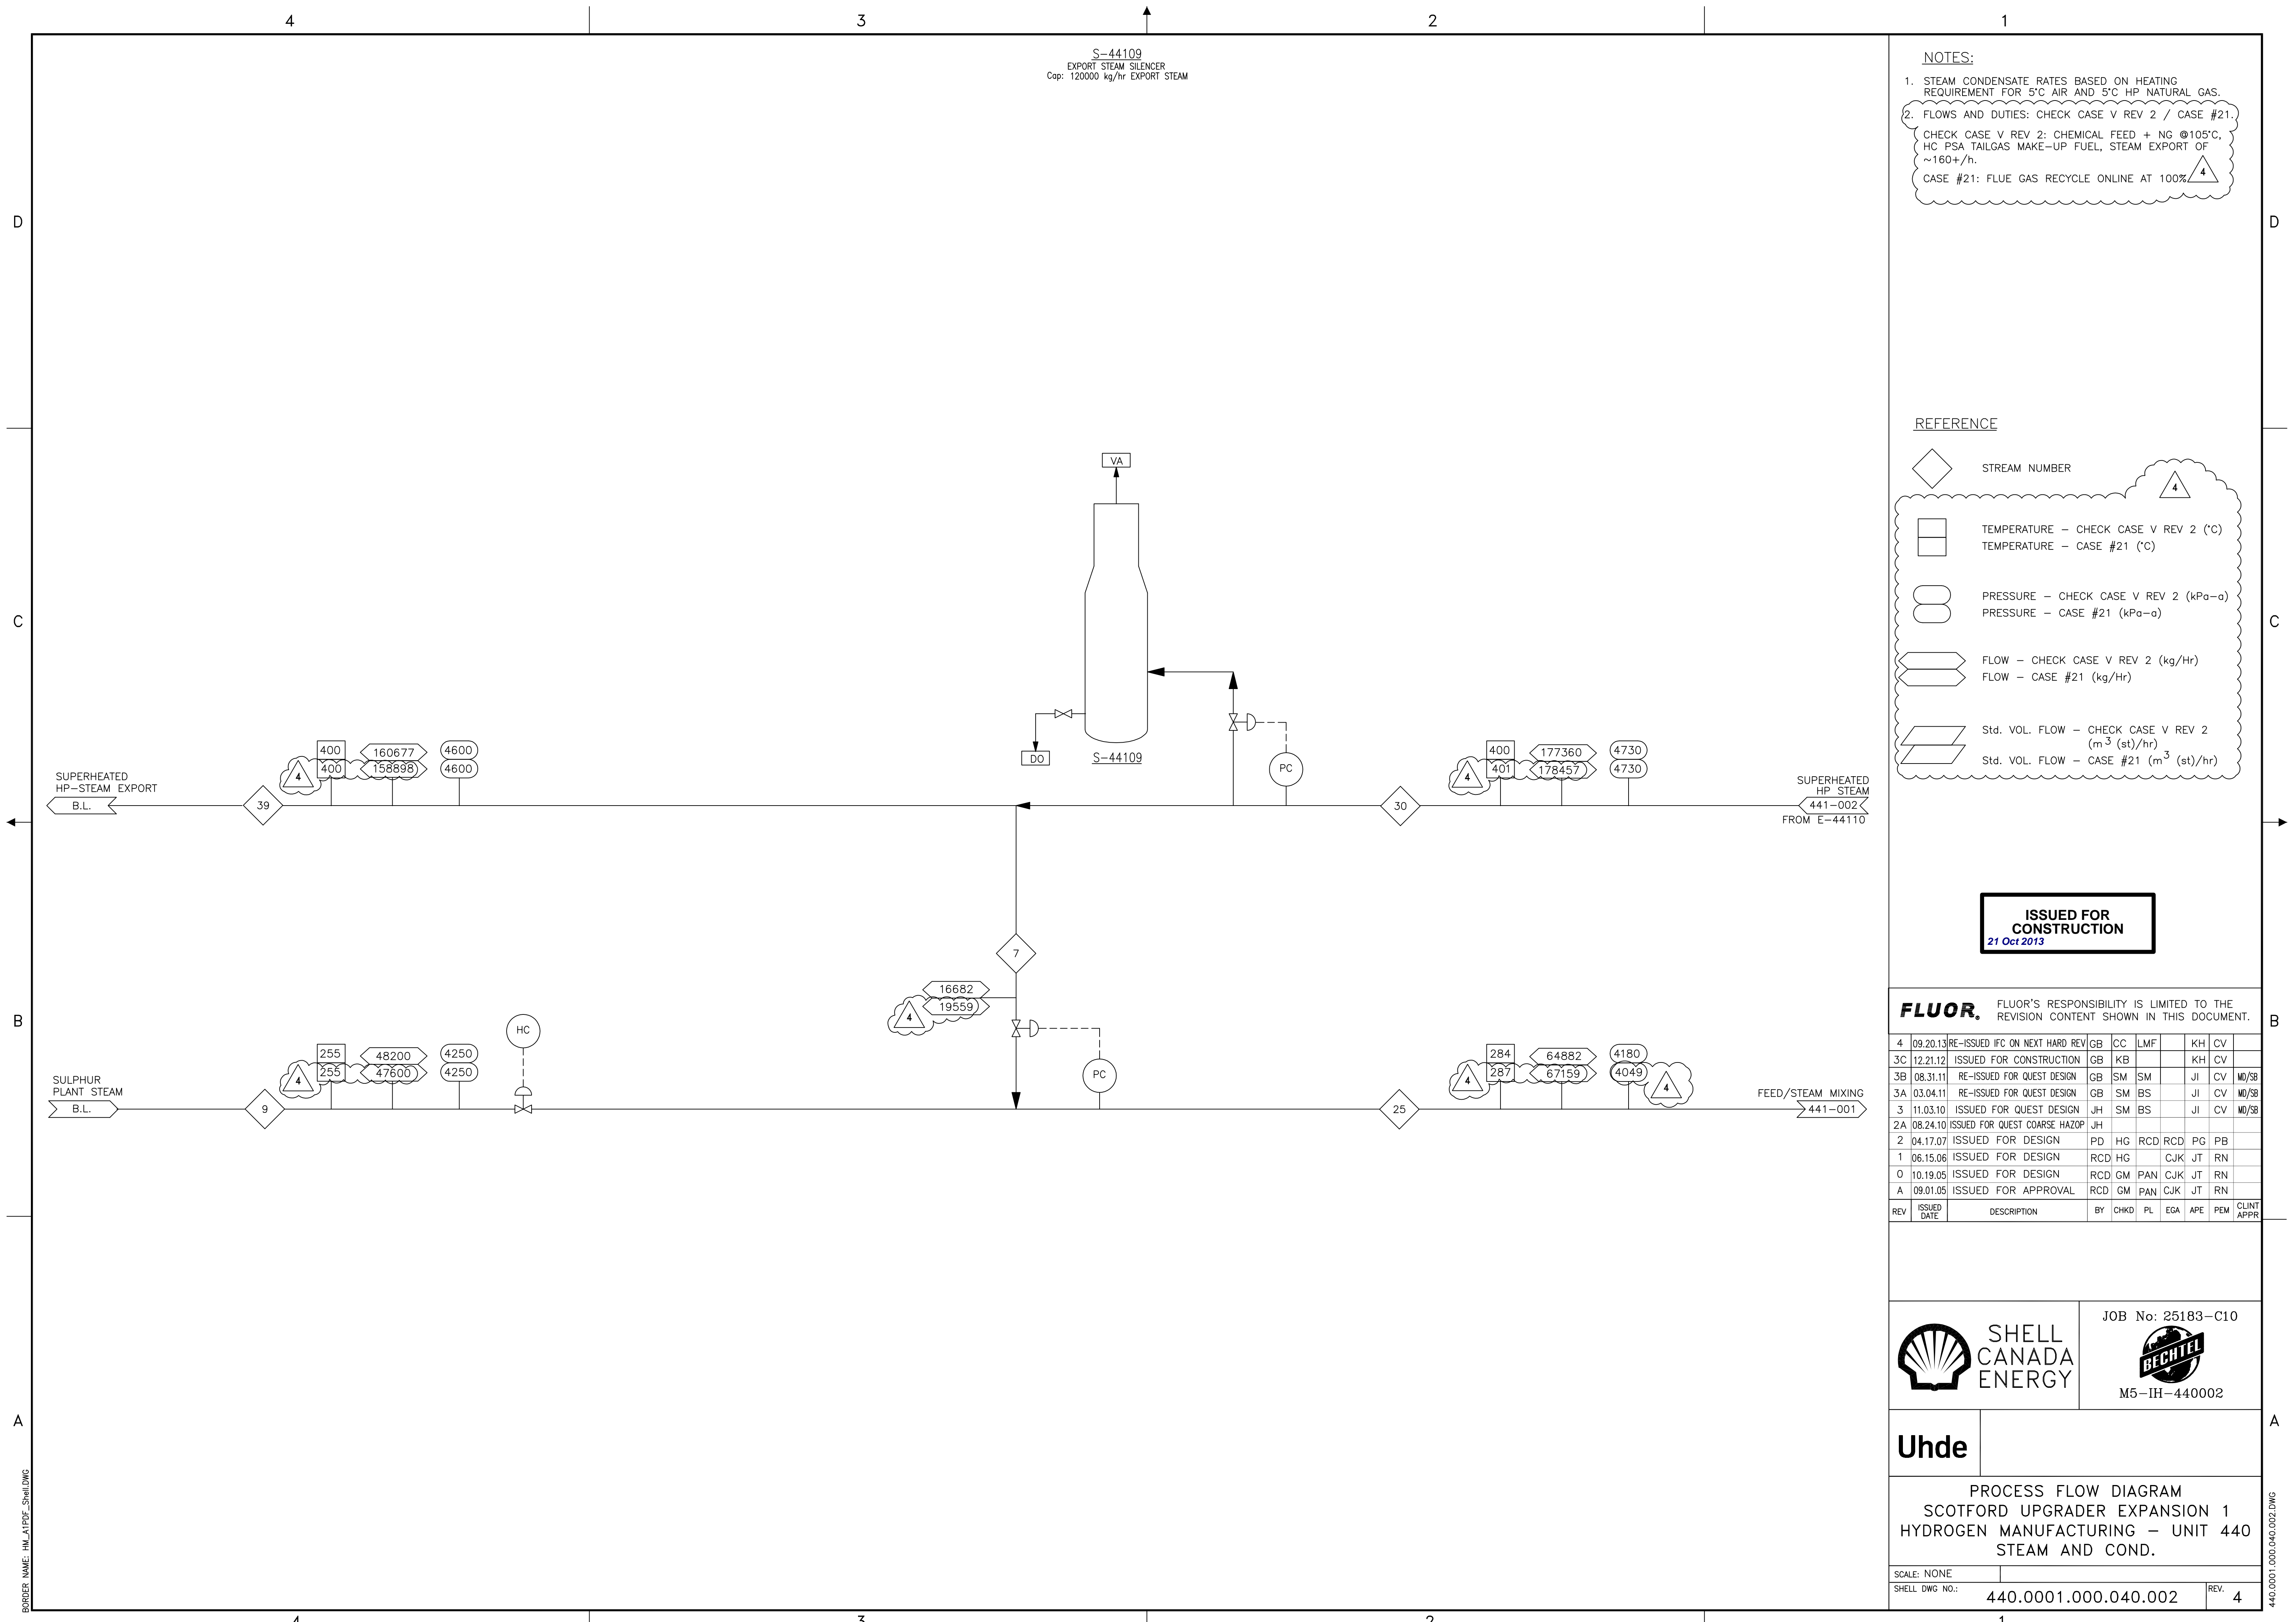

**NOTES:**

- STEAM CONDENSATE RATES BASED ON HEATING REQUIREMENT FOR 5°C AIR AND 5°C HP NATURAL GAS.
- FLOWS AND DUTIES: CHECK CASE V REV 2 / CASE #21.

CHECK CASE V REV 2: CHEMICAL FEED + NG @105°C, HC PSA TAILGAS MAKE-UP FUEL, STEAM EXPORT OF ~160+/h.

CASE #21: FLUE GAS RECYCLE ONLINE AT 100%

**REFERENCE**

STREAM NUMBER

TEMPERATURE - CHECK CASE V REV 2 (°C)  
TEMPERATURE - CASE #21 (°C)

PRESSURE - CHECK CASE V REV 2 (kPa-a)  
PRESSURE - CASE #21 (kPa-a)

FLOW - CHECK CASE V REV 2 (kg/Hr)  
FLOW - CASE #21 (kg/Hr)

Std. VOL. FLOW - CHECK CASE V REV 2 (m<sup>3</sup> (st)/hr)  
Std. VOL. FLOW - CASE #21 (m<sup>3</sup> (st)/hr)

**ISSUED FOR CONSTRUCTION**  
21 Oct 2013

**FLUOR.** FLUOR'S RESPONSIBILITY IS LIMITED TO THE REVISION CONTENT SHOWN IN THIS DOCUMENT.

REV	ISSUED DATE	DESCRIPTION	BY	CHKD	PL	EGA	APE	PEM	CLINT APPR
4	09.20.13	RE-ISSUED IFC ON NEXT HARD REV	GB	CC	LMF			KH	CV
3C	12.21.12	ISSUED FOR CONSTRUCTION	GB	KB				KH	CV
3B	08.31.11	RE-ISSUED FOR QUEST DESIGN	GB	SM	SM			JL	CV M/SB
3A	03.04.11	RE-ISSUED FOR QUEST DESIGN	GB	SM	BS			JL	CV M/SB
3	11.03.10	ISSUED FOR QUEST DESIGN	JH	SM	BS			JL	CV M/SB
2A	08.24.10	ISSUED FOR QUEST COARSE HAZOP	JH						
2	04.17.07	ISSUED FOR DESIGN	PD	HG	RCD	RCD	PG	PB	
1	06.15.06	ISSUED FOR DESIGN	RCD	HG	CJK	JT	RN		
0	10.19.05	ISSUED FOR DESIGN	RCD	GM	PAN	CJK	JT	RN	
A	09.01.05	ISSUED FOR APPROVAL	RCD	GM	PAN	CJK	JT	RN	

**SHELL CANADA ENERGY**

JOB No: 25183-C10

M5-IH-440002


**Uhde**

PROCESS FLOW DIAGRAM  
SCOTFORD UPGRADE EXPANSION 1  
HYDROGEN MANUFACTURING - UNIT 440  
STEAM AND COND.

SCALE: NONE  
SHELL DWG NO.: 440.0001.000.040.002 REV. 4

BORDER NAME: HM\_AIPDF\_Shell.DWG

FILE: T:\1010\PIPING\HMU\HMU\_PFD\440-REV-2\440.0001.000.040.002.DWG:MODEL DATE: 04-16-2007, 12:54pm BAOF

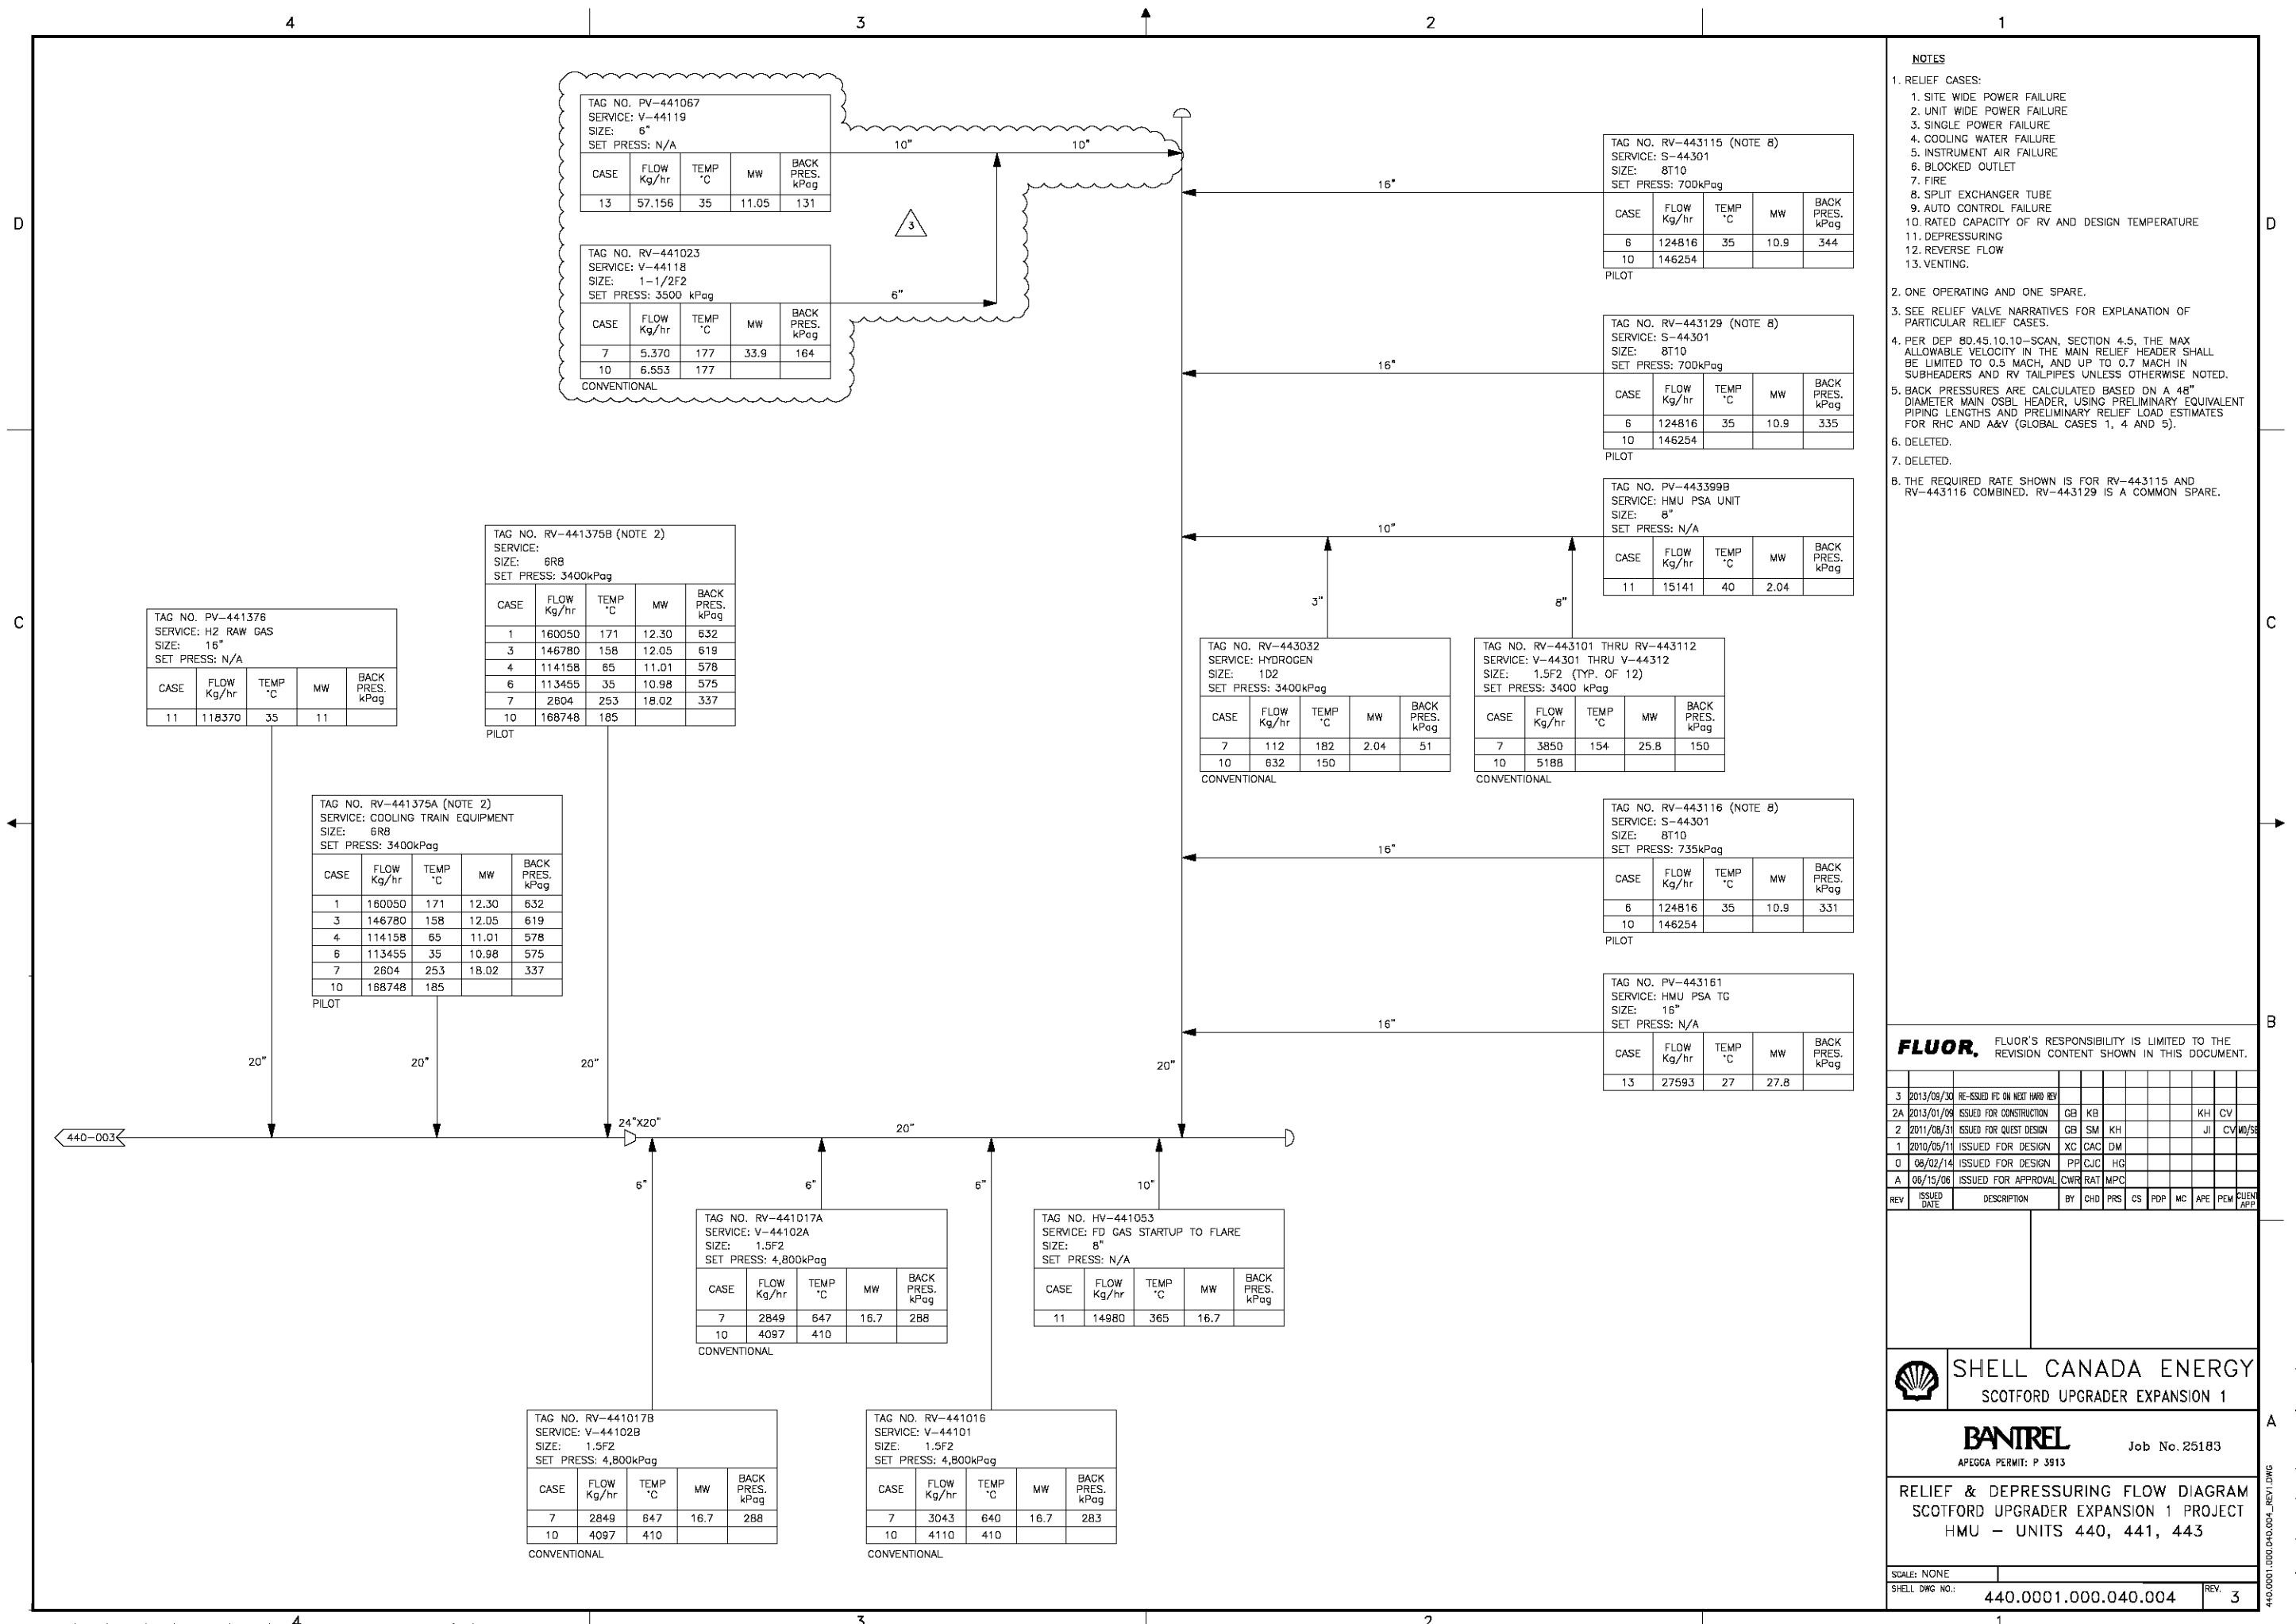

TAG NO. PV-441067  
SERVICE: V-44119  
SIZE: 6"  
SET PRESS: N/A

CASE	FLOW Kg/hr	TEMP °C	MW	BACK PRES. kPag
13	57.156	35	11.05	131

TAG NO. RV-441023  
SERVICE: V-44118  
SIZE: 1-1/2F2  
SET PRESS: 3500 kPag  
CONVENTIONAL

CASE	FLOW Kg/hr	TEMP °C	MW	BACK PRES. kPag
7	5.370	177	33.9	164
10	6.553	177		

TAG NO. RV-443115 (NOTE 8)  
SERVICE: S-44301  
SIZE: 8T10  
SET PRESS: 700kPag  
PILOT

CASE	FLOW Kg/hr	TEMP °C	MW	BACK PRES. kPag
6	124816	35	10.9	344
10	146254			

TAG NO. RV-443129 (NOTE 8)  
SERVICE: S-44301  
SIZE: 8T10  
SET PRESS: 700kPag  
PILOT

CASE	FLOW Kg/hr	TEMP °C	MW	BACK PRES. kPag
6	124816	35	10.9	335
10	146254			

TAG NO. PV-443399B  
SERVICE: HMU PSA UNIT  
SIZE: 8"  
SET PRESS: N/A

CASE	FLOW Kg/hr	TEMP °C	MW	BACK PRES. kPag
11	15141	40	2.04	

TAG NO. RV-441375B (NOTE 2)  
SERVICE: 6RB  
SET PRESS: 3400kPag  
PILOT

CASE	FLOW Kg/hr	TEMP °C	MW	BACK PRES. kPag
1	160050	171	12.30	532
3	146780	158	12.05	619
4	114158	65	11.01	578
6	113455	35	10.98	575
7	2604	25.3	18.02	337
10	168748	185		

TAG NO. PV-441376  
SERVICE: H2 RAW GAS  
SIZE: 16"  
SET PRESS: N/A

CASE	FLOW Kg/hr	TEMP °C	MW	BACK PRES. kPag
11	118370	35	11	

TAG NO. RV-441375A (NOTE 2)  
SERVICE: COOLING TRAIN EQUIPMENT  
SIZE: 6RB  
SET PRESS: 3400kPag  
PILOT

CASE	FLOW Kg/hr	TEMP °C	MW	BACK PRES. kPag
1	160050	171	12.30	532
3	146780	158	12.05	619
4	114158	65	11.01	578
6	113455	35	10.98	575
7	2604	25.3	18.02	337
10	168748	185		

TAG NO. RV-443032  
SERVICE: HYDROGEN  
SIZE: 1D2  
SET PRESS: 3400kPag  
CONVENTIONAL

CASE	FLOW Kg/hr	TEMP °C	MW	BACK PRES. kPag
7	112	182	2.04	51
10	832	150		

TAG NO. RV-443101 THRU RV-443112  
SERVICE: V-44301 THRU V-44312  
SIZE: 1.5F2 (TYP. OF 12)  
SET PRESS: 3400 kPag  
CONVENTIONAL

CASE	FLOW Kg/hr	TEMP °C	MW	BACK PRES. kPag
7	3850	154	25.8	150
10	5188			

TAG NO. RV-443116 (NOTE 8)  
SERVICE: S-44301  
SIZE: 8T10  
SET PRESS: 735kPag  
PILOT

CASE	FLOW Kg/hr	TEMP °C	MW	BACK PRES. kPag
6	124816	35	10.9	331
10	146254			

TAG NO. PV-443161  
SERVICE: HMU PSA TG  
SIZE: 16"  
SET PRESS: N/A

CASE	FLOW Kg/hr	TEMP °C	MW	BACK PRES. kPag
13	27593	27	27.8	

TAG NO. RV-441017A  
SERVICE: V-44102A  
SIZE: 1.5F2  
SET PRESS: 4,800kPag  
CONVENTIONAL

CASE	FLOW Kg/hr	TEMP °C	MW	BACK PRES. kPag
7	2849	647	16.7	288
10	4097	410		

TAG NO. HV-441053  
SERVICE: FD GAS STARTUP TO FLARE  
SIZE: 8"  
SET PRESS: N/A

CASE	FLOW Kg/hr	TEMP °C	MW	BACK PRES. kPag
11	14980	365	16.7	

TAG NO. RV-441017B  
SERVICE: V-44102B  
SIZE: 1.5F2  
SET PRESS: 4,800kPag  
CONVENTIONAL

CASE	FLOW Kg/hr	TEMP °C	MW	BACK PRES. kPag
7	2849	647	16.7	288
10	4097	410		

TAG NO. RV-441016  
SERVICE: V-44101  
SIZE: 1.5F2  
SET PRESS: 4,800kPag  
CONVENTIONAL

CASE	FLOW Kg/hr	TEMP °C	MW	BACK PRES. kPag
7	3043	640	16.7	283
10	4110	410		

- NOTES**
- RELIEF CASES:
    - SITE WIDE POWER FAILURE
    - UNIT WIDE POWER FAILURE
    - SINGLE POWER FAILURE
    - COOLING WATER FAILURE
    - INSTRUMENT AIR FAILURE
    - BLOCKED OUTLET
    - FIRE
    - SPLIT EXCHANGER TUBE
    - AUTO CONTROL FAILURE
    - RATED CAPACITY OF RV AND DESIGN TEMPERATURE
    - DEPRESSURING
    - REVERSE FLOW
    - VENTING.
  - ONE OPERATING AND ONE SPARE.
  - SEE RELIEF VALVE NARRATIVES FOR EXPLANATION OF PARTICULAR RELIEF CASES.
  - PER DEP. 80.45.10.10-SCAN, SECTION 4.5, THE MAX ALLOWABLE VELOCITY IN THE MAIN RELIEF HEADER SHALL BE LIMITED TO 0.5 MACH, AND UP TO 0.7 MACH IN SUBHEADERS AND RV TAILPIPIES UNLESS OTHERWISE NOTED.
  - BACK PRESSURES ARE CALCULATED BASED ON A 48" DIAMETER MAIN OSBL HEADER, USING PRELIMINARY EQUIVALENT PIPING LENGTHS AND PRELIMINARY RELIEF LOAD ESTIMATES FOR RHC AND A&V (GLOBAL CASES 1, 4 AND 5).
  - DELETED.
  - DELETED.
  - THE REQUIRED RATE SHOWN IS FOR RV-443115 AND RV-443116 COMBINED. RV-443129 IS A COMMON SPARE.

**FLUOR.** FLUOR'S RESPONSIBILITY IS LIMITED TO THE REVISION CONTENT SHOWN IN THIS DOCUMENT.


REV	ISSUED DATE	DESCRIPTION	BY	CHKD	PRS	CS	PDR	MC	APE	PEM	BUEN APP
3	2013/09/30	RE-ISSUED IFC ON NEXT HWB REV									
2A	2013/01/09	ISSUED FOR CONSTRUCTION	GB	KB						KH	CV
2	2011/08/31	ISSUED FOR QUEST DESIGN	GB	SM	KH					JL	CV/MJ/SE
1	2010/05/11	ISSUED FOR DESIGN	XC	CAC	DM						
0	08/02/14	ISSUED FOR DESIGN	PP	CJC	HG						
A	08/15/06	ISSUED FOR APPROVAL	CWR	RAT	MPC						

**SHELL CANADA ENERGY**  
SCOTFORD UPGRADE EXPANSION 1

**BANTREL** Job No. 25183  
APEGGA PERMIT: P 3913

RELIEF & DEPRESSURING FLOW DIAGRAM  
SCOTFORD UPGRADE EXPANSION 1 PROJECT  
HMU - UNITS 440, 441, 443

SCALE: NONE	SHELL DWG NO.: 440.0001.000.040.004	REV: 3
-------------	-------------------------------------	--------

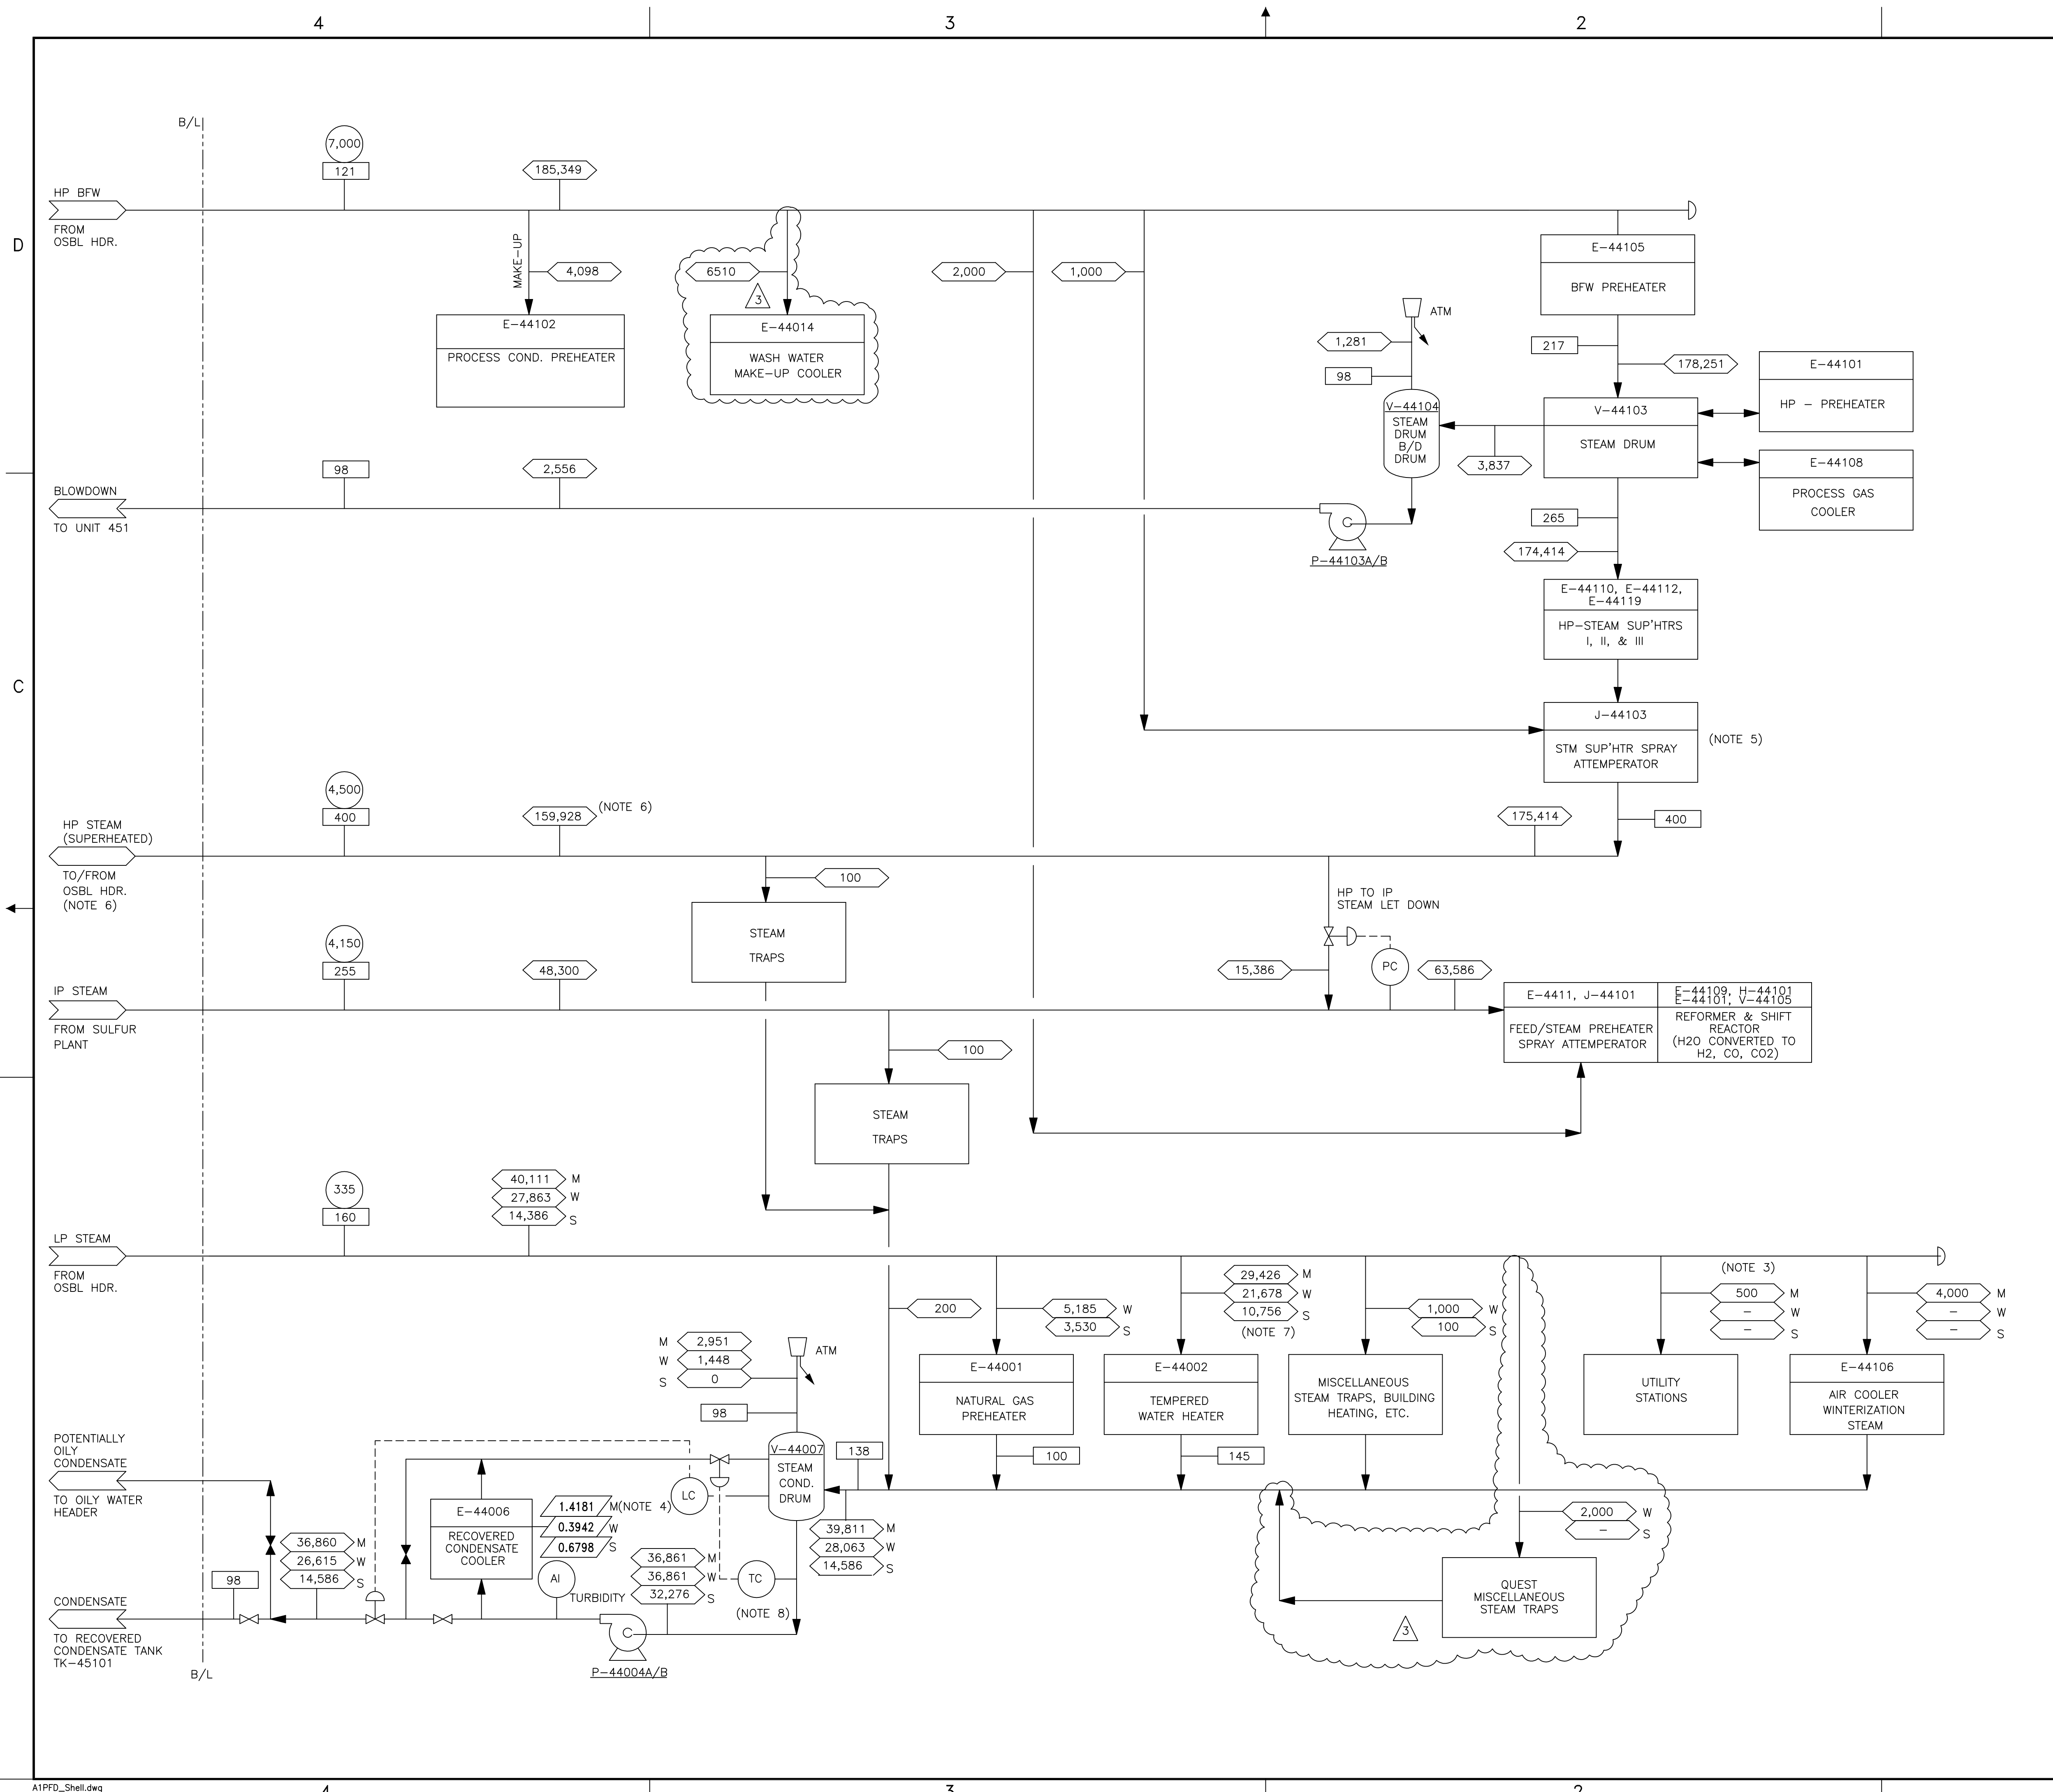

- NOTES:**
1. THE CONFIGURATION OF THE DRAWING DOES NOT REPRESENT GEOGRAPHICAL LAYOUT.
  2. DELETED.
  3. NOT MORE THAN TWO UTILITY STATIONS ARE OPERATING AT ANY TIME IN THE HMU AREA. NORMALLY NO FLOW.
  4. MAXIMUM EXCHANGER DUTY IS BASED ON COOLING ALL THE CONDENSATE FROM V-44007 TO 65°C AND ROUTING IT TO OILY WATER HEADER.
  5. J-44102 AND J-44104, NORMALLY NO FLOW. NEEDED ONLY FOR THE 200 T/H HP STEAM PRODUCTION CASE (ELIMINATED FROM THE DESIGN SCOPE).
  6. NORMAL EXPORT FLOW. AT START-UP HP STEAM IS IMPORTED.
  7. WINTER STEAM CONSUMPTION RATE IS BASED ON HEATING AIR FROM -43°C TO 80°C. SUMMER STEAM CONSUMPTION RATE IS BASED ON HEATING AIR FROM 19°C TO 80°C.
  8. HI LEVEL IN V-44007 OVERRIDES TC.
  9. MATERIAL BALANCE TO BE UPDATED FOR UHDE INPUT FOR QUEST OPERATION.

**LEGEND**

- TEMPERATURE, °C.
- PRESSURE, kPag.
- FLOW, Kg/hr
- DUTY, MW
- W - WINTER
- S - SUMMER
- M - MAXIMUM

**ISSUED FOR CONSTRUCTION**  
21 Oct 2013

**FLUOR.** FLUOR'S RESPONSIBILITY IS LIMITED TO THE REVISION CONTENT SHOWN IN THIS DOCUMENT.

REV	ISSUED DATE	DESCRIPTION	BY	CHK	PRS	CS	PDP	MC	APE	PEM	CLIENT APP
3	09/30/13	RE-ISSUED IFC ON NEXT HARD REV	GB	CC			LMF			KH	CV
2B	01/10/13	ISSUED FOR CONSTRUCTION	GB	KB						KH	CV
2A	03/01/11	RE-ISSUED FOR QUEST DESIGN	GB	SM	MB					JL	CV MD/SB
2	11/03/10	REISSUED FOR DESIGN	GB	SM	MB					JL	CV MD/SB
1	05/10/06	REISSUED FOR DESIGN	HG	RCD	CJK					JT	RSN
0	11/21/05	ISSUED FOR DESIGN	RAT	PAN	CJK					JT	RSN
A	9/30/05	ISSUED FOR APPROVAL	GM	PAN	CJK					JT	RN

**SHELL CANADA LTD.**  
AOSP - DOWNSTREAM EXPANSION PROJECT

**BECHTEL** Job No. 25183-C10

**UTILITY FLOW DIAGRAM**  
AOSP DOWNSTREAM EXPANSION PROJECT  
HYDROGEN MANUFACTURING UNIT  
STEAM/CONDENSATE/BFW

SCALE: NONE  
SHELL DWG NO.: 440.0001.000.040.011 REV. 3




V-44101  
HYDROGENATION REACTOR  
2900 mm I.D. x 2650 mm T/T

V-44102A  
DESULPHURIZATION REACTOR  
2900 mm I.D. x 2470 mm T/T

V-44102B  
DESULPHURIZATION REACTOR  
2900 mm I.D. x 2470 mm T/T

S-44108  
PROCESS STEAM SILENCER  
Cap: 25000 kg/hr PROCESS STEAM

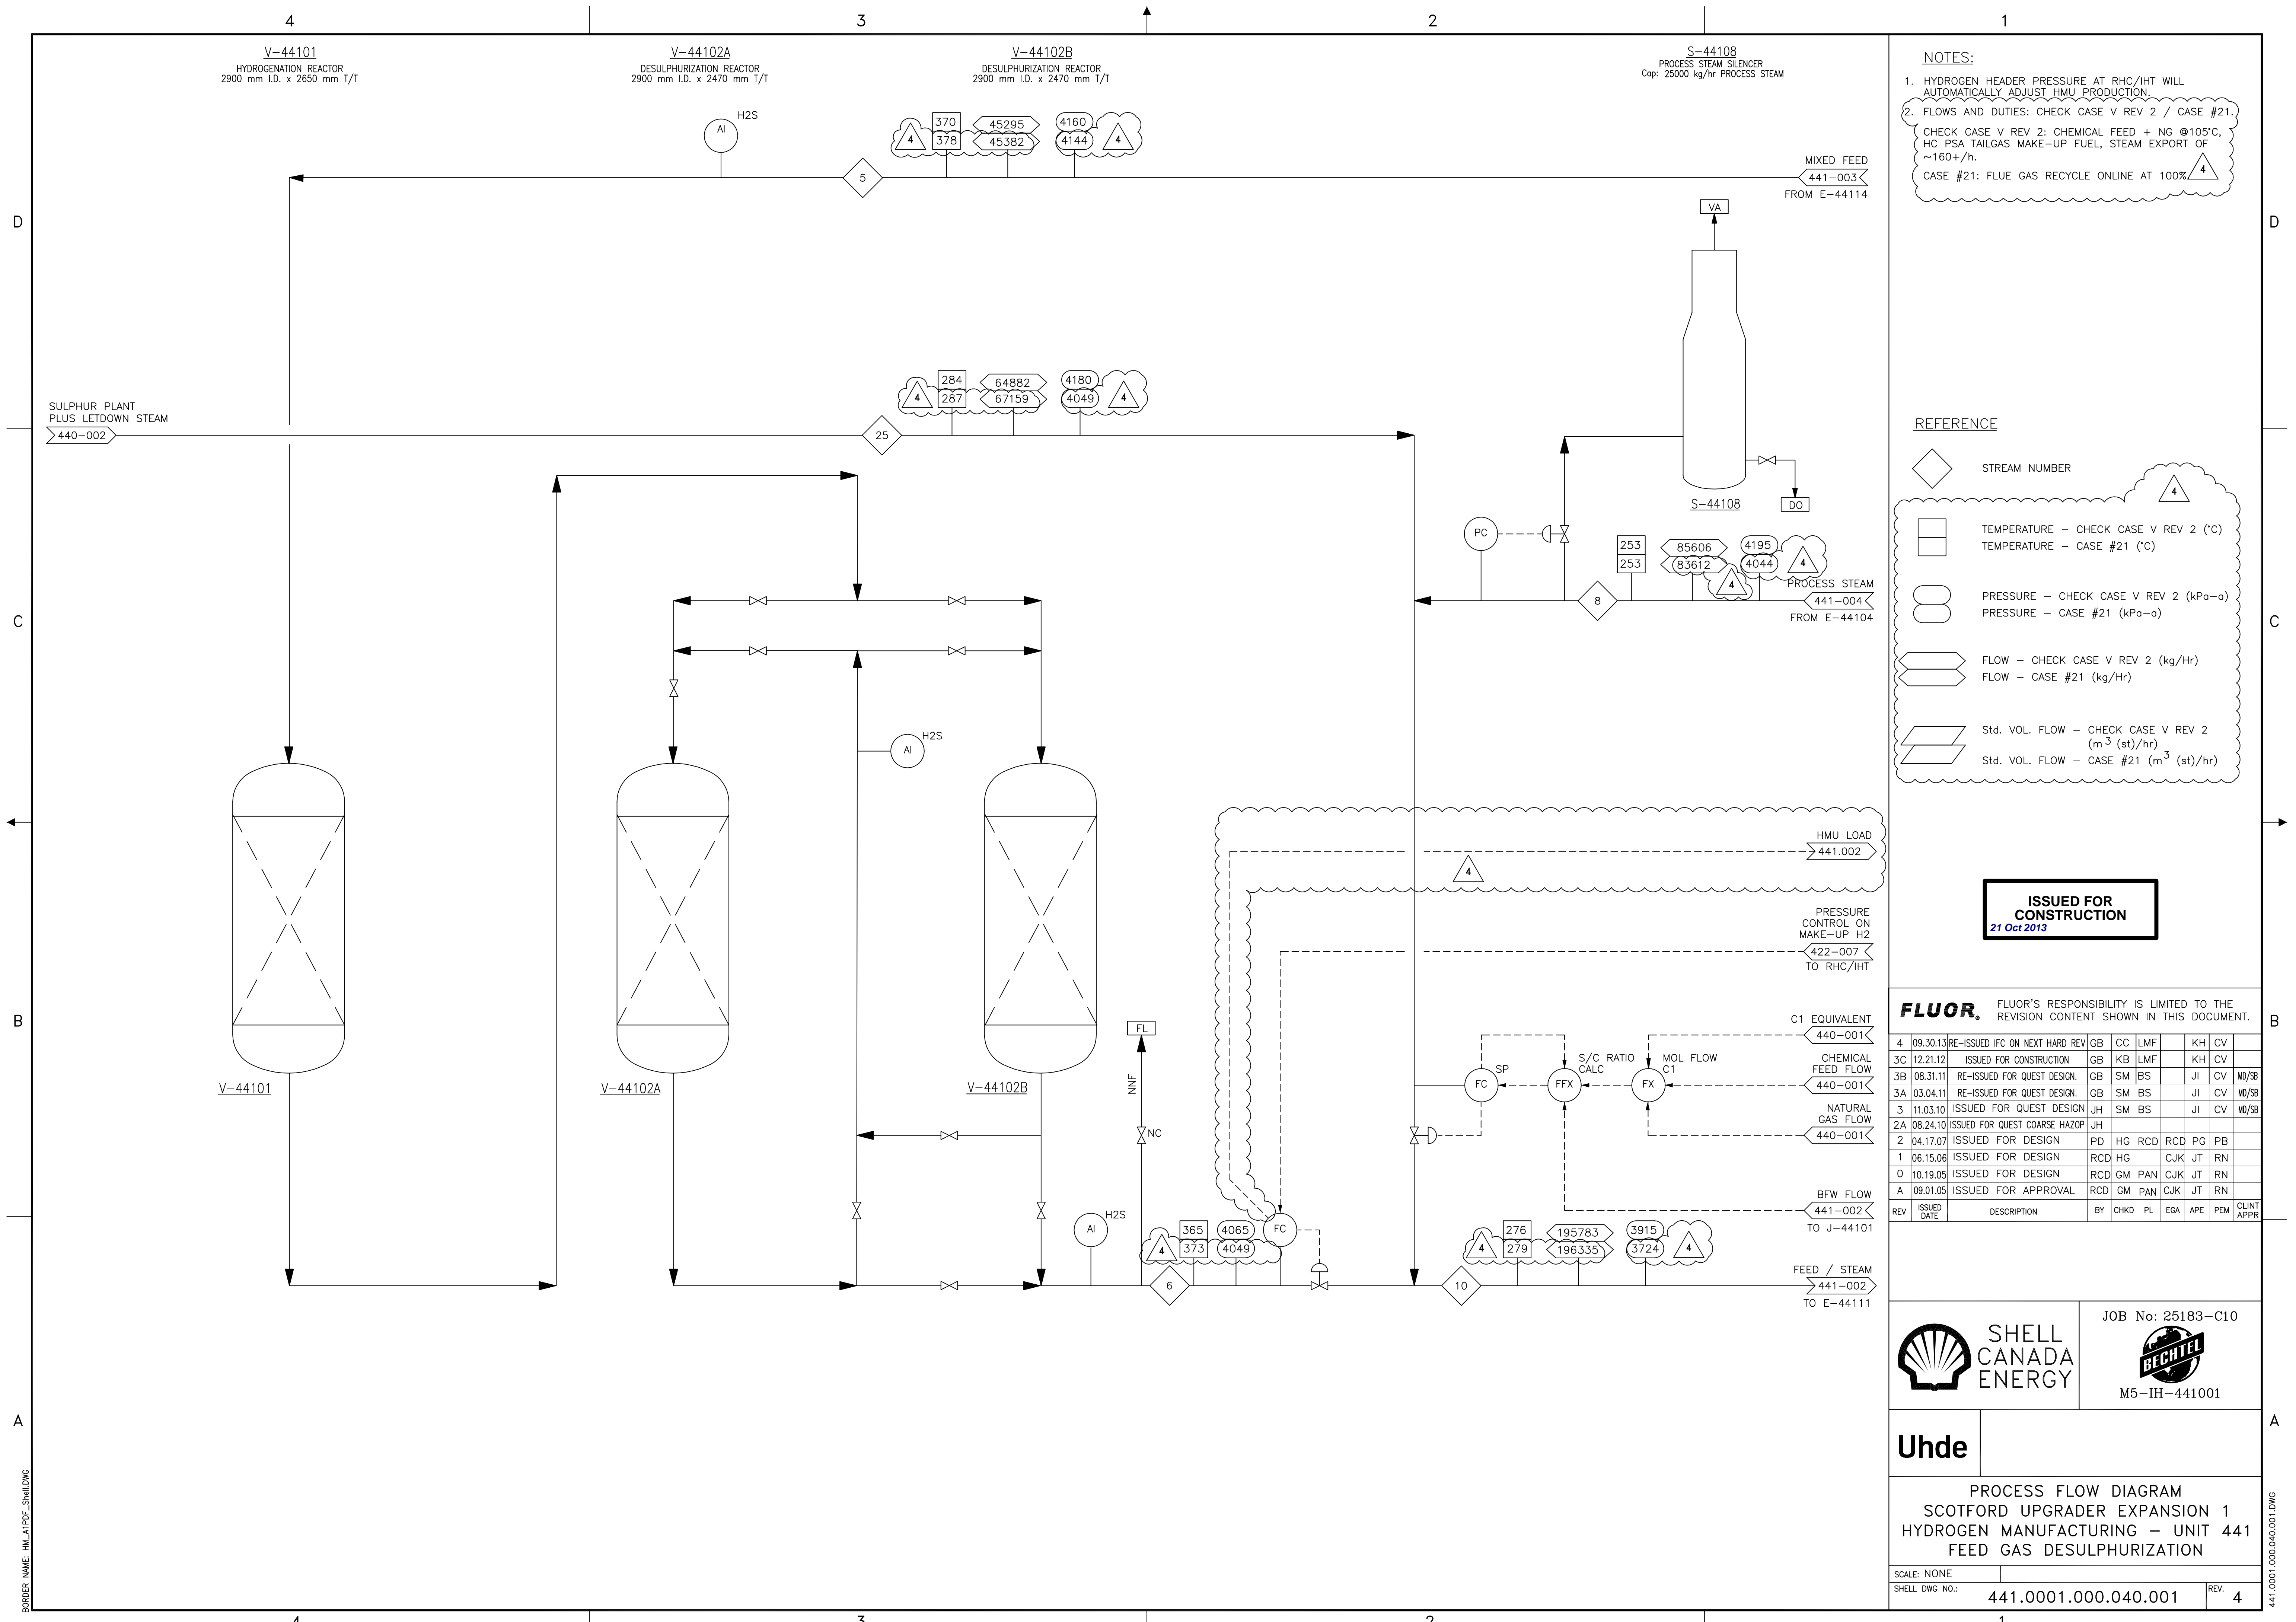

**NOTES:**

1. HYDROGEN HEADER PRESSURE AT RHC/IHT WILL AUTOMATICALLY ADJUST HMU PRODUCTION.
2. FLOWS AND DUTIES: CHECK CASE V REV 2 / CASE #21.  
CHECK CASE V REV 2: CHEMICAL FEED + NG @105°C, HC PSA TAILGAS MAKE-UP FUEL, STEAM EXPORT OF ~160+/h.  
CASE #21: FLUE GAS RECYCLE ONLINE AT 100%

**REFERENCE**

- ◇ STREAM NUMBER
- TEMPERATURE - CHECK CASE V REV 2 (°C)  
□ TEMPERATURE - CASE #21 (°C)
- PRESSURE - CHECK CASE V REV 2 (kPa-a)  
○ PRESSURE - CASE #21 (kPa-a)
- ▭ FLOW - CHECK CASE V REV 2 (kg/Hr)  
▭ FLOW - CASE #21 (kg/Hr)
- ▭ Std. VOL. FLOW - CHECK CASE V REV 2 (m<sup>3</sup> (st)/hr)  
▭ Std. VOL. FLOW - CASE #21 (m<sup>3</sup> (st)/hr)

**ISSUED FOR CONSTRUCTION**  
21 Oct 2013

**FLUOR.** FLUOR'S RESPONSIBILITY IS LIMITED TO THE REVISION CONTENT SHOWN IN THIS DOCUMENT.

REV	ISSUED DATE	DESCRIPTION	BY	CHKD	PL	EGA	APE	PEM	CLINT APPR
4	09.30.13	RE-ISSUED IFC ON NEXT HARD REV	GB	CC	LMF			KH	CV
3C	12.21.12	ISSUED FOR CONSTRUCTION	GB	KB	LMF			KH	CV
3B	08.31.11	RE-ISSUED FOR QUEST DESIGN.	GB	SM	BS			JI	CV
3A	03.04.11	RE-ISSUED FOR QUEST DESIGN.	GB	SM	BS			JI	CV
3	11.03.10	ISSUED FOR QUEST DESIGN	JH	SM	BS			JI	CV
2A	08.24.10	ISSUED FOR QUEST COARSE HAZOP	JH						
2	04.17.07	ISSUED FOR DESIGN	PD	HG	RCD	RCD	PG	PB	
1	06.15.06	ISSUED FOR DESIGN	RCD	HG		CJK	JT	RN	
0	10.19.05	ISSUED FOR DESIGN	RCD	GM	PAN	CJK	JT	RN	
A	09.01.05	ISSUED FOR APPROVAL	RCD	GM	PAN	CJK	JT	RN	

**SHELL CANADA ENERGY**

**BECHTEL**

JOB No: 25183-C10  
M5-IH-441001


**Uhde**

PROCESS FLOW DIAGRAM  
SCOTFORD UPGRADER EXPANSION 1  
HYDROGEN MANUFACTURING - UNIT 441  
FEED GAS DESULPHURIZATION

SCALE: NONE  
SHELL DWG NO.: 441.0001.000.040.001  
REV. 4

BORDER NAME: HM\_A1PDF\_Shell.DWG

FILE: T:\1010\PIPING\HMU\HMU\_PFD\441-REV-2\441.0001.000.040.001.DWG:MODEL DATE: 04-16-2007, 1:06pm BAOF

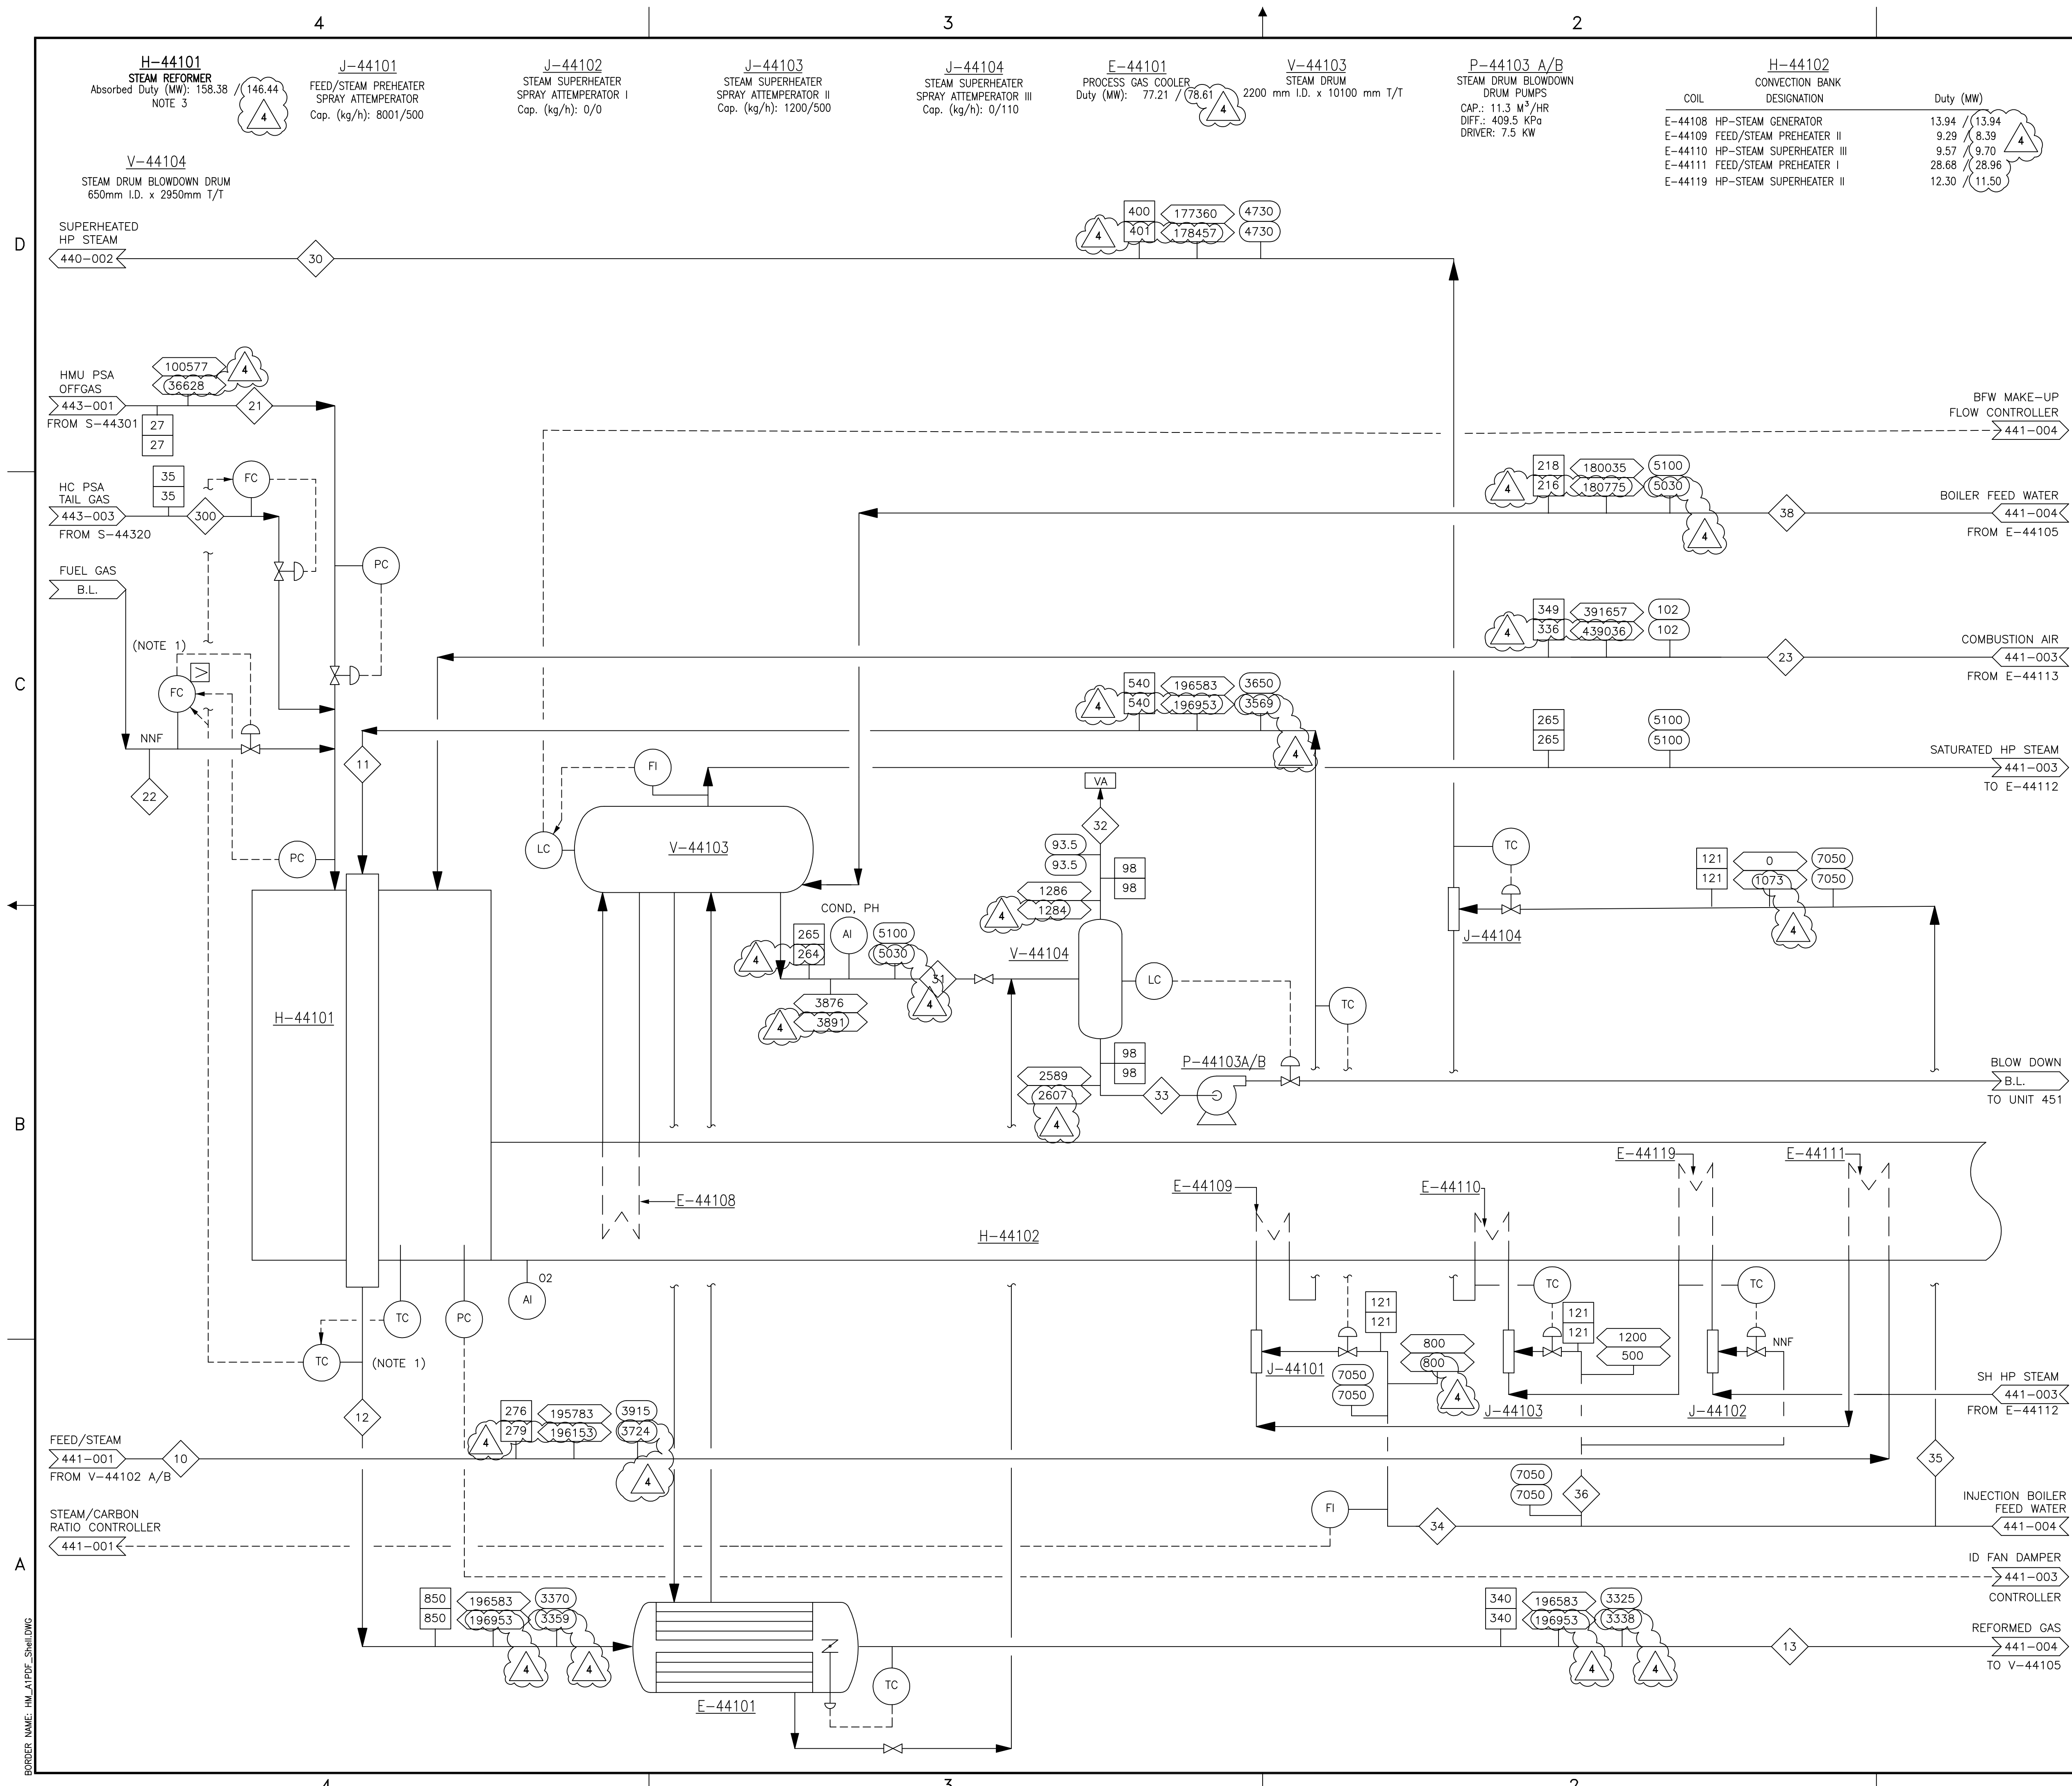

- NOTES:**
- PROCESS SIDE TEMPERATURE IS CONTROLLED, WITH CHANGES IN FLUE GAS TEMPERATURE USED TO INITIATE TAIL GAS AND/OR FUEL GAS FLOW CHANGES TO MINIMIZE DEVIATIONS IN THE PROCESS TEMPERATURE.
  - FLOWS AND DUTIES: CHECK CASE V REV 2 / CASE #21.  
CHECK CASE V REV 2: CHEMICAL FEED + NG @105°C, HC PSA TAILGAS MAKE-UP FUEL, STEAM EXPORT OF ~160+/h.  
CASE #21: FLUE GAS RECYCLE ONLINE AT 100%.
  - EXISTING BURNER LANCES TO BE REPLACED WITH LANEMARK LOW NOX BURNERS.

- REFERENCE**
- ◇ STREAM NUMBER
  - TEMPERATURE - CHECK CASE V REV 2 (°C)  
□ TEMPERATURE - CASE #21 (°C)
  - PRESSURE - CHECK CASE V REV 2 (kPa-a)  
○ PRESSURE - CASE #21 (kPa-a)
  - ▭ FLOW - CHECK CASE V REV 2 (kg/Hr)  
▭ FLOW - CASE #21 (kg/Hr)
  - ▭ Std. VOL. FLOW - CHECK CASE V REV 2 (m<sup>3</sup> (st)/hr)  
▭ Std. VOL. FLOW - CASE #21 (m<sup>3</sup> (st)/hr)

**ISSUED FOR CONSTRUCTION**  
21 Oct 2013

**FLUOR.** FLUOR'S RESPONSIBILITY IS LIMITED TO THE REVISION CONTENT SHOWN IN THIS DOCUMENT.

REV	ISSUED DATE	DESCRIPTION	BY	CHKD	PL	EGA	APE	PEM	CLINT APPR
4	09.30.13	RE-ISSUED IFC ON NEXT HARD REV	GB	CC	LMF			KH	CV
3C	12.21.12	ISSUED FOR CONSTRUCTION	GB	KB				KH	CV
3B	08.31.11	RE-ISSUED FOR QUEST DESIGN	GB	SM	SM			JL	CV M0/SB
3A	03.04.11	RE-ISSUED FOR QUEST DESIGN	JH	SM	BS			JL	CV M0/SB
3	11.03.10	ISSUED FOR QUEST DESIGN	JH	SM	BS			JL	CV M0/SB
2A	08.24.10	ISSUED FOR QUEST COARSE HAZOP	JH						
2	04.17.07	ISSUED FOR DESIGN	PD	HG	RCD	RCD	PG	PB	
1	06.15.06	ISSUED FOR DESIGN	RCD	HG	CJK	JT	RN		
0	10.19.05	ISSUED FOR DESIGN	RCD	GM	PAN	CJK	JT	RN	
A	09.01.05	ISSUED FOR APPROVAL	RCD	GM	PAN	CJK	JT	RN	

**SHELL CANADA ENERGY** JOB No: 25183-C10

**BECHTEL** M5-IH-441002

**Uhde**


**PROCESS FLOW DIAGRAM**  
SCOTFORD UPGRADE EXPANSION 1  
HYDROGEN MANUFACTURING - UNIT 441  
STEAM REFORMING

SCALE: NONE  
SHELL DWG NO.: 441.0001.000.040.002 REV. 4

BORDER NAME: HM\_A1PDF\_Shell.DWG

FILE: T:\1010\PIPING\HMU\HMU\_PFD5\441-REV-2\441.0001.000.040.002.DWG:MODEL DATE: 04-16-2007, 1:28pm BAOF



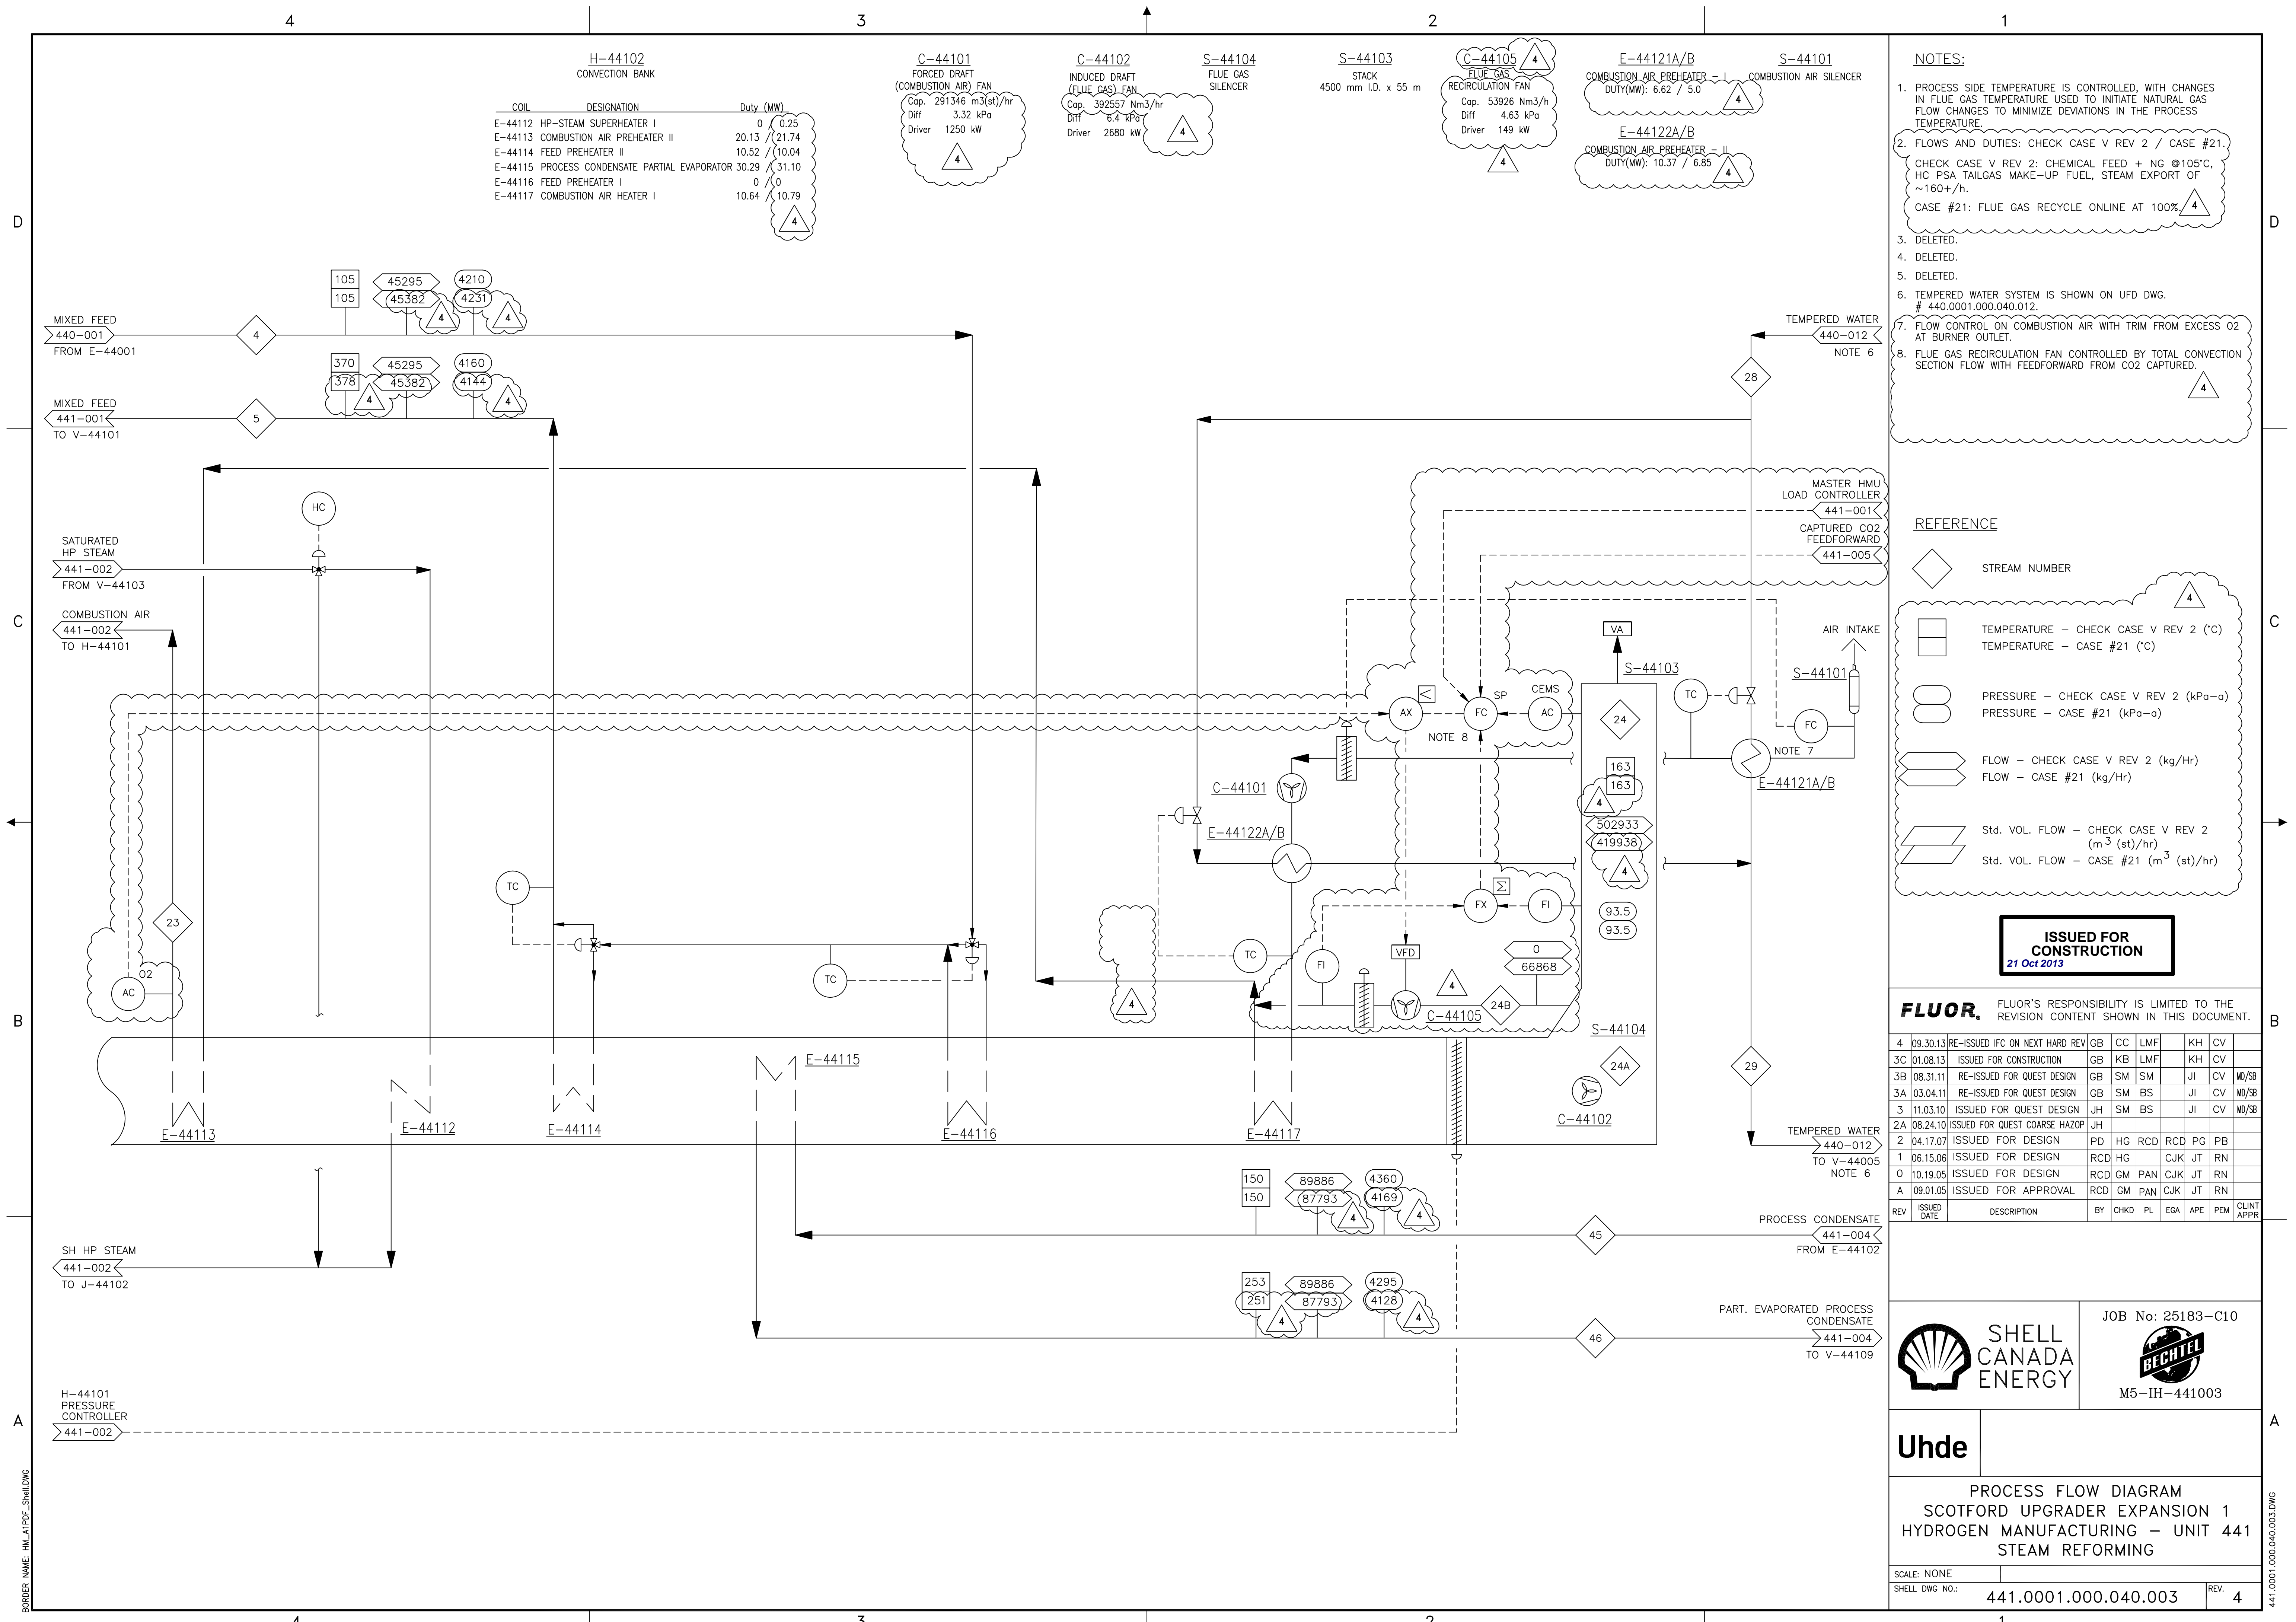

H-44102  
CONVECTION BANK

COIL	DESIGNATION	Duty (MW)
E-44112	HP-STEAM SUPERHEATER I	0 / 0.25
E-44113	COMBUSTION AIR PREHEATER II	20.13 / 21.74
E-44114	FEED PREHEATER II	10.52 / 10.04
E-44115	PROCESS CONDENSATE PARTIAL EVAPORATOR	30.29 / 31.10
E-44116	FEED PREHEATER I	0 / 0
E-44117	COMBUSTION AIR HEATER I	10.64 / 10.79

C-44101  
FORCED DRAFT  
(COMBUSTION AIR) FAN  
Cap. 291346 m<sup>3</sup>(st)/hr  
Diff 3.32 kPa  
Driver 1250 kW

C-44102  
INDUCED DRAFT  
(FLUE GAS) FAN  
Cap. 392557 Nm<sup>3</sup>/hr  
Diff 6.4 kPa  
Driver 2680 kW

S-44104  
FLUE GAS  
SILENCER

S-44103  
STACK  
4500 mm I.D. x 55 m

C-44105  
FLUE GAS  
RECIRCULATION FAN  
Cap. 53926 Nm<sup>3</sup>/h  
Diff 4.63 kPa  
Driver 149 kW

E-44121A/B  
COMBUSTION AIR PREHEATER - I  
DUTY(MW): 6.62 / 5.0

S-44101  
COMBUSTION AIR  
SILENCER

E-44122A/B  
COMBUSTION AIR PREHEATER - II  
DUTY(MW): 10.37 / 6.85

- NOTES:**
- PROCESS SIDE TEMPERATURE IS CONTROLLED, WITH CHANGES IN FLUE GAS TEMPERATURE USED TO INITIATE NATURAL GAS FLOW CHANGES TO MINIMIZE DEVIATIONS IN THE PROCESS TEMPERATURE.
  - FLOWS AND DUTIES: CHECK CASE V REV 2 / CASE #21.  
CHECK CASE V REV 2: CHEMICAL FEED + NG @105°C, HC PSA TAILGAS MAKE-UP FUEL, STEAM EXPORT OF ~160+/h.  
CASE #21: FLUE GAS RECYCLE ONLINE AT 100%
  - DELETED.
  - DELETED.
  - DELETED.
  - TEMPERED WATER SYSTEM IS SHOWN ON UFD DWG. # 440.0001.000.040.012.
  - FLOW CONTROL ON COMBUSTION AIR WITH TRIM FROM EXCESS O<sub>2</sub> AT BURNER OUTLET.
  - FLUE GAS RECIRCULATION FAN CONTROLLED BY TOTAL CONVECTION SECTION FLOW WITH FEEDFORWARD FROM CO<sub>2</sub> CAPTURED.

- REFERENCE**
- ◇ STREAM NUMBER
  - TEMPERATURE - CHECK CASE V REV 2 (°C)  
□ TEMPERATURE - CASE #21 (°C)
  - PRESSURE - CHECK CASE V REV 2 (kPa-a)  
○ PRESSURE - CASE #21 (kPa-a)
  - ▬ FLOW - CHECK CASE V REV 2 (kg/Hr)  
▬ FLOW - CASE #21 (kg/Hr)
  - ▬ Std. VOL. FLOW - CHECK CASE V REV 2 (m<sup>3</sup> (st)/hr)  
▬ Std. VOL. FLOW - CASE #21 (m<sup>3</sup> (st)/hr)

**ISSUED FOR CONSTRUCTION**  
21 Oct 2013

**FLUOR.** FLUOR'S RESPONSIBILITY IS LIMITED TO THE REVISION CONTENT SHOWN IN THIS DOCUMENT.

REV	ISSUED DATE	DESCRIPTION	BY	CHKD	PL	EGA	APE	PEM	CLINT APPR
4	09.30.13	RE-ISSUED IFC ON NEXT HARD REV	GB	CC	LMF				
3C	01.08.13	ISSUED FOR CONSTRUCTION	GB	KB	LMF				
3B	08.31.11	RE-ISSUED FOR QUEST DESIGN	GB	SM	SM				
3A	03.04.11	RE-ISSUED FOR QUEST DESIGN	GB	SM	BS				
3	11.03.10	ISSUED FOR QUEST DESIGN	JH	SM	BS				
2A	08.24.10	ISSUED FOR QUEST COARSE HAZOP	JH						
2	04.17.07	ISSUED FOR DESIGN	PD	HG	RCD	RCD	PG	PB	
1	06.15.06	ISSUED FOR DESIGN	RCD	HG		CJK	JT	RN	
0	10.19.05	ISSUED FOR DESIGN	RCD	GM	PAN	CJK	JT	RN	
A	09.01.05	ISSUED FOR APPROVAL	RCD	GM	PAN	CJK	JT	RN	

**SHELL CANADA ENERGY**

**BECHTEL**

JOB No: 25183-C10  
M5-IH-441003

**Uhde**


PROCESS FLOW DIAGRAM  
SCOTFORD UPGRADER EXPANSION 1  
HYDROGEN MANUFACTURING - UNIT 441  
STEAM REFORMING

SCALE: NONE  
SHELL DWG NO.: 441.0001.000.040.003  
REV. 4

BORDER NAME: HM\_AIPDF\_Shell.DWG

FILE: T:\1010\PIPING\HMU\_PFD5\441-REV-2\441.0001.000.040.003.DWG:MODEL DATE: 04-16-2007, 2:21pm BAOF



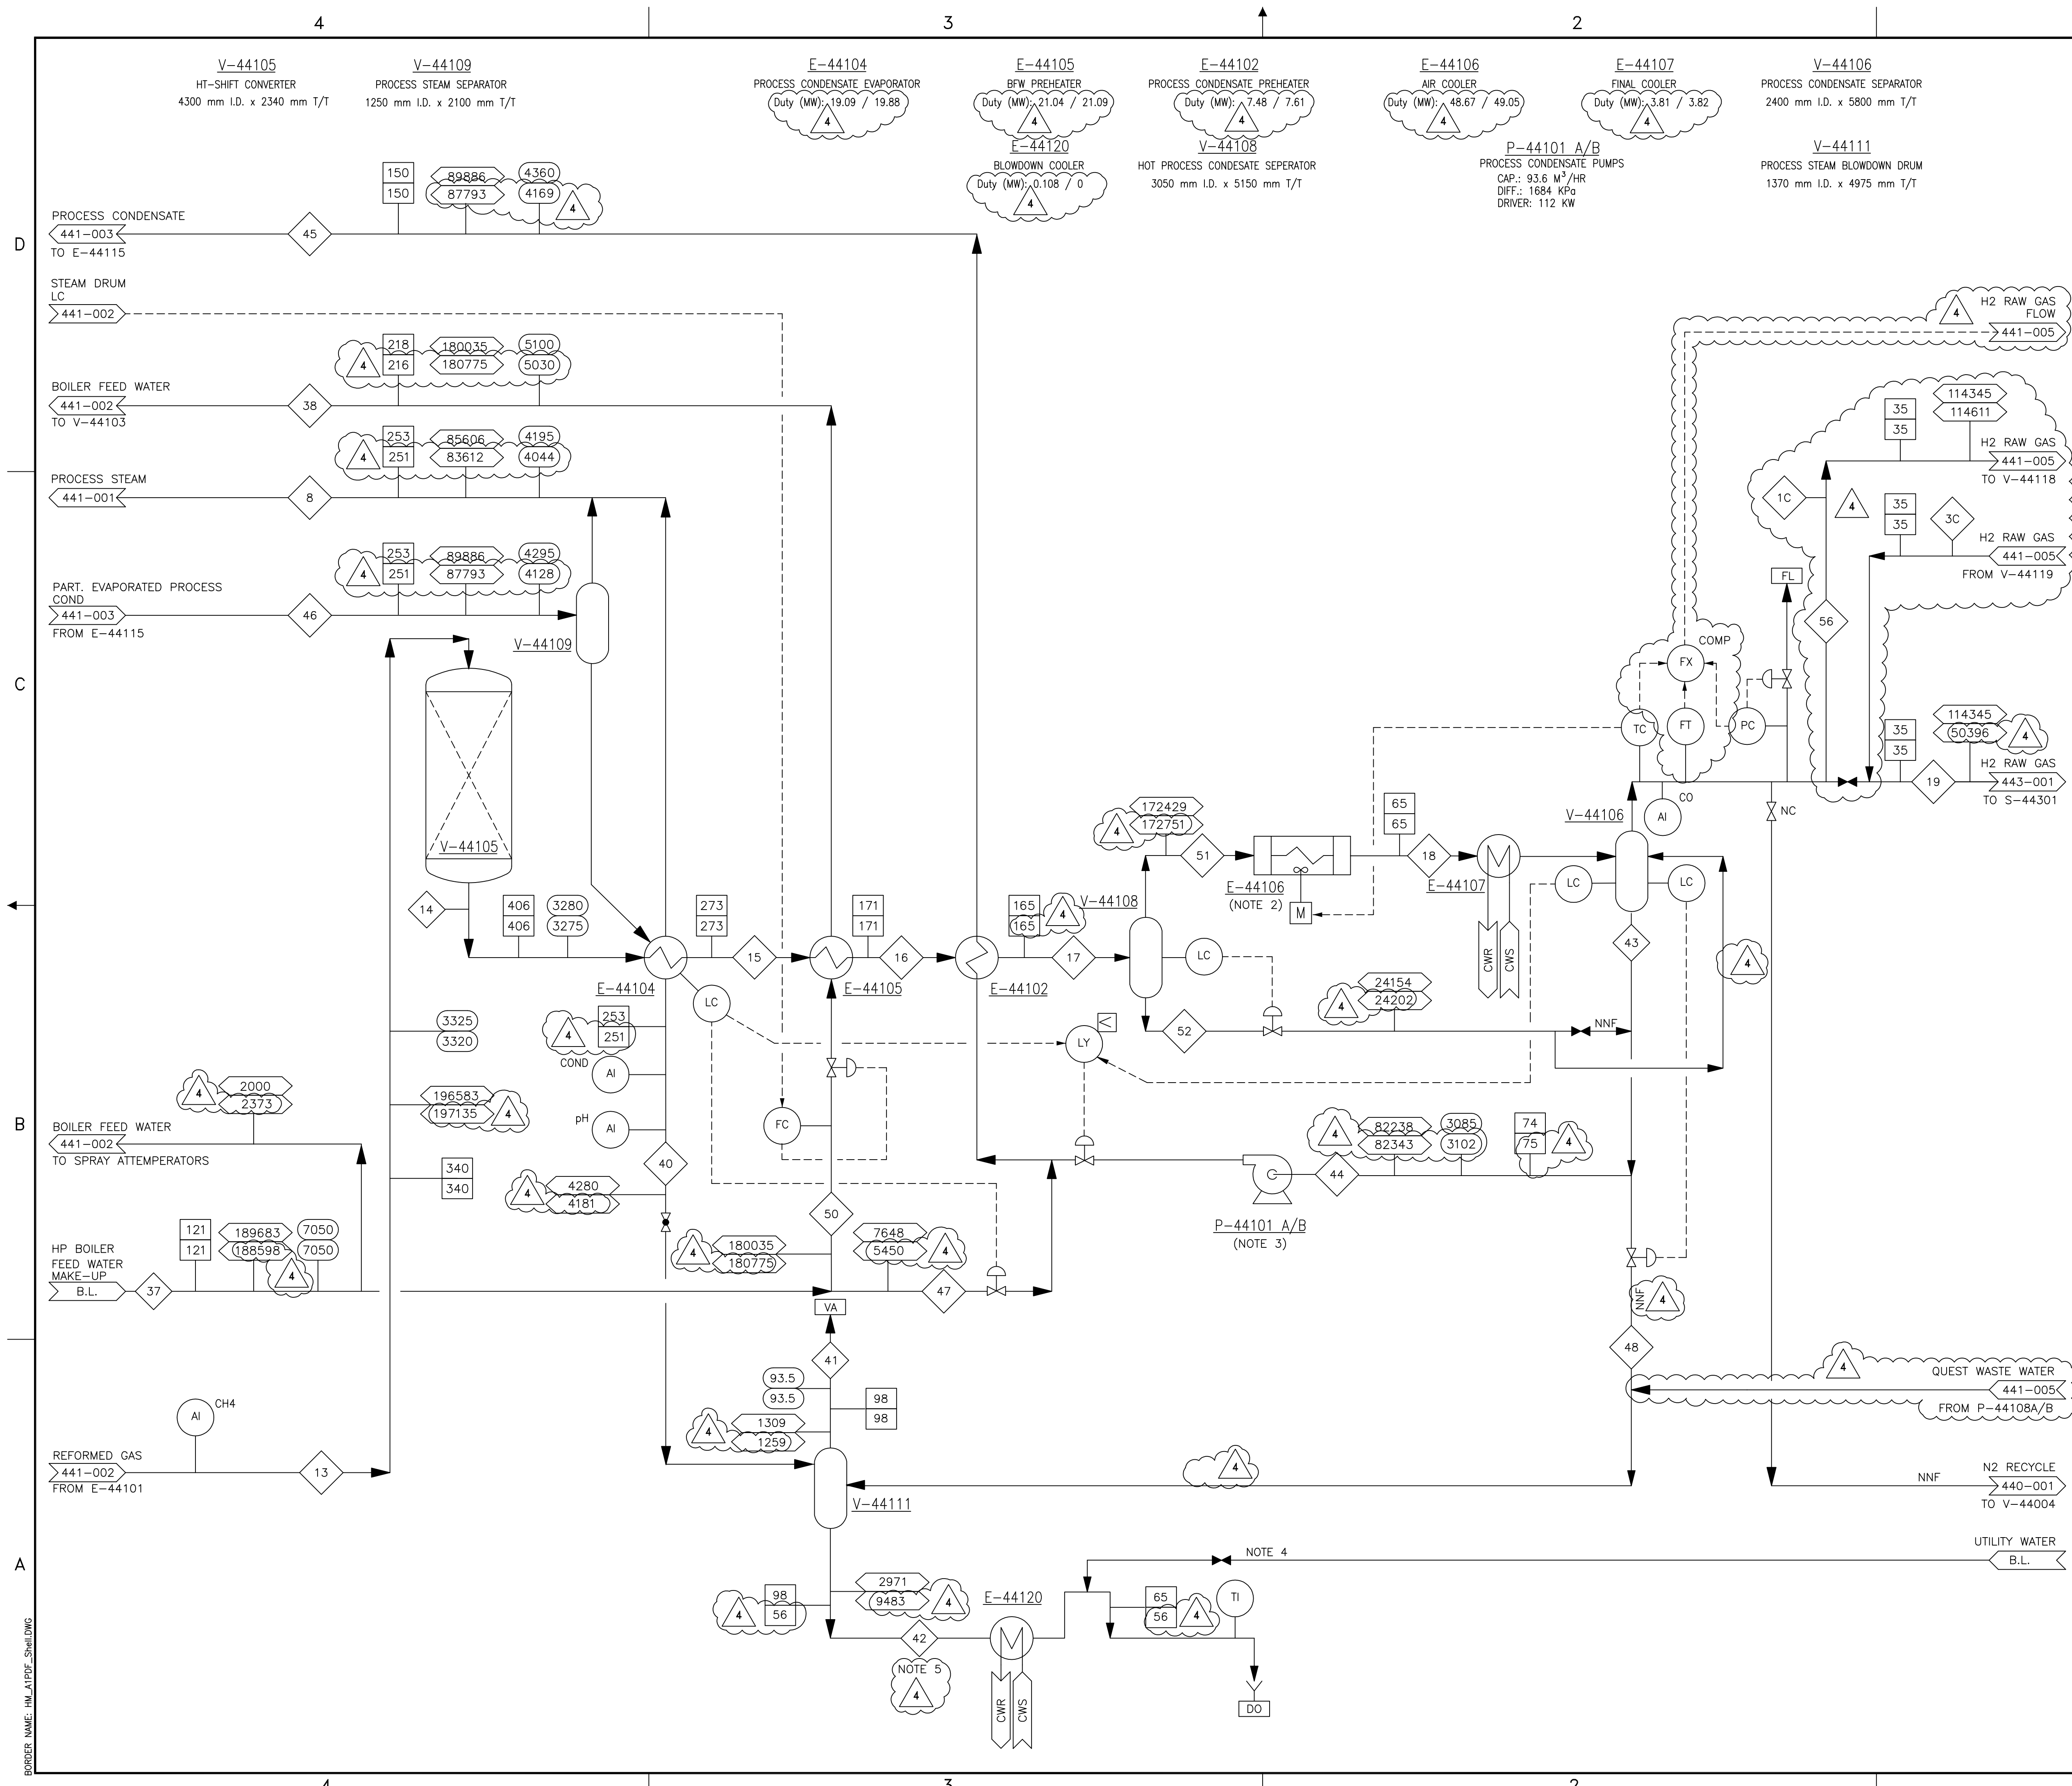

- NOTES:**
1. FLOWS AND DUTIES: CHECK CASE V REV 2 / CASE #21.  
CHECK CASE V REV 2: CHEMICAL FEED + NG @105°C, HC PSA TAILGAS MAKE-UP FUEL, STEAM EXPORT OF ~160+/h.  
CASE #21: FLUE GAS RECYCLE ONLINE AT 100% LOAD.
  2. 100% VFD; SHELL CANADA "TYPE III" WINTERIZATION
  3. START-UP NOTE: ENSURE THAT THE INTERNAL IP STEAM HEADER PRESSURE CAN BE REDUCED SUCH THAT THE PROCESS COND. STEAM RECYCLE AT NORMAL PUMP DIFFERENTIAL HEAD IS NOT OBSTRUCTED.
  4. UTILITY WATER IS NNF. UTILITY WATER IS ONLY REQUIRED DURING STARTUP WHEN 20000 kg/hr IS BLOWN DOWN FROM E-44104 AND THERE IS NO BLOWDOWN FORM V-44106.
  5. INCLUDES PURGE WATER FROM QUEST ABSORBER BLOCK.

- REFERENCE**
- ◇ STREAM NUMBER
  - TEMPERATURE - CHECK CASE V REV 2 (°C)  
□ TEMPERATURE - CASE #21 (°C)
  - PRESSURE - CHECK CASE V REV 2 (kPa-a)  
○ PRESSURE - CASE #21 (kPa-a)
  - ▭ FLOW - CHECK CASE V REV 2 (kg/Hr)  
▭ FLOW - CASE #21 (kg/Hr)
  - ▭ Std. VOL. FLOW - CHECK CASE V REV 2 (m<sup>3</sup> (st)/hr)  
▭ Std. VOL. FLOW - CASE #21 (m<sup>3</sup> (st)/hr)

**ISSUED FOR CONSTRUCTION**  
21 Oct 2013

**FLUOR.** FLUOR'S RESPONSIBILITY IS LIMITED TO THE REVISION CONTENT SHOWN IN THIS DOCUMENT.

REV	ISSUED DATE	DESCRIPTION	BY	CHKD	PL	EGA	APE	PEM	CLINT APPR
4	09.31.13	RE-ISSUED IFC ON NEXT HARD REV	GB	CC	LMF			KH	CV
3C	01.08.13	ISSUED FOR CONSTRUCTION	GB	KB	LMF			KH	CV
3B	08.31.11	RE-ISSUED FOR QUEST DESIGN	GB	SM	SM			JI	CV M0/SB
3A	01.03.11	RE-ISSUED FOR QUEST DESIGN	GB	SM	BS			JI	CV M0/SB
3	11.03.10	ISSUED FOR QUEST DESIGN	JH	SM	BS			JI	CV M0/SB
2A	08.24.10	ISSUED FOR QUEST COARSE HAZOP	JH						
2	04.17.07	ISSUED FOR DESIGN	PD	HG	RCD	RCD		PG	PB
1	06.15.06	ISSUED FOR DESIGN	RCD	HG				CJK	JT RN
0	10.19.05	ISSUED FOR DESIGN	RCD	GM	PAN			CJK	JT RN
A	09.01.05	ISSUED FOR APPROVAL	RCD	GM	PAN			CJK	JT RN

**SHELL CANADA ENERGY**

**BECHTEL**

JOB No: 25183-C10  
M5-IH-441004

**Uhde**


**PROCESS FLOW DIAGRAM**  
SCOTFORD UPGRADE EXPANSION 1  
HYDROGEN MANUFACTURING - UNIT 441  
CO-CONVERSION COOLING TRAIN

SCALE: NONE  
SHELL DWG NO.: 441.0001.000.040.004 REV. 4

BORDER NAME: HM\_A1PDF\_Shell.DWG

FILE: T:\1010\PIPING\HMU\PDFS\441-REV-2\441.0001.000.040.004.DWG:MODEL DATE: 04-23-2007, 8:38am BAOF



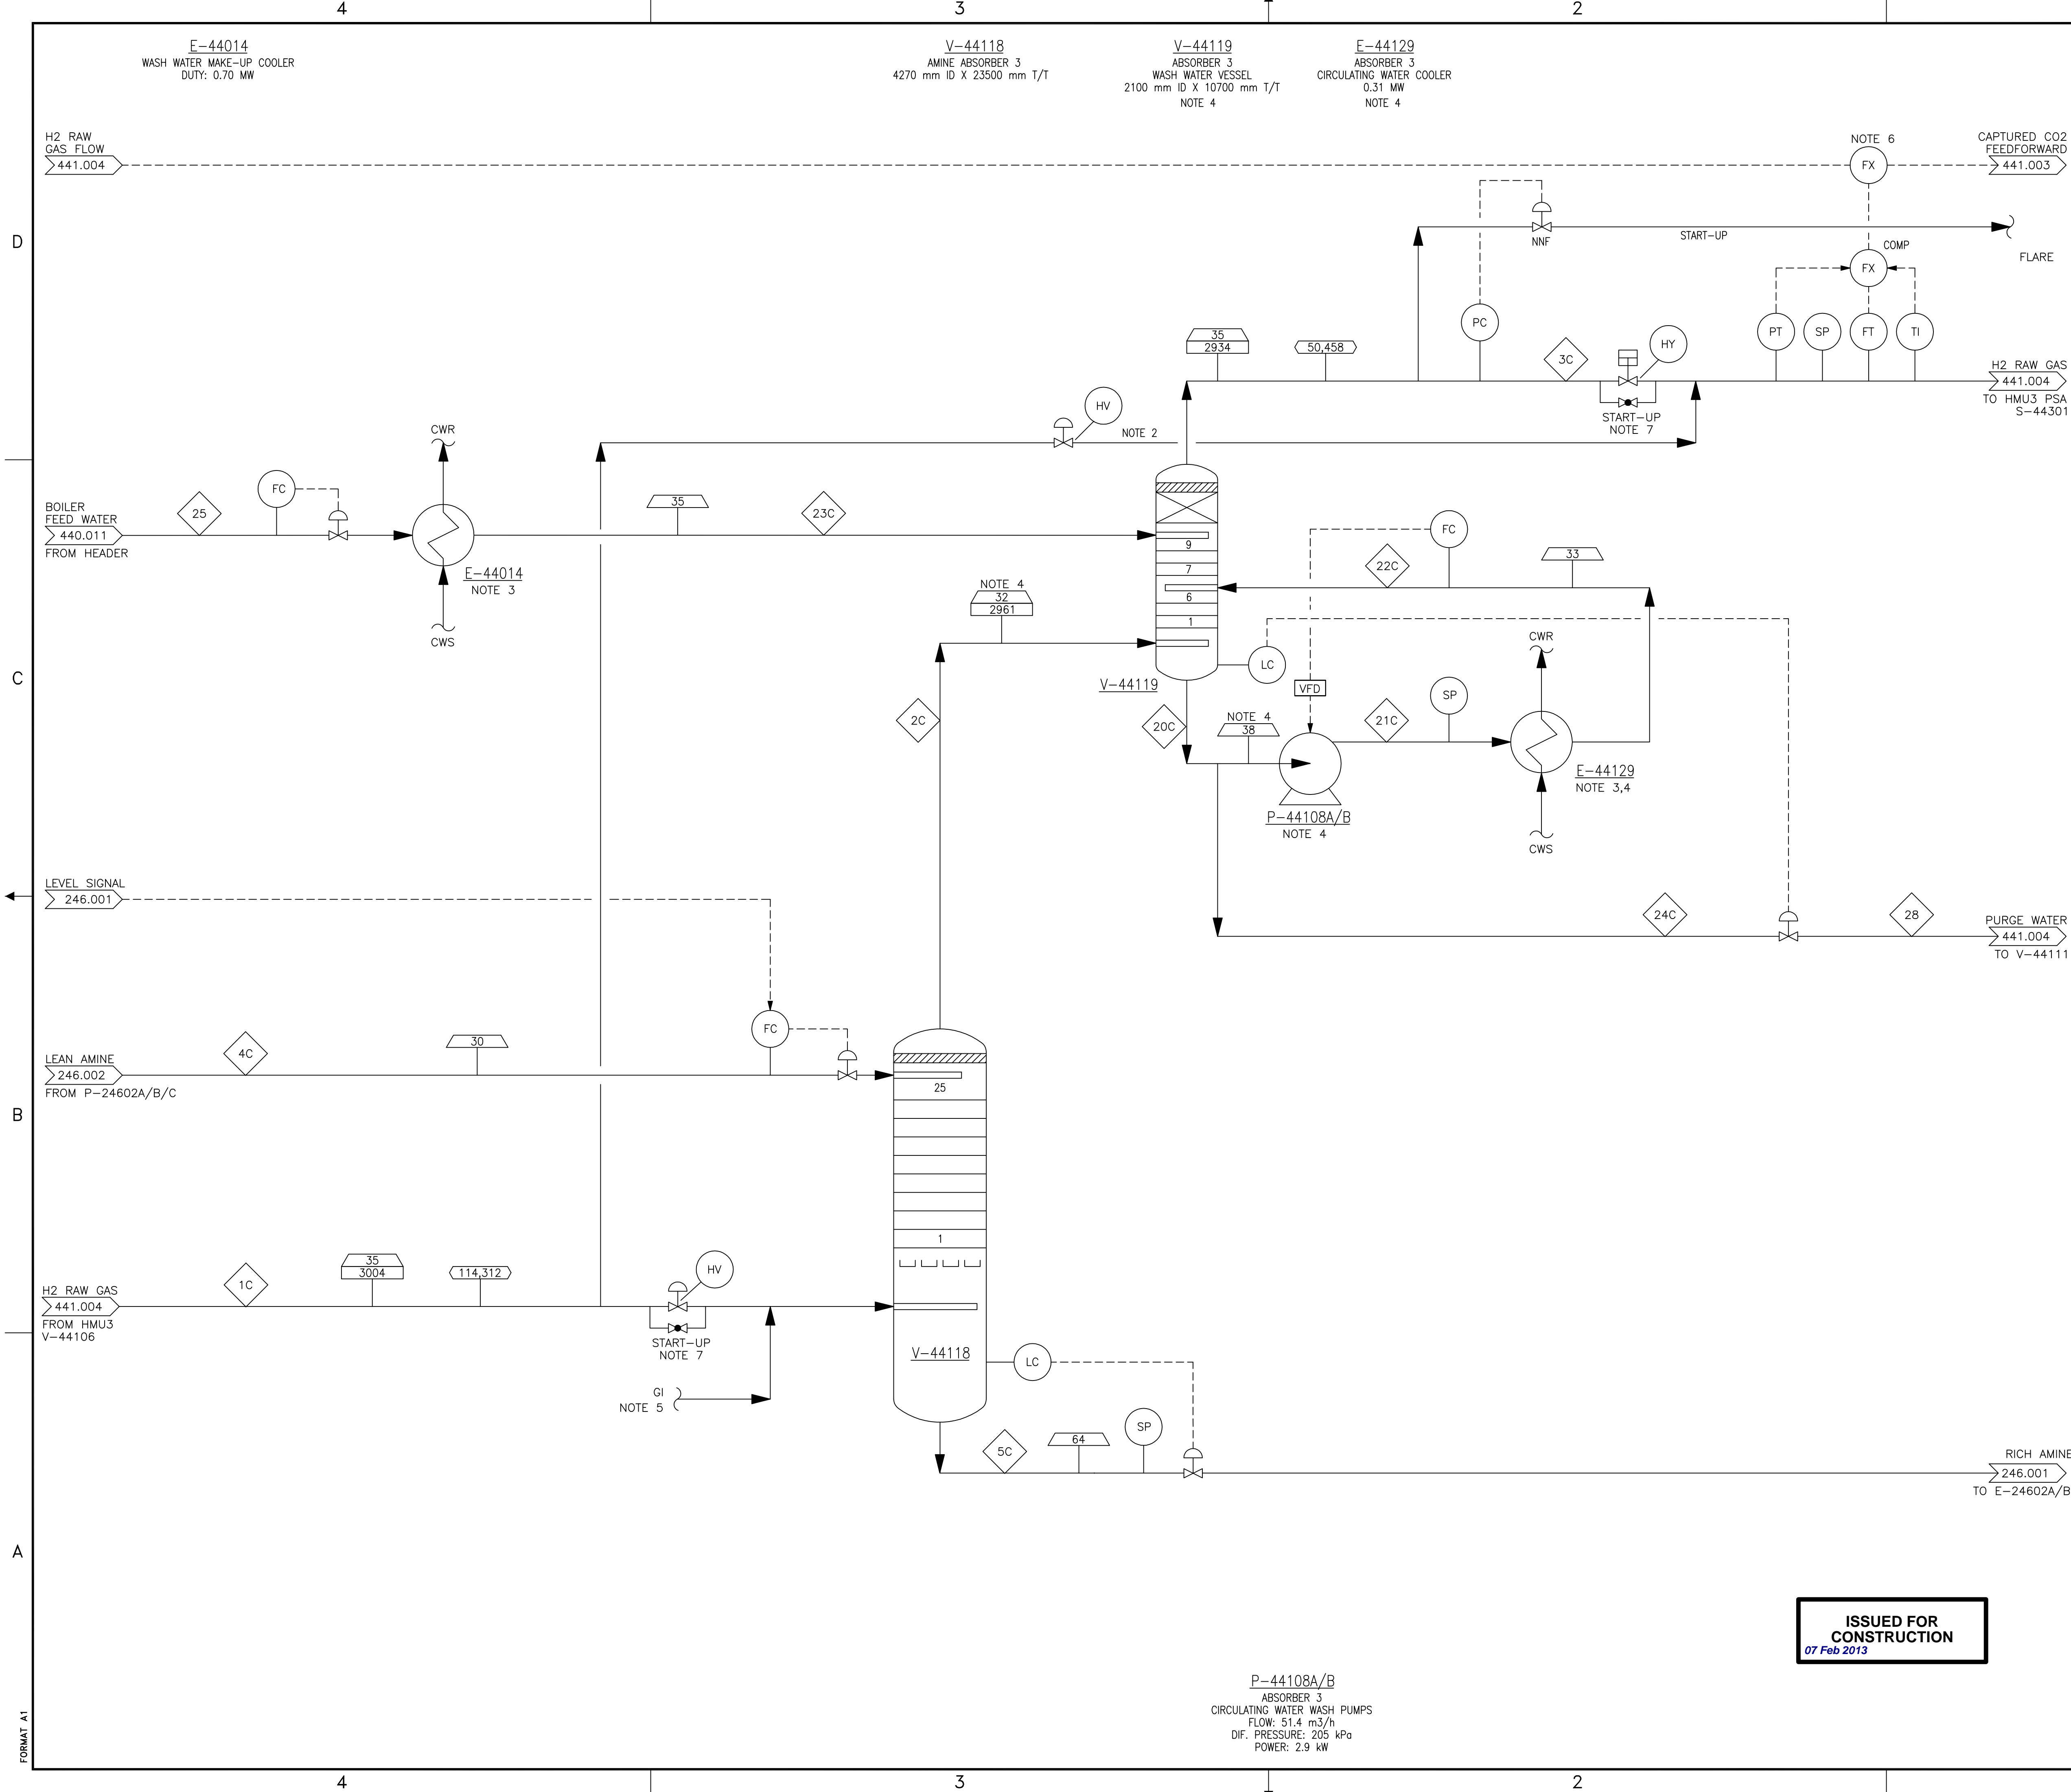

- NOTES**
1. REFER TO HEAT AND MATERIAL BALANCE, DOCUMENT NUMBER 246.0001.000.046.001, FOR STREAM INFORMATION.
  2. FEED GAS BYPASS AROUND HMU3 CO2 CAPTURE TRAIN.
  3. COOLING WATER SOURCE IS HMU3 COOLING WATER SYSTEM SOURCE TEMPERATURE IS 25°C FOR DESIGN.
  4. WATER WASH SECTION IS DESIGNED FOR A HIGHER TREATED GAS TEMPERATURE OF 39°C FROM THE AMINE ABSORBER.
  5. NITROGEN PURGE FOR START-UP.
  6. CAPTURED CO2 CALCULATED AND USED AS AN INPUT TO CONTROL THE FLUE GAS RECIRCULATION FAN (C-44105).
  7. H2 RAW GAS BYPASS FOR SYSTEM PURGE AND PRESSURIZATION AT START-UP.

- LEGEND**
- ◇ XXX STREAM NUMBER
  - ▭ XXX TEMPERATURE, °C
  - ▭ XXX PRESSURE, kPag
  - ▭ XX,XXX FLOW, kg/h

1	12/11/23	ISSUED FOR CONSTRUCTION	GB	KB	LMF	KH	CV	
OB	11/08/31	RE-ISSUED FOR DESIGN	GB	SM	KH	JL	CV	MD/SB
OA	11/03/01	RE-ISSUED FOR DESIGN	GB	SM	KH	JL	CV	MD/SB
O	10/11/08	ISSUED FOR DESIGN	JH	QC	KH	JL	CV	MD/SB
REV	ISSUED DATE	DESCRIPTION	DWN	CHKD	ENG	APP	APP	CLNT APP

RICH AMINE  
246.001  
TO E-24602A/B

**SHELL CANADA**

**FLUOR**


PROCESS FLOW DIAGRAM  
QUEST CCS PROJECT  
HMU3 AMINE ABSORBER

**ISSUED FOR CONSTRUCTION**  
07 Feb 2013

P-44108A/B  
ABSORBER 3  
CIRCULATING WATER WASH PUMPS  
FLOW: 51.4 m<sup>3</sup>/h  
DIF. PRESSURE: 205 kPa  
POWER: 2.9 kW

SCALE: NONE	TOE DWG. No.:	
SHELL DWG NO.:	441.0001.000.040.005	REV. 1

FORMAT A1

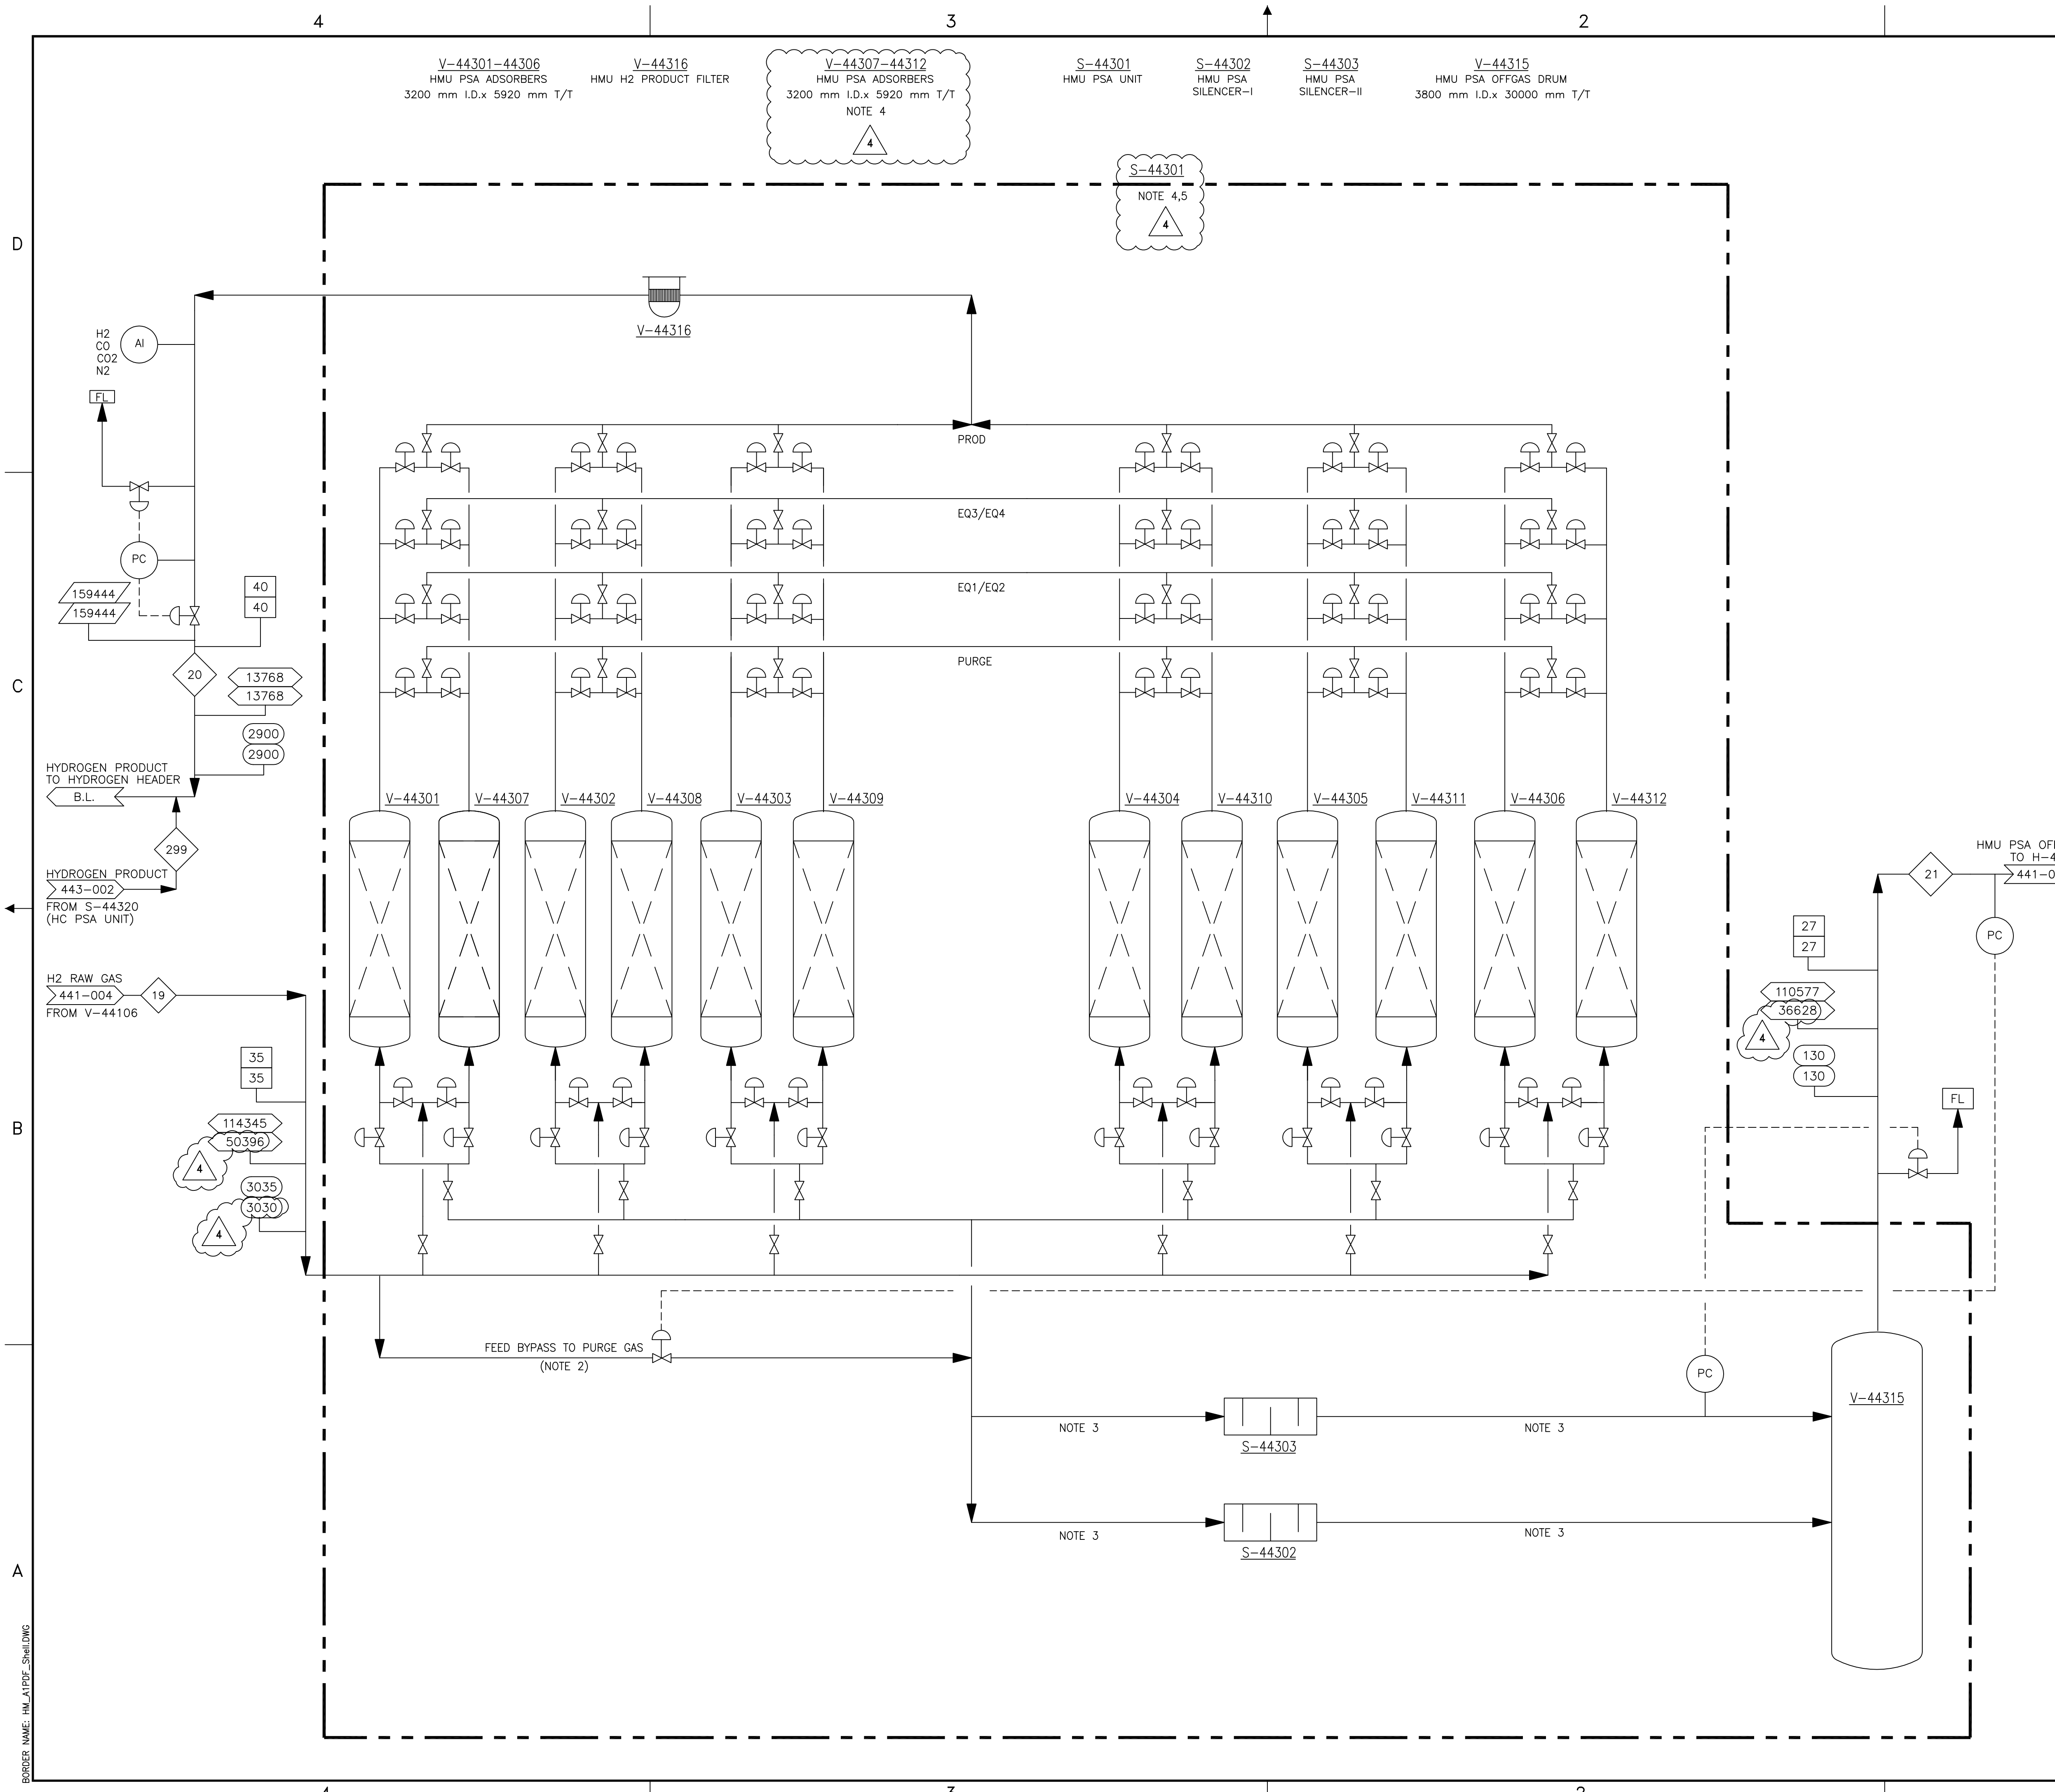

- NOTES:**
- DELETED.
  - PSA BYPASS LINE TO BE SIZED FOR 30% OF INLET FLOW.
  - PIPING FROM HMU PSA ADSORBERS OFFGAS HEADER TO HMU PSA SILENCER I & II AND FROM HMU PSA SILENCERS I & II TO HMU PSA OFFGAS DRUM WILL BE PROVIDED BY BECTHEL.
  - MODIFICATIONS TO THE PSA UNIT TO BE DESIGNED BY UOP.
  - LOGIC CHANGES FOR SWITCHING BETWEEN RICH AND LEAN CO2 CASES TO BE DETERMINED.
  - FLOWS AND DUTIES: CHECK CASE V REV 2 / CASE #21.
- CHECK CASE V REV 2: CHEMICAL FEED + NG @105°C, HC PSA TAILGAS MAKE-UP FUEL, STEAM EXPORT OF ~160+/h.
- CASE #21: FLUE GAS RECYCLE ONLINE AT 100%. 4

**REFERENCE**

- 4 STREAM NUMBER
- 4 TEMPERATURE - CHECK CASE V REV 2 (°C)  
TEMPERATURE - CASE #21 (°C)
- 4 PRESSURE - CHECK CASE V REV 2 (kPa-a)  
PRESSURE - CASE #21 (kPa-a)
- 4 FLOW - CHECK CASE V REV 2 (kg/Hr)  
FLOW - CASE #21 (kg/Hr)
- 4 Std. VOL. FLOW - CHECK CASE V REV 2 (m<sup>3</sup> (st)/hr)  
Std. VOL. FLOW - CASE #21 (m<sup>3</sup> (st)/hr)

**ISSUED FOR CONSTRUCTION**  
21 Oct 2013

**FLUOR.** FLUOR'S RESPONSIBILITY IS LIMITED TO THE REVISION CONTENT SHOWN IN THIS DOCUMENT.

REV	ISSUED DATE	DESCRIPTION	BY	CHKD	PL	EGA	APE	PEM	CLINT APPR
4	09.30.13	RE-ISSUED IFC ON NEXT HARD REV	GB	CC	LMF		KH	CV	
3C	01.08.13	ISSUED FOR CONSTRUCTION	GB	KB			KH	CV	
3B	08.31.11	RE-ISSUED FOR QUEST DESIGN	GB	SM	SM		JL	CV	M/SB
3A	03.04.11	RE-ISSUED FOR QUEST DESIGN	GB	SM	BS		JL	CV	M/SB
3	11.03.10	ISSUED FOR QUEST DESIGN	JH	SM	BS		JL	CV	M/SB
2A	08.24.10	ISSUED FOR QUEST COARSE HAZOP	JH						
2	04.25.07	ISSUED FOR DESIGN	PD	HG	RCD	RCD	PG	PB	
1	06.15.06	ISSUED FOR DESIGN	RCD	HG		CJK	JT	RN	
0	10.19.05	ISSUED FOR DESIGN	RCD	GM	PAN	CJK	JT	RN	
A	09.01.05	ISSUED FOR APPROVAL	RCD	GM	PAN	CJK	JT	RN	

**SHELL CANADA ENERGY**

**BECHTEL**

JOB No: 25183-C10  
M5-IH-443001

**Uhde**

**PROCESS FLOW DIAGRAM**  
**SCOTFORD UPGRADE EXPANSION 1**  
**HYDROGEN MANUFACTURING - UNIT 443**  
**HMU - H2 PURIFICATION**

SCALE: NONE  
SHELL DWG NO.: 443.0001.000.040.001 REV. 4

BORDER NAME: HM\_A1PDF\_Shell.DWG

FILE: T:\1010\PIPING\HMU\HMU\_PFD5\443-REV-2\443.0001.000.040.001.DWG; MODEL DATE: 04-25-2007, 1:06pm BAOF